

# MIDSHIP SECTION IRON SAILING VESSEL N<sup>o</sup>. 292

*Barque "Abercorn"*  
*Glasgow Report*  
*dist 288 N<sup>o</sup> 6946*

*To Class 100 A.1. at Lloyds.*

## Dimensions


Length as per Rule	230.
Half moulded Breadth	17.9
Depth from top of keel	23.2
Half midship Girth	36.55

## Numerals.

17.9 + 23.2 + 36.55	= 77.65	Stuartship
Do + Do + Do x 230	= 17859.5	Longitudinal
Do + Do + Do x Do + 15	= 19050.13	Outfit

## Proportions.

230. ÷ 35.8	= 6.42	Moulded Breadths.
Do ÷ 23.2	= 9.91	Depths from top of keel.

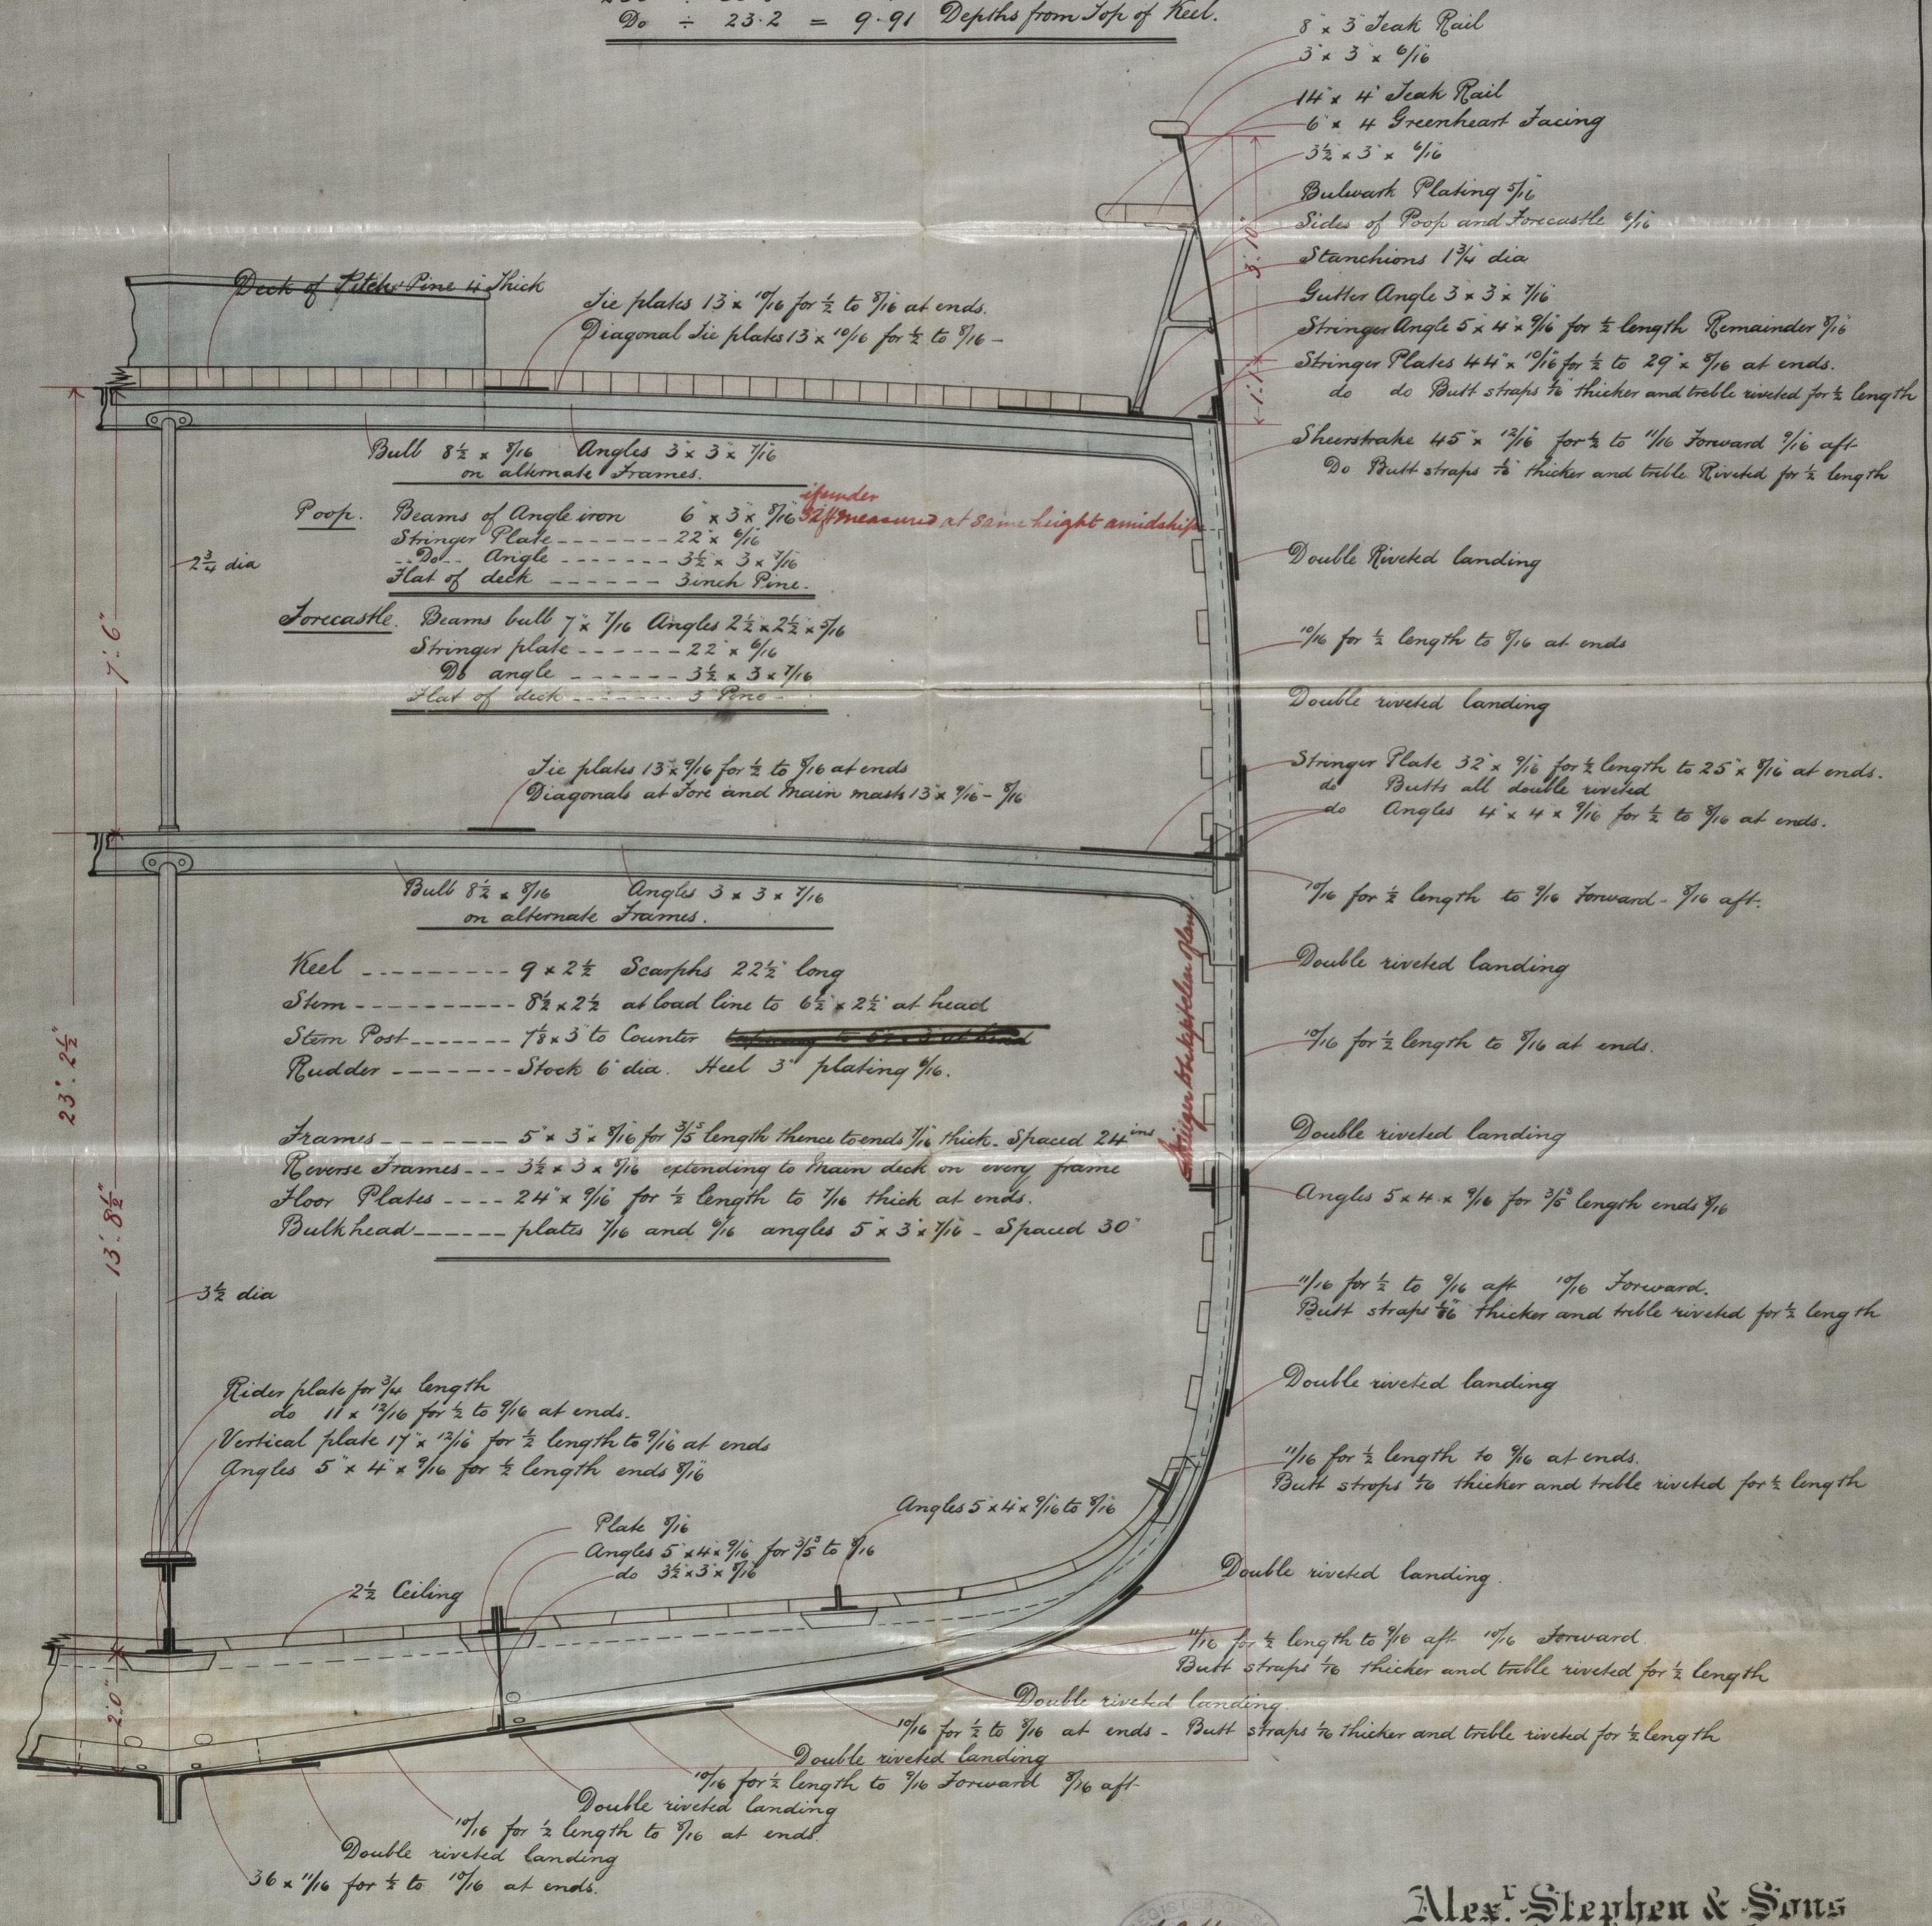

DRAWING N<sup>o</sup>. 3350 1/8/84 *W.M.*

SCALE 1/2" INCH TO A FOOT

J. G. Smith  
7/8/84

**Alex. Stephen & Sons**  
SHIPBUILDERS & ENGINEERS  
**GLASGOW**

Lloyd's Register  
Foundation  
GL5202-0109