


Barque Abercorn Glasgow Report N° 6946.

IRON SAILING VESSEL N° 292



DRAWING N° 3351  
 SCALE  $\frac{1}{8}$  INCH TO A FOOT  
 7/8/84  
 MALL

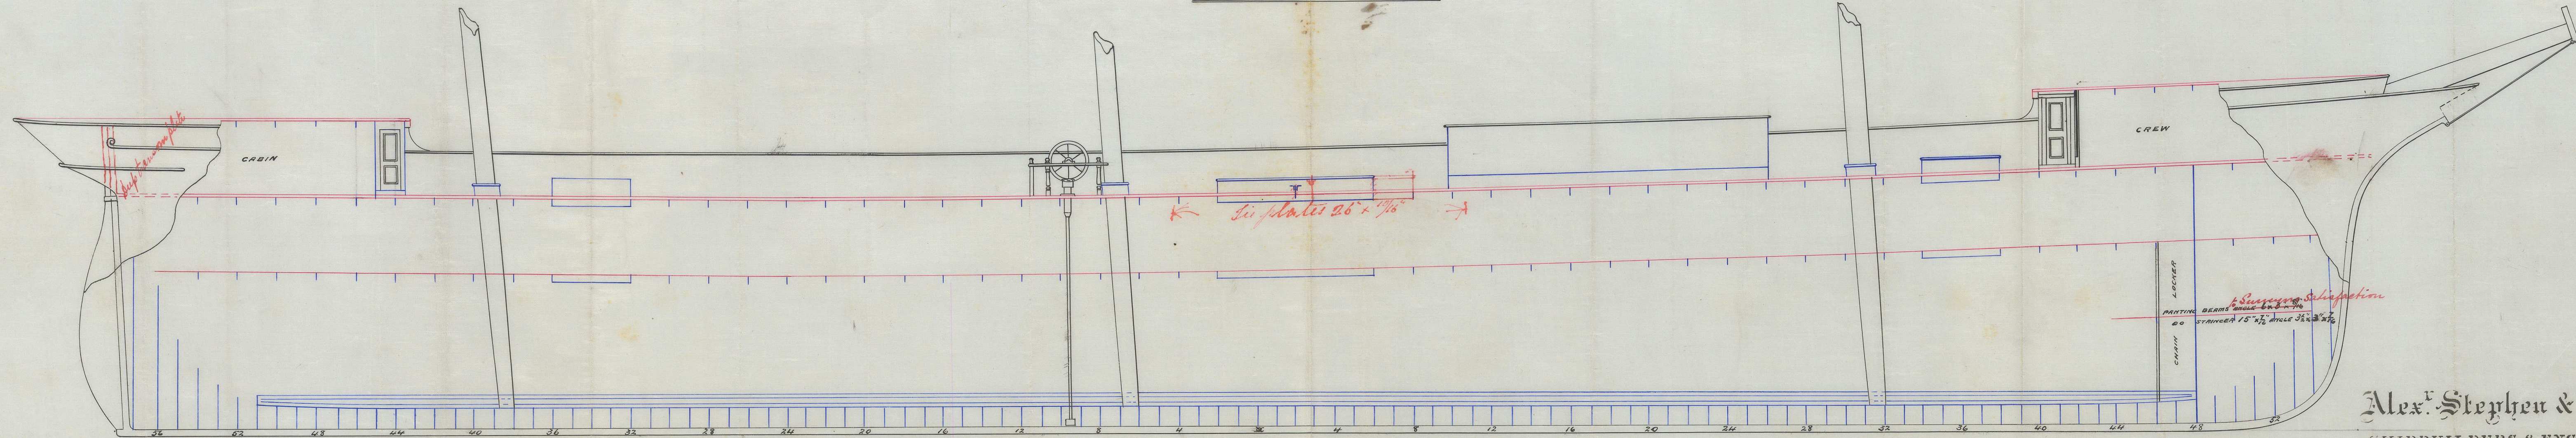

Alex. Stephen & Sons  
 SHIPBUILDERS & ENGINEERS

GLASGOW

