

S.S. Pearl Glasgow Report No. 4099



Section Through Boiler Space P.P. No. 68

Scale $\frac{1}{2}$ Inch = 1 Foot.

Dist. Gls:

13.12.84.

13.2.85.

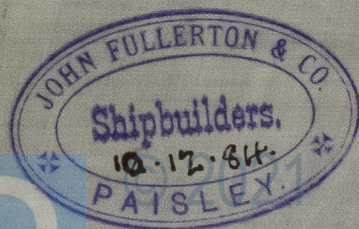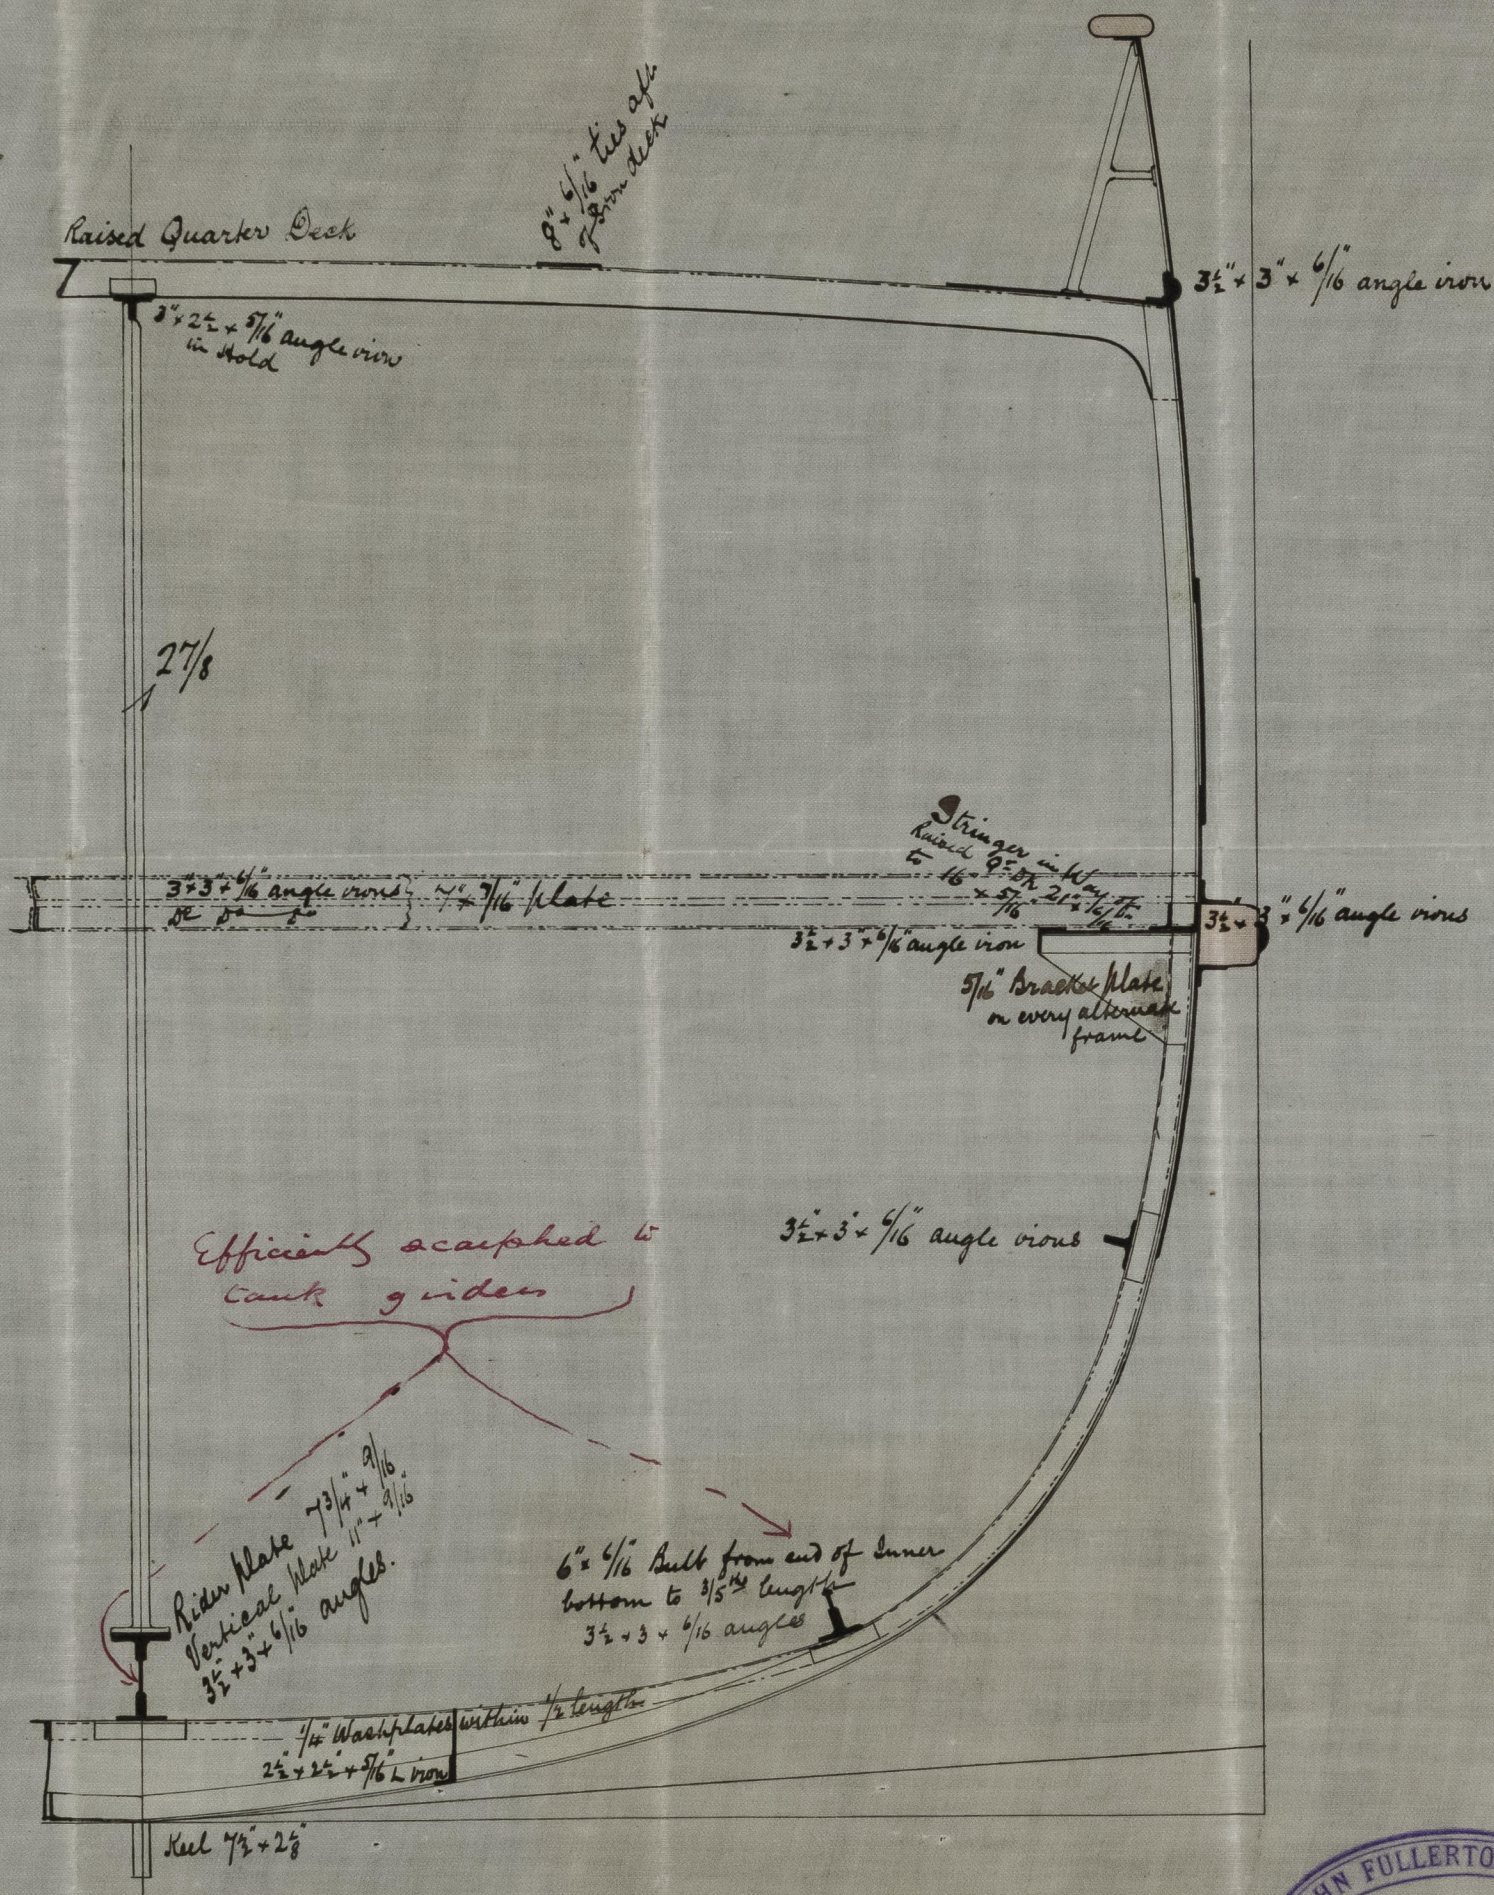

J.F.
13/2/84



Lloyd's Register Foundation

GLS203-0081