

# S. S. "Dunrobin"

Glasgow Report  
No 4814

Midship Section No 59 S. S.

Scale  $\frac{1}{2}$ " = one Foot


Closed 100 A. 1.

11.485.

Raised Quarter Deck 2' 9" high.

Topgallant Forecastle 5' 9" high.

Iron Decks.

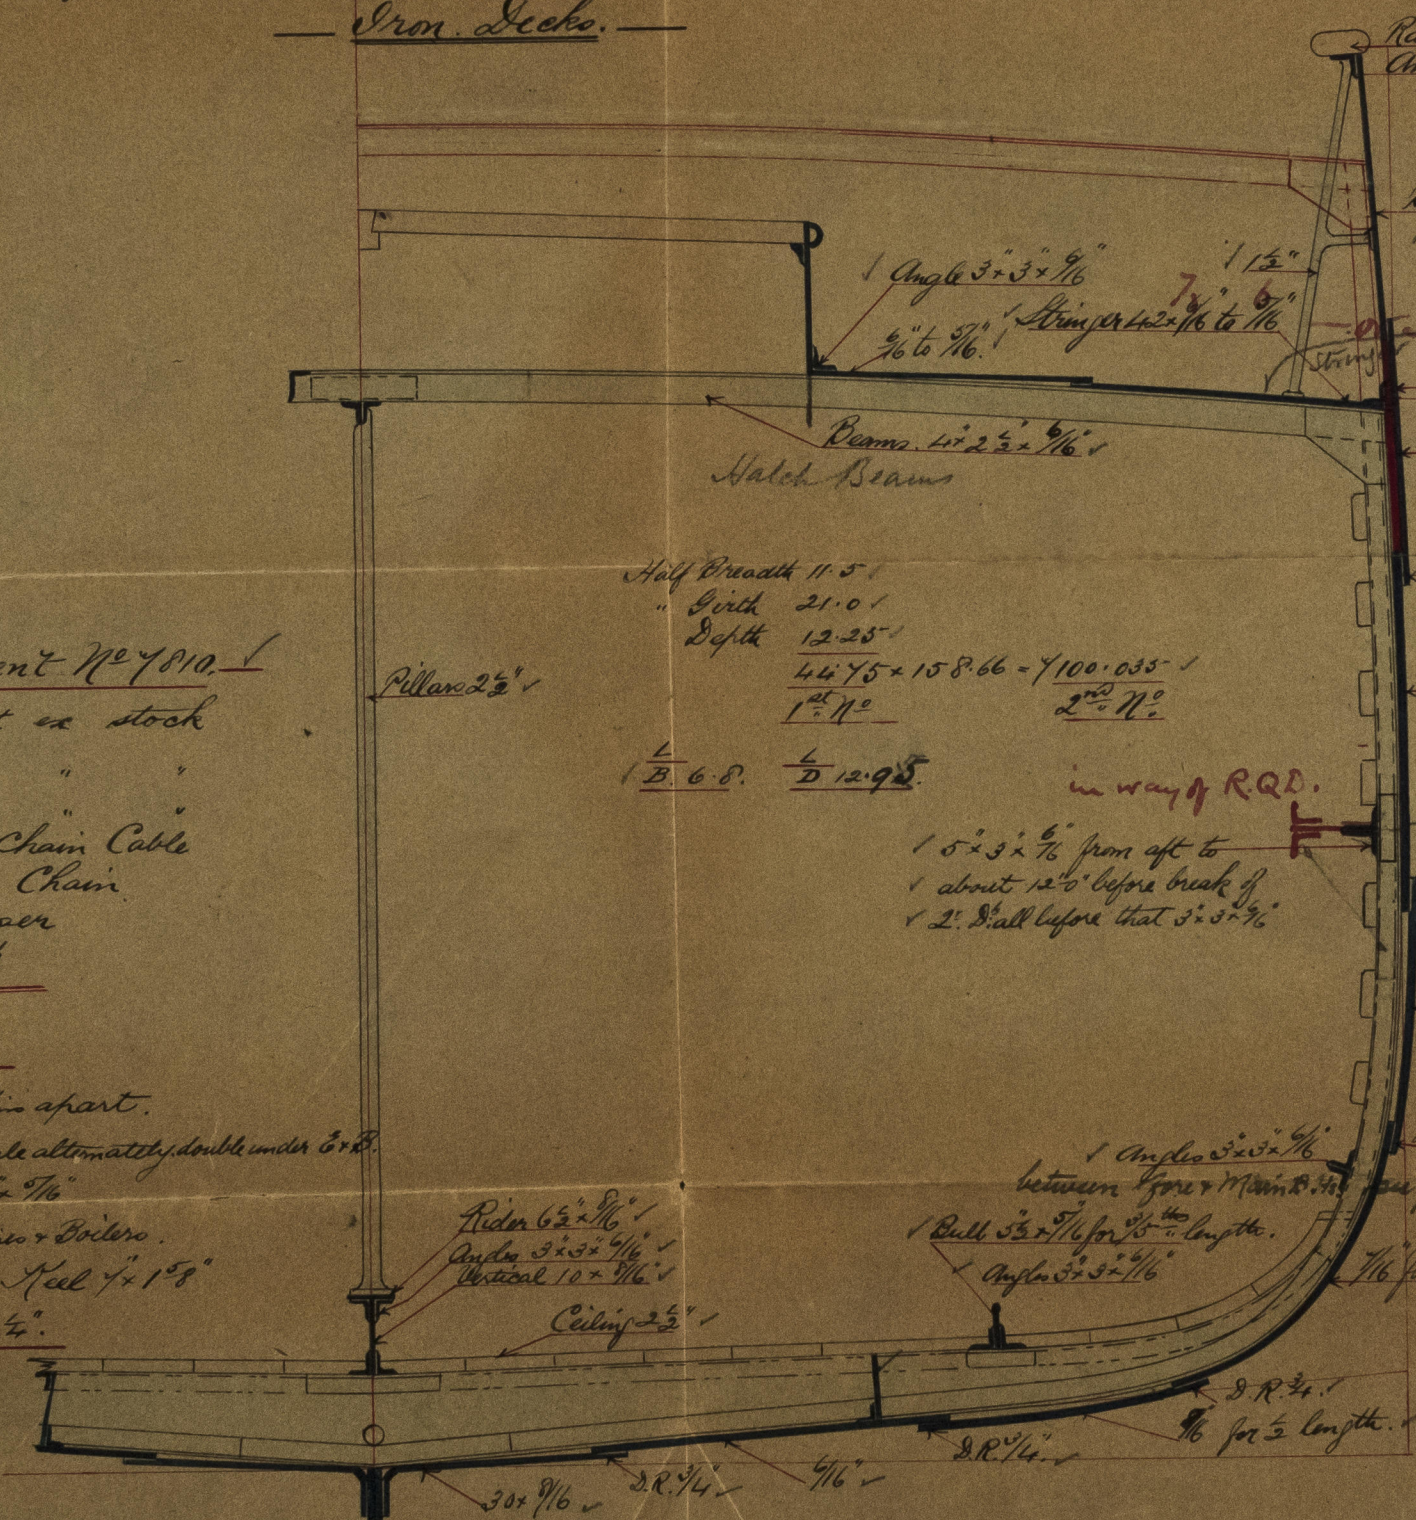

## Equipment No 7010.

- 3 Bower Anchors 8 1/2 cwt ea stock
- 1 Stream " 2 1/2 " "
- 1 Kedge " 1 1/4 " "
- 165 Fathoms 1/16" Stud Chain Cable
- 60 " 1/16" Stream Chain
- 75 " 1/16" Hawser
- 90 " 5/16" Warp

## Scantlings

- Frames 3" x 3" x 1/16" spaced 24" apart.
- Res " 2 1/2" x 1/2" to Bilge + Amovale alternately double under C. & B.
- Bulkheads 1/4" Stiffeners 3" x 2 1/2" x 1/16"
- Floors 12 1/2" x 1/16" 7/16" under Engines + Boilers.
- Stem 7" x 1 1/8". Stern post 7" x 3". Keel 7" x 1 1/8"
- Rudder stock head 3 1/2", heel 2 1/4".

Half Breadth 11.5  
" Birth 21.0  
Depth 12.25  
 $44.45 \times 158.66 = 7100.035$   
 $1^{st} 11^{\circ}$   $2^{nd} 11^{\circ}$

$\frac{L}{B} 6.8$   $\frac{L}{D} 12.95$

in way of R.Q.D.

- 5" x 3" x 1/16" from aft to
- about 12' 8" before break of
- 2" dia before that 3" x 3" x 1/16"

Rail 9" x 3" Elm  
Angle 3" x 2 1/2" x 1/16"

Bulwarks 1/4"

1/16" raised Quarter Deck plating

2 1/2" x 1/16" x 1/16"

Shar strakes 5" x 1/16" increased 2/16 see profile.

Doubling 1/16"

On line of main deck about 1/2 Quarter deck two angles 5" x 3" x 1/16" to after end

D.R. 3/4"

1/16"

Note. Buttstraps of sheerstrake upper deck stringers + one strake at bilge 1/16" thicker than plates they connect for 1/2 length. Buttstraps of stringer plate. sheerstrake + strake alone + see profile below sheer treble rivetted in way of break.

SCOTT & CO  
Shipbuilders  
LLOYD'S REGISTER  
Foundation

GLS203-0123