


Ltr to Glas:  
16/4/85

Scott & Co No 59.  
**MARINE BOILER No 88**


S. S. "Dunrobin"  
Glasgow Report No. 4114

SCALE 1" = 1' 0"

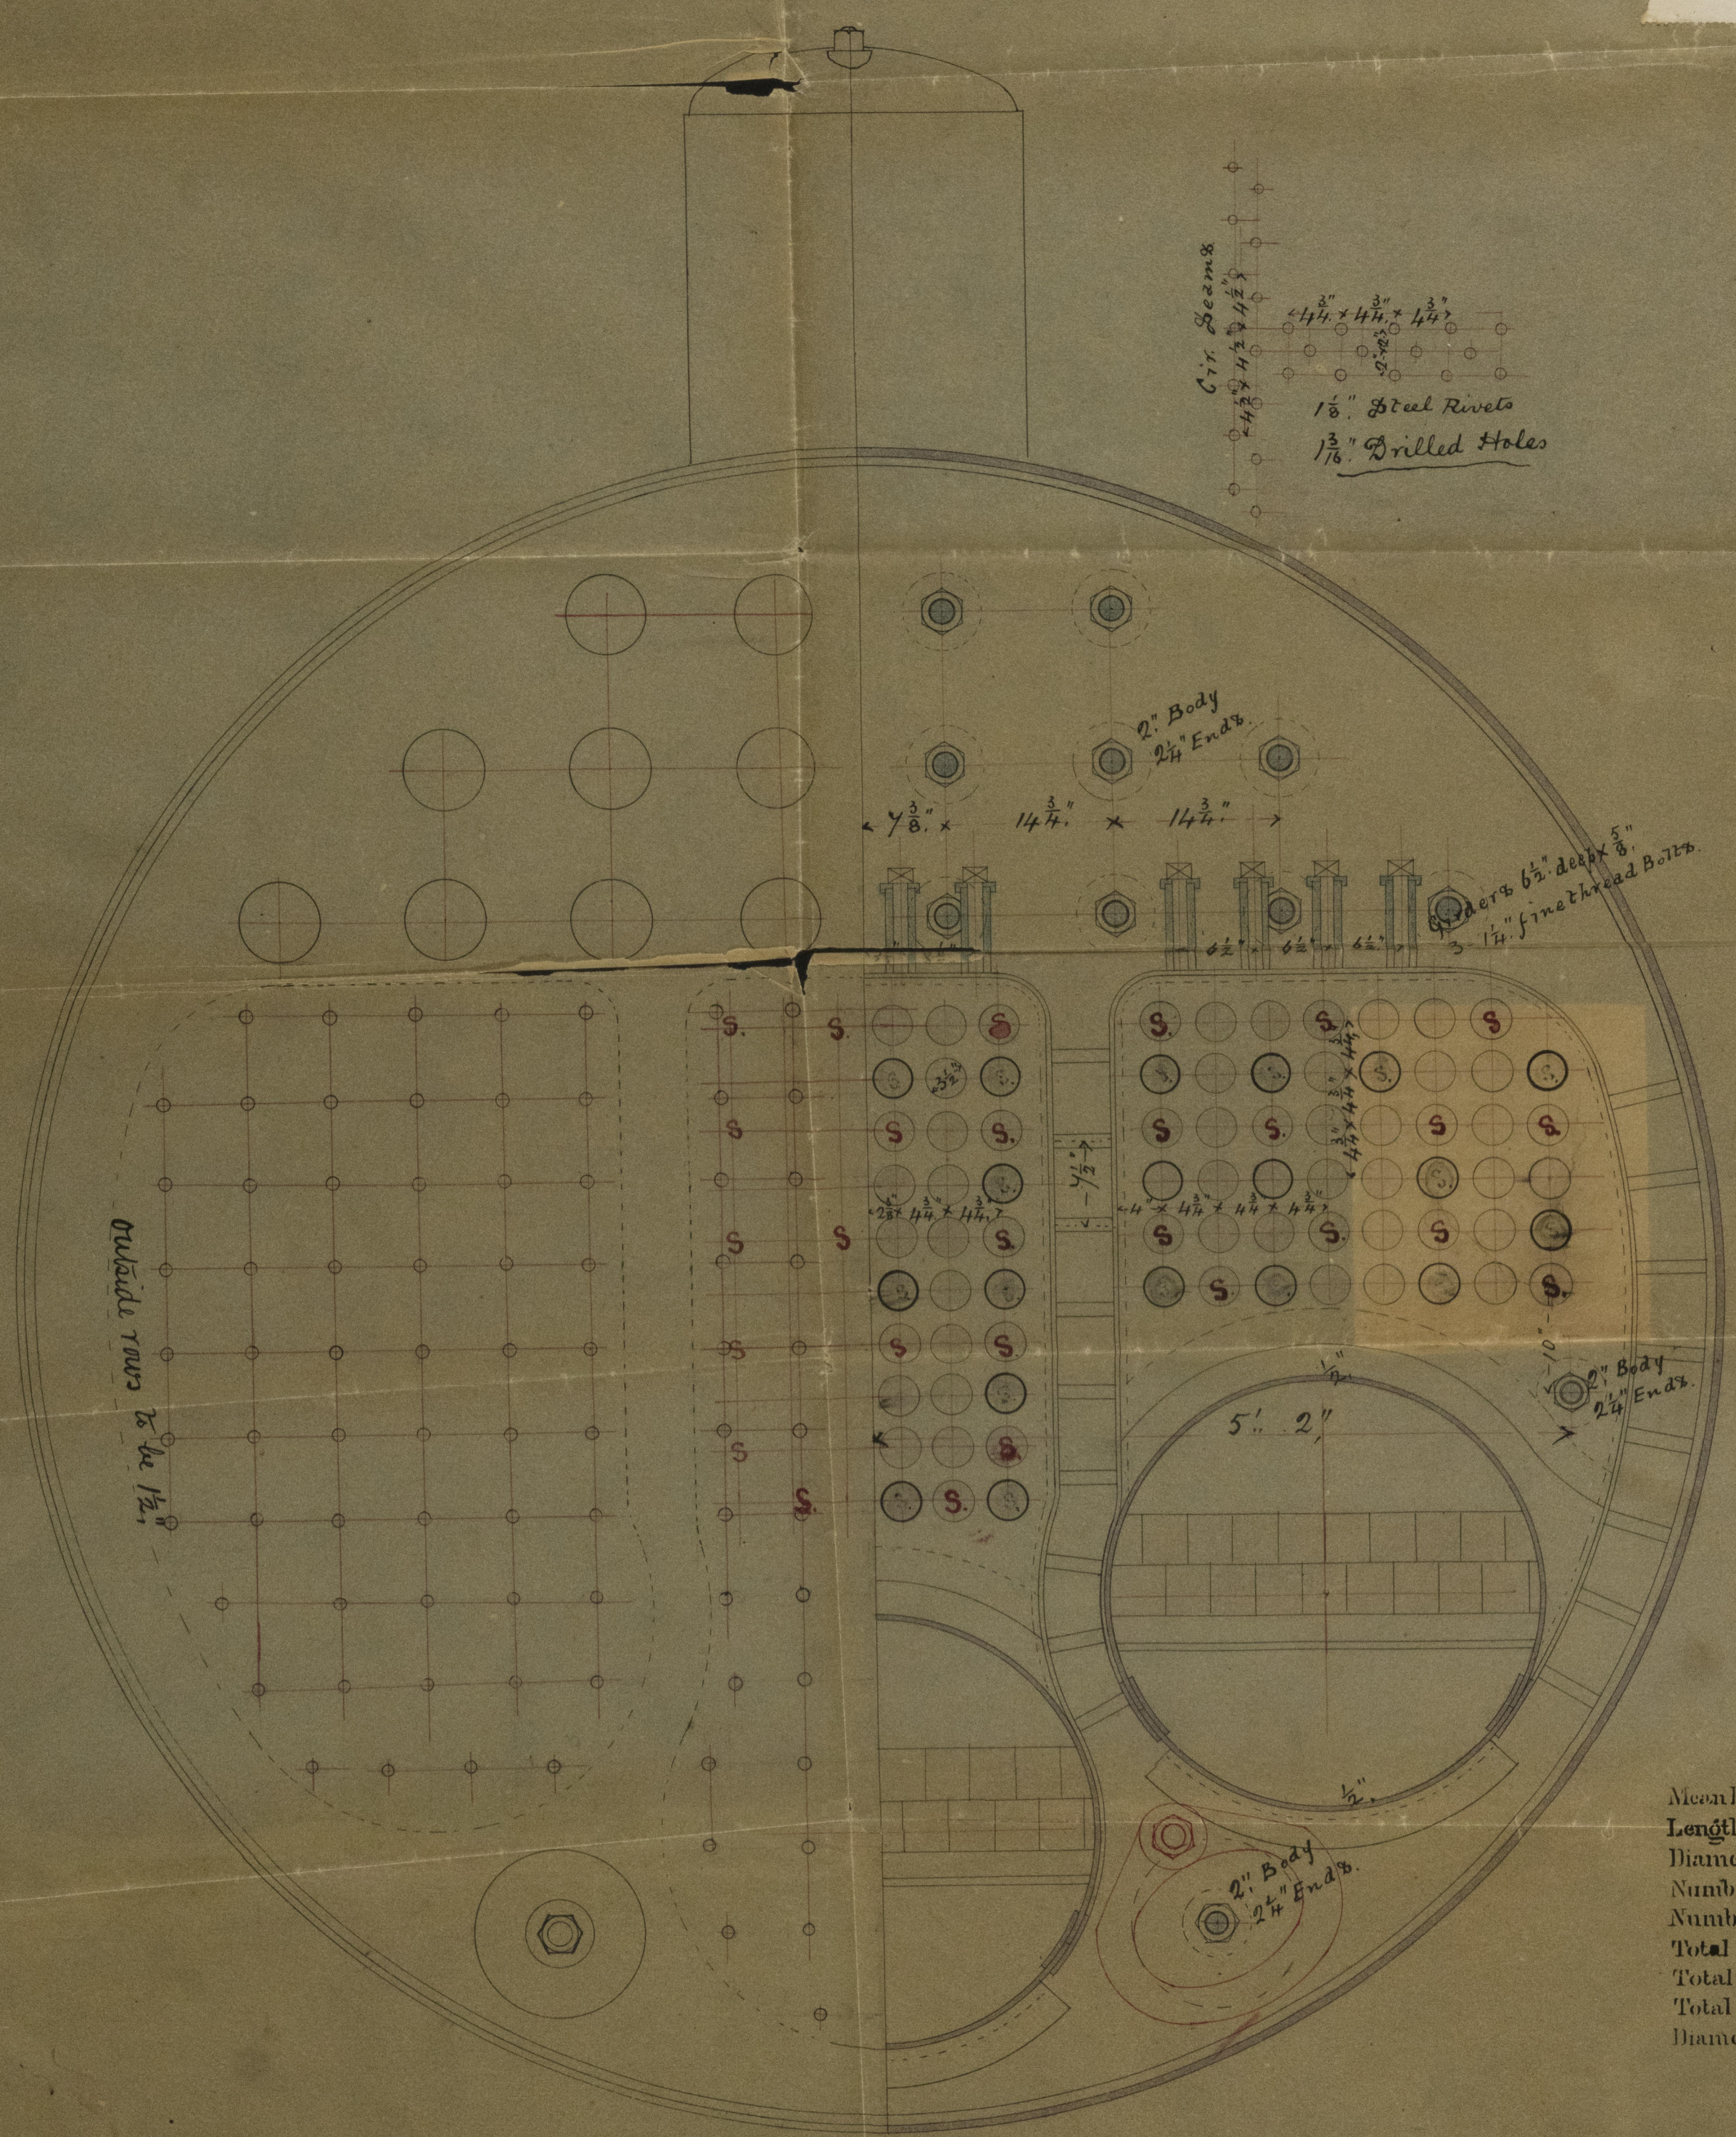


**DIMENSIONS**

Mean Diameter of Boiler	12' 6"
Length of Boiler	10' 0"
Diameter of Furnaces	3' 2" (inside)
Number of Plain Tubes	14116
Number of Stay Tubes	340
Total Number of Tubes	156
Total Heating Surface	—
Total Firegrate Area	50 sq ft
Diameter of Funnel	4' 0"
Working Pressure	90 lbs

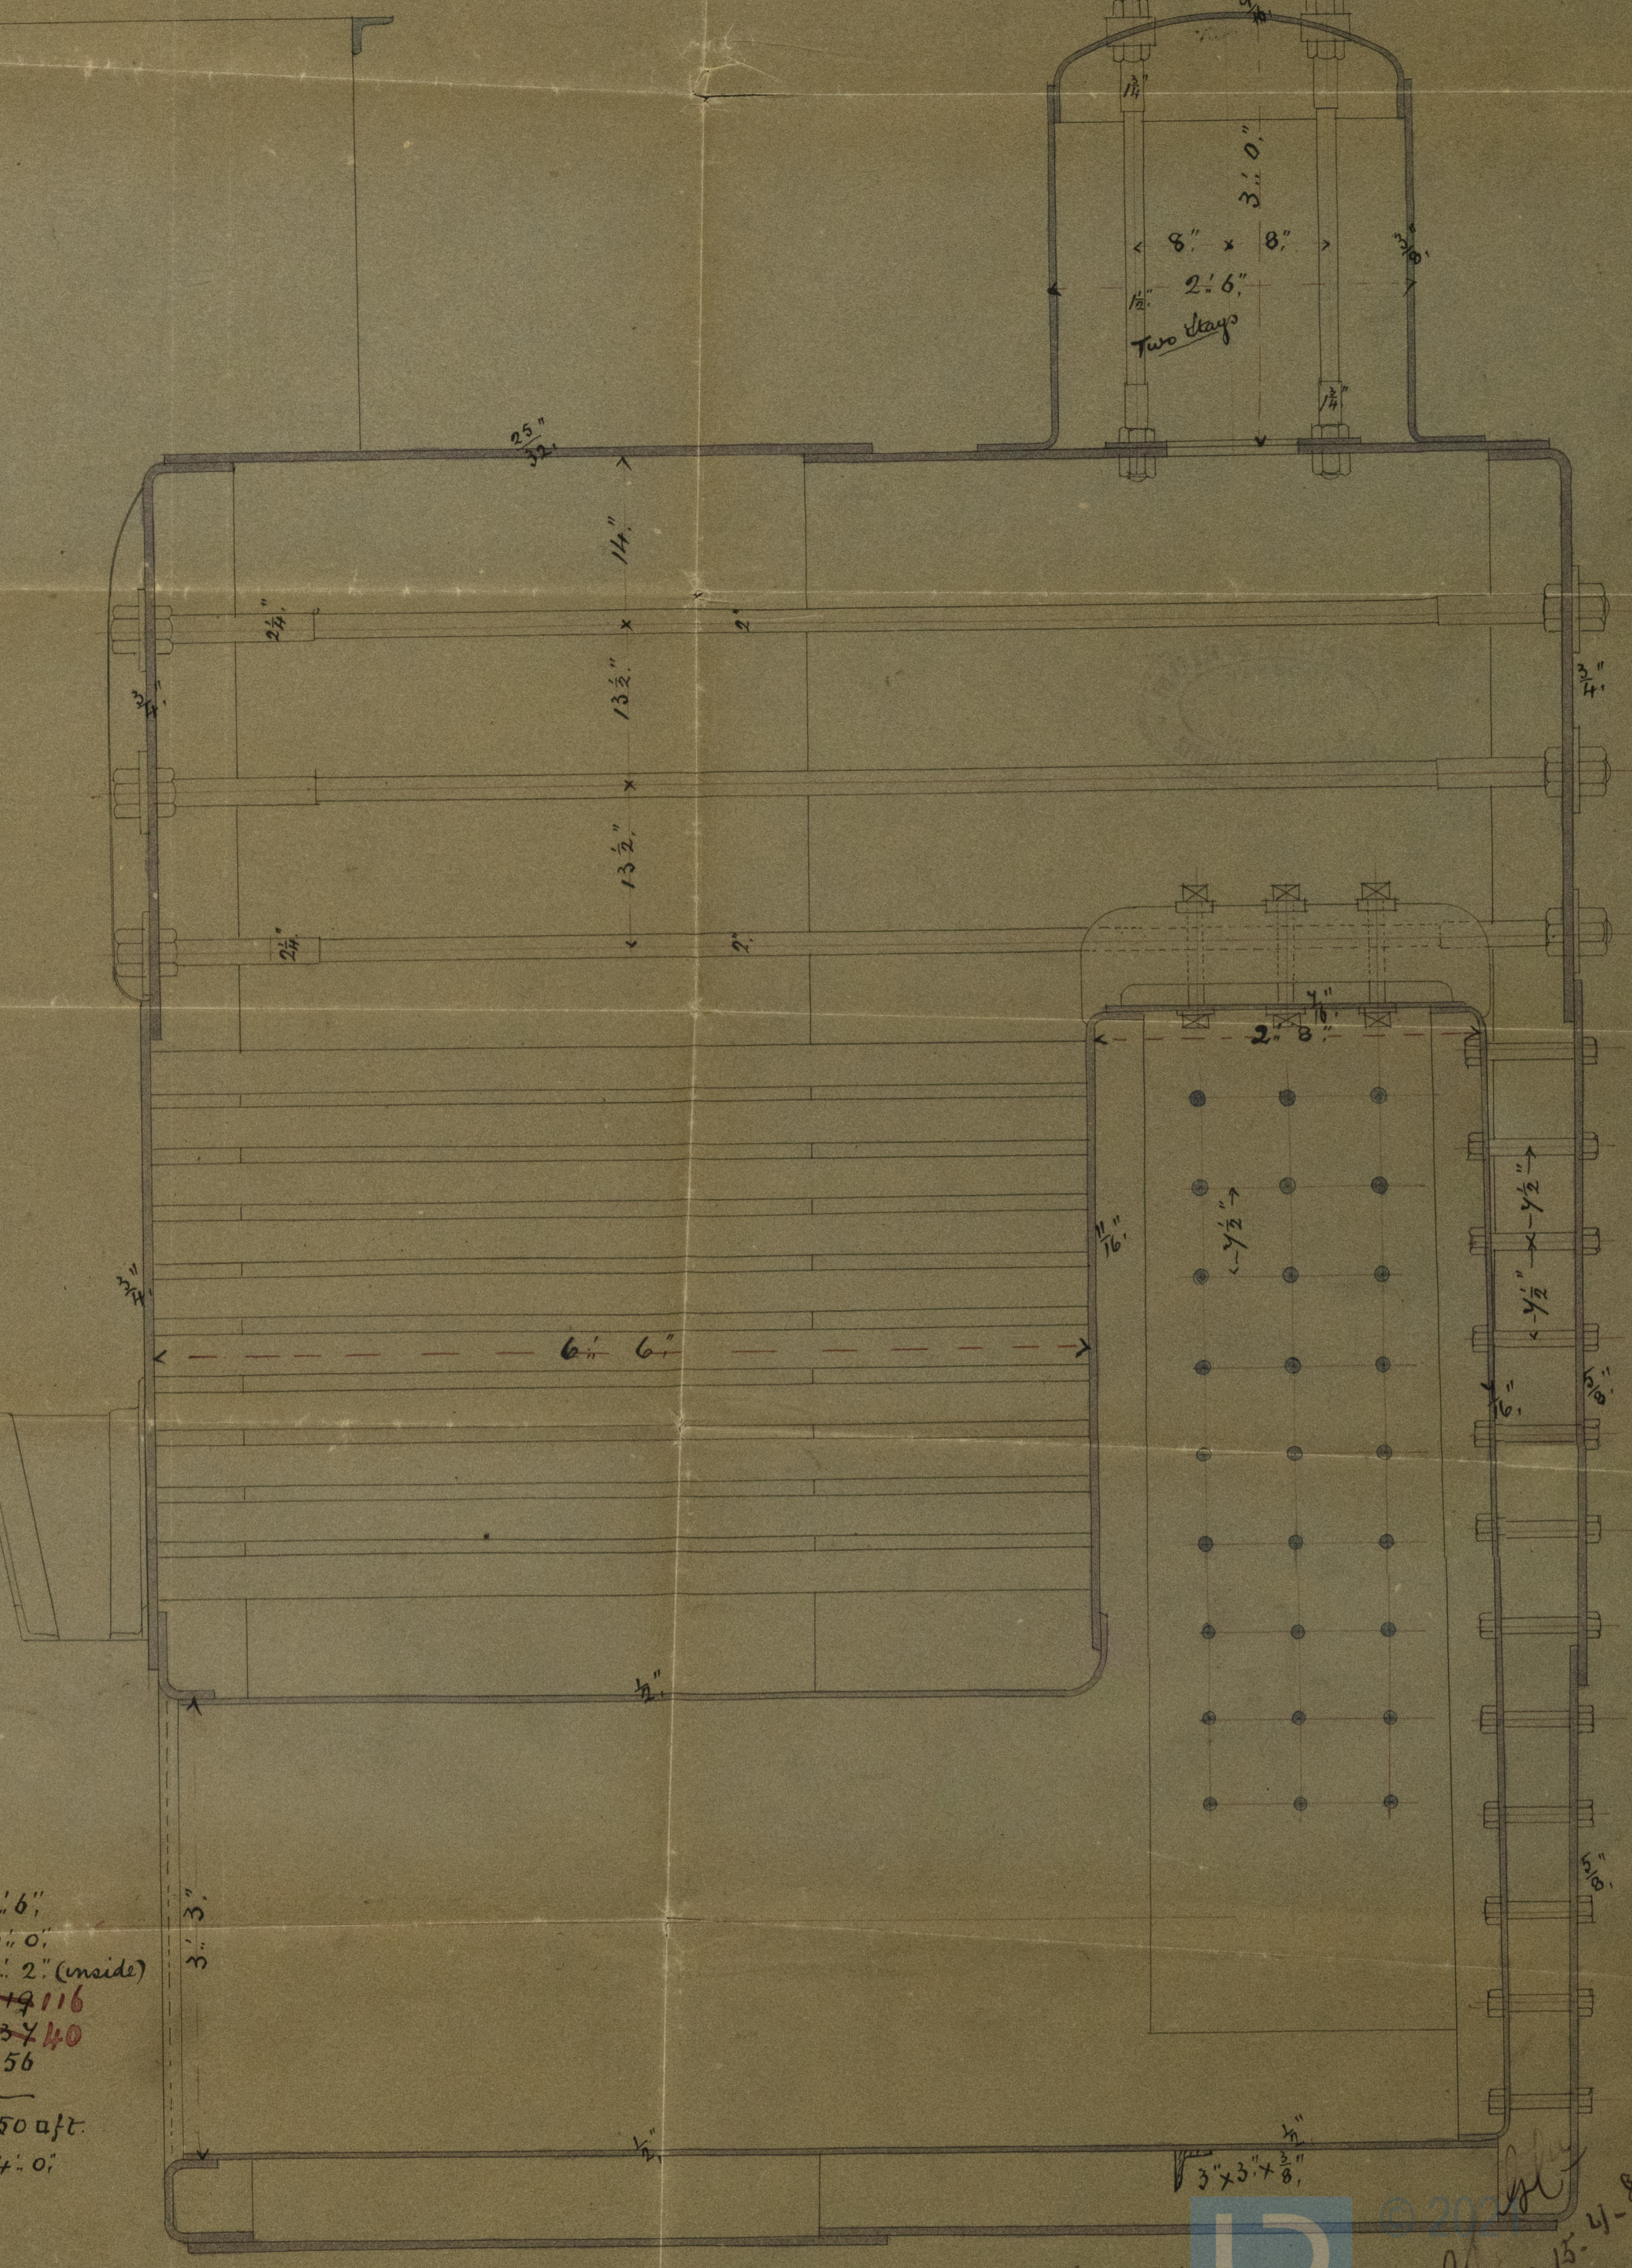

GLS203-0124

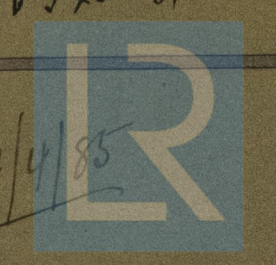

Lloyd's Register  
Foundation