

WILLIAM DENNY & BROTHERS
LONDON

Ans. to Genl.
8/5/85.


PUMPING ARRANGEMENT

S.S. N° 305

SCALE 1/8" = 1 FOOT.

WILLIAM DENNY & BROTHERS
DRAWING OFFICE
No. 12248.
6 MAY 85
LEVEN SHIPYARD

S.S. "Barcoo" Glasgow Report N° 4142.

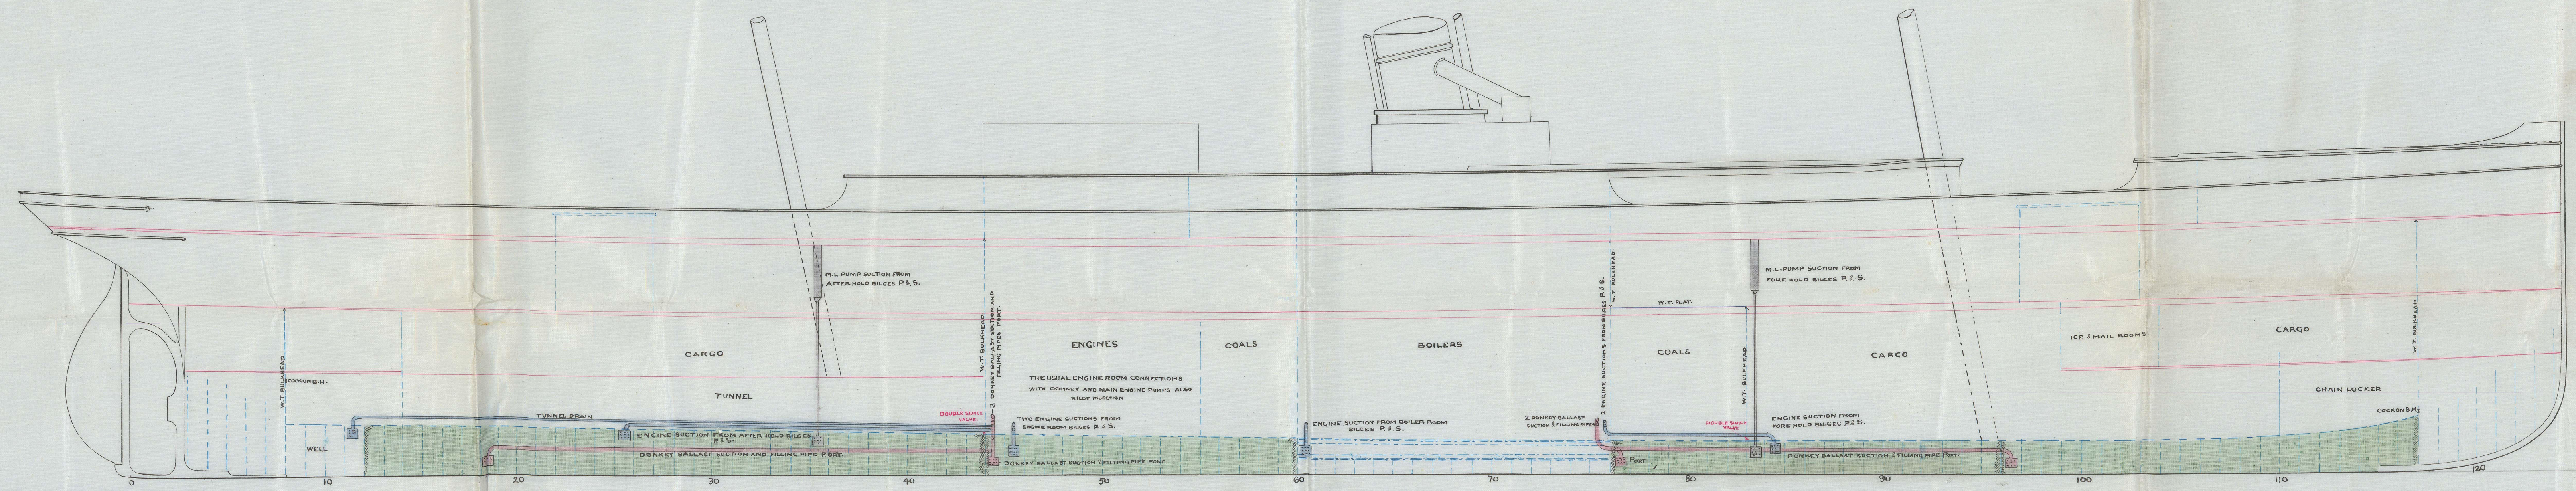

D.P.
8/5/85.

GLS 208-0143