

Dr. 5 Sh.  
27. 2. 85







250 x 36 x 24. ML<sup>D</sup>.

TO CLASS 100 A.1 (BUILT OF STEEL)

SCALE  $\frac{1''}{8} = 1 \text{ FOOT.}$

SCALE  $\overline{6}$  = 1 FOOT.  
Spar deck below

S.S. "Barcoo" Glasgow Report A<sup>2</sup> 7142.—

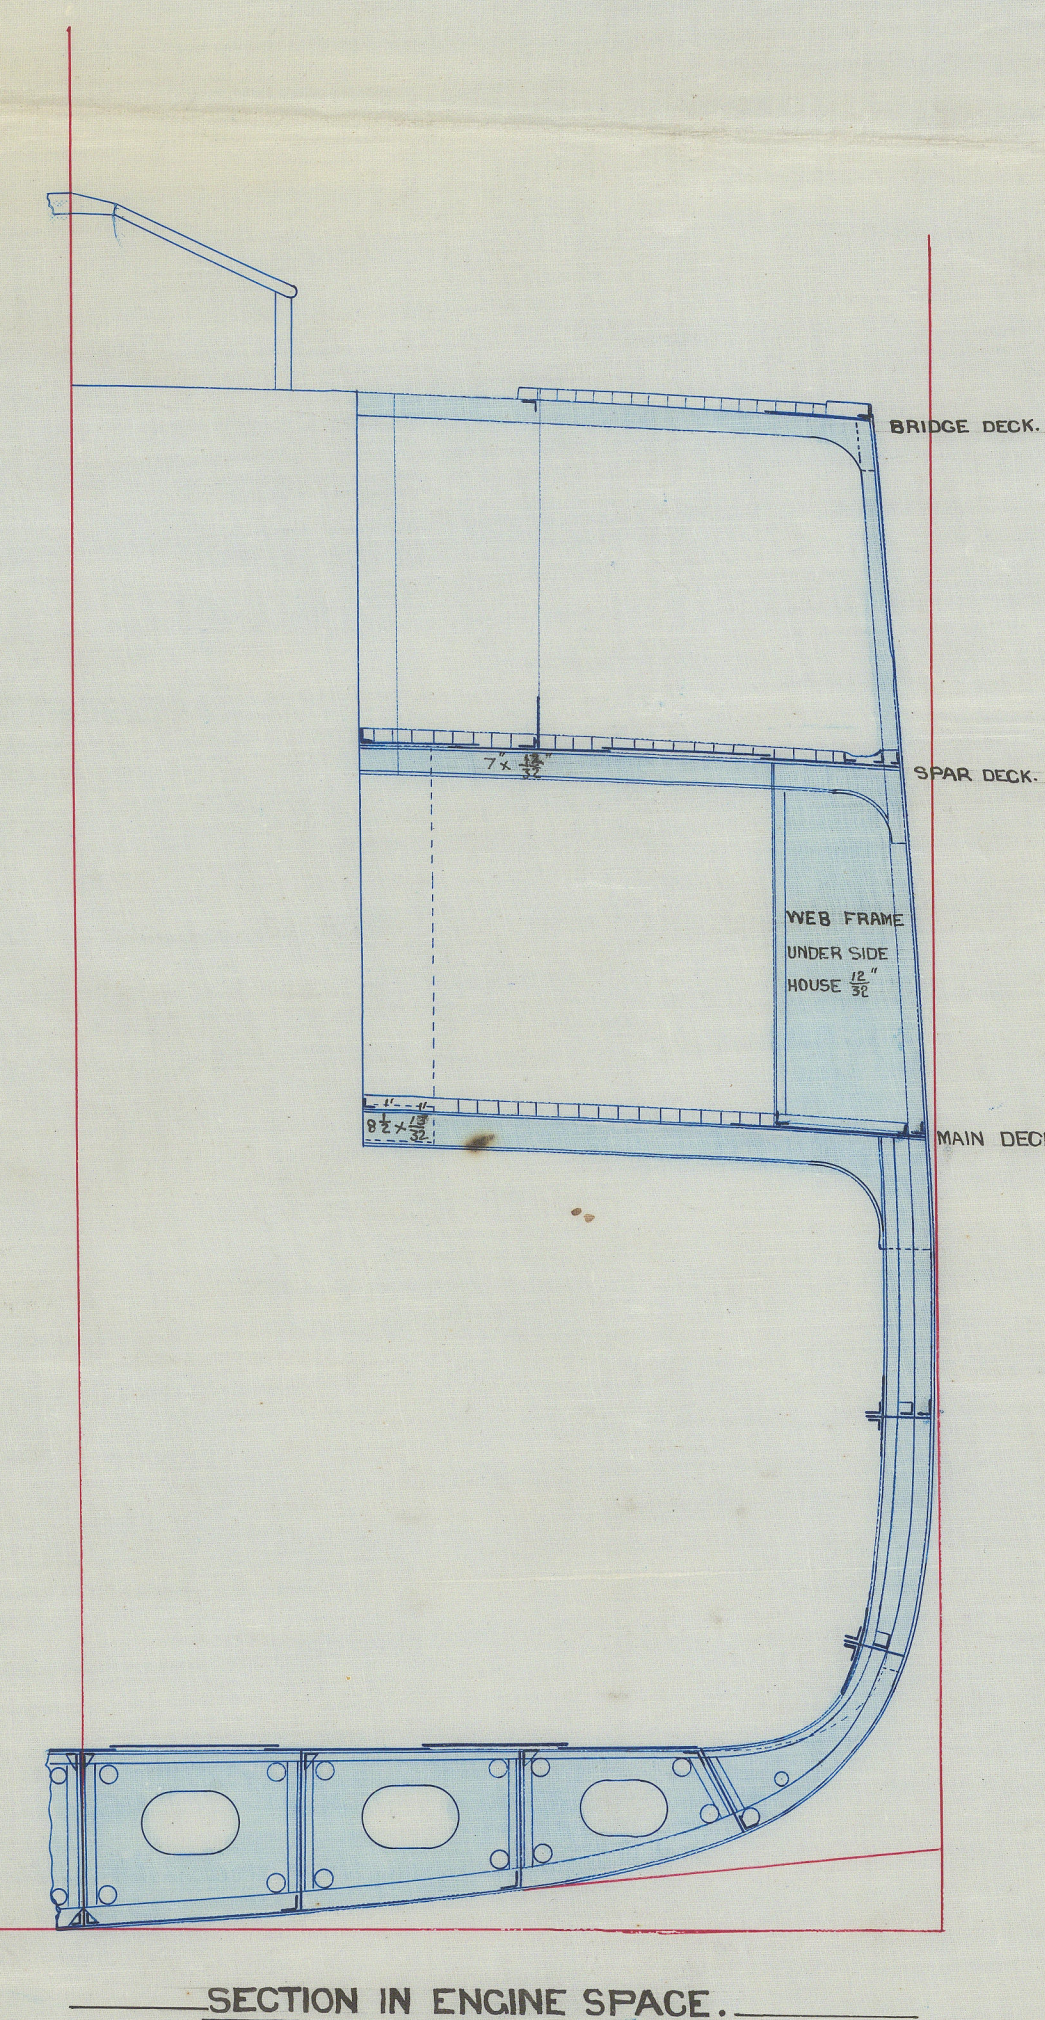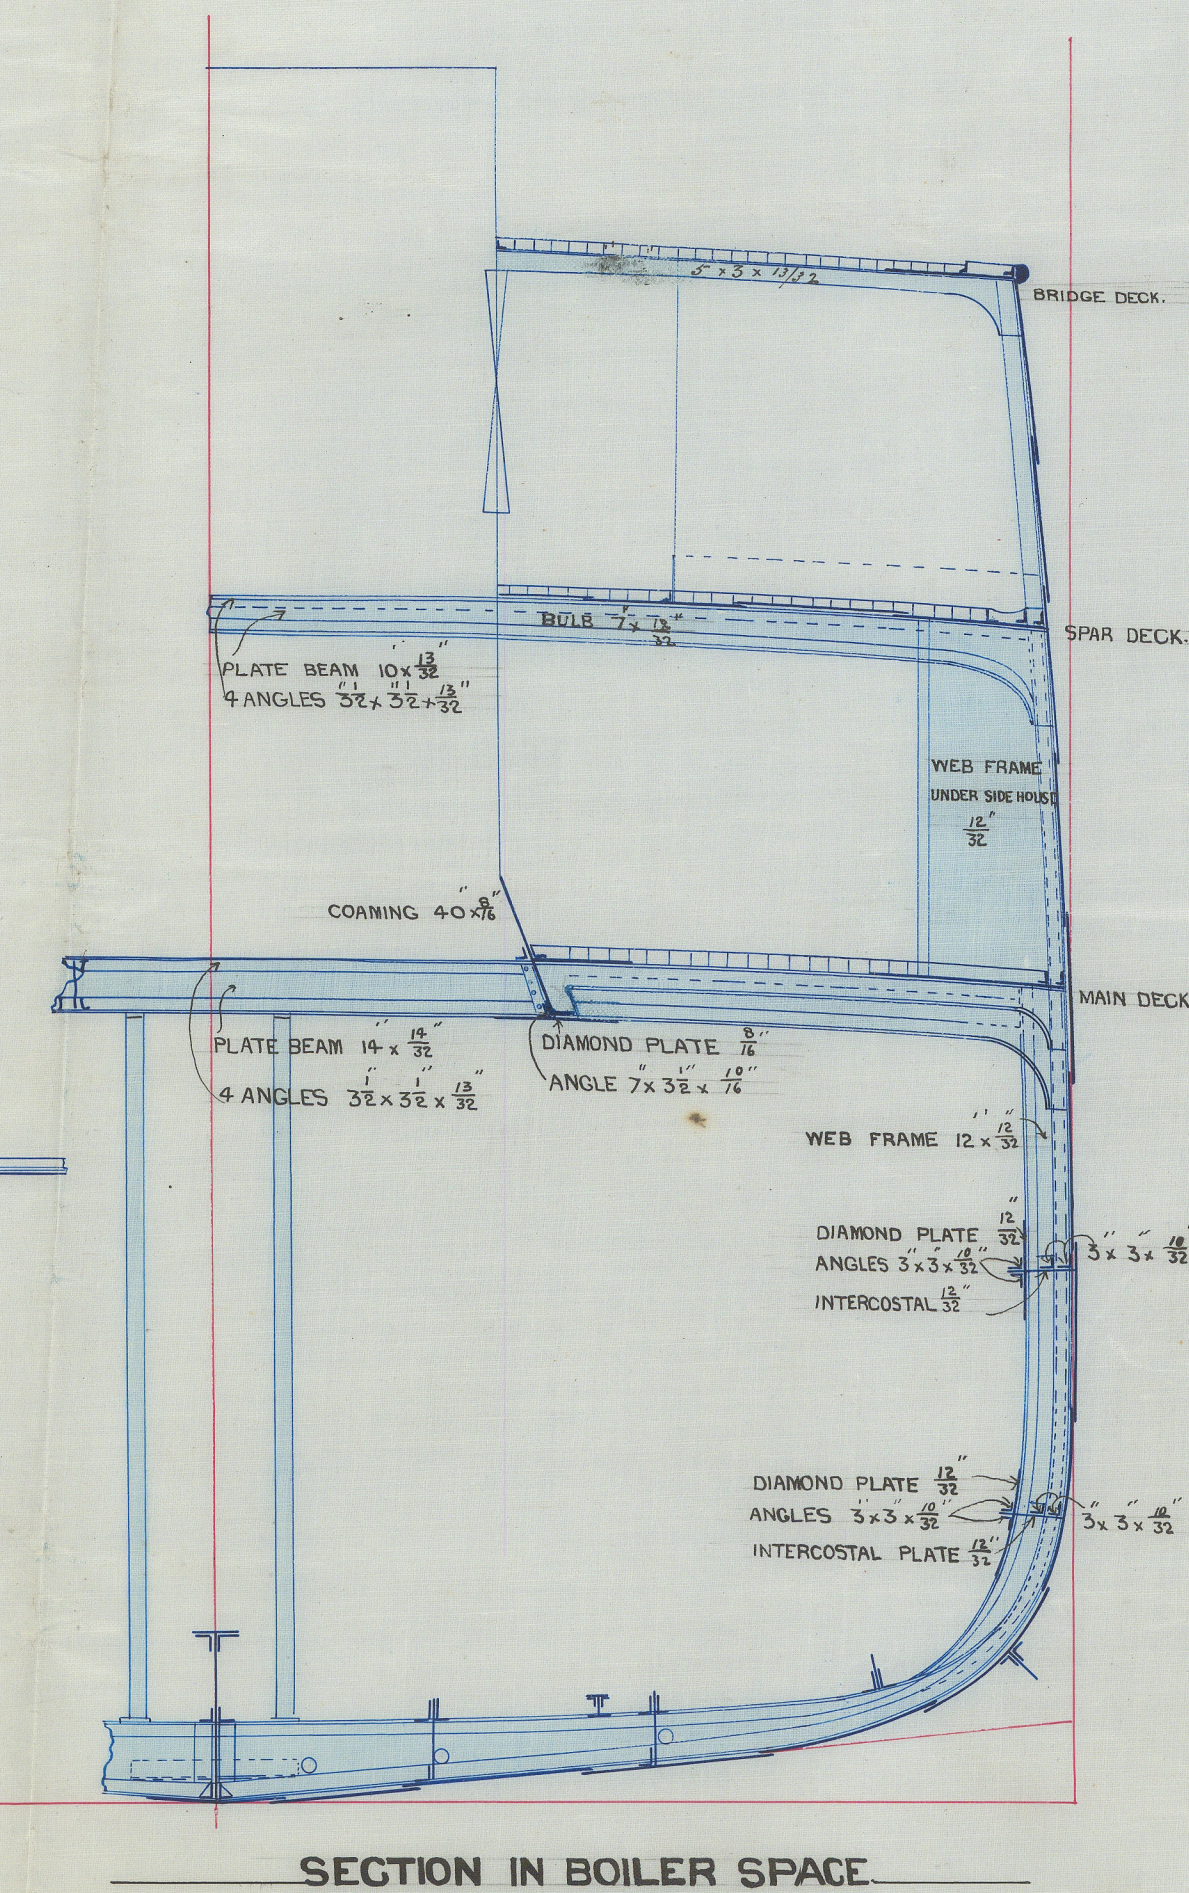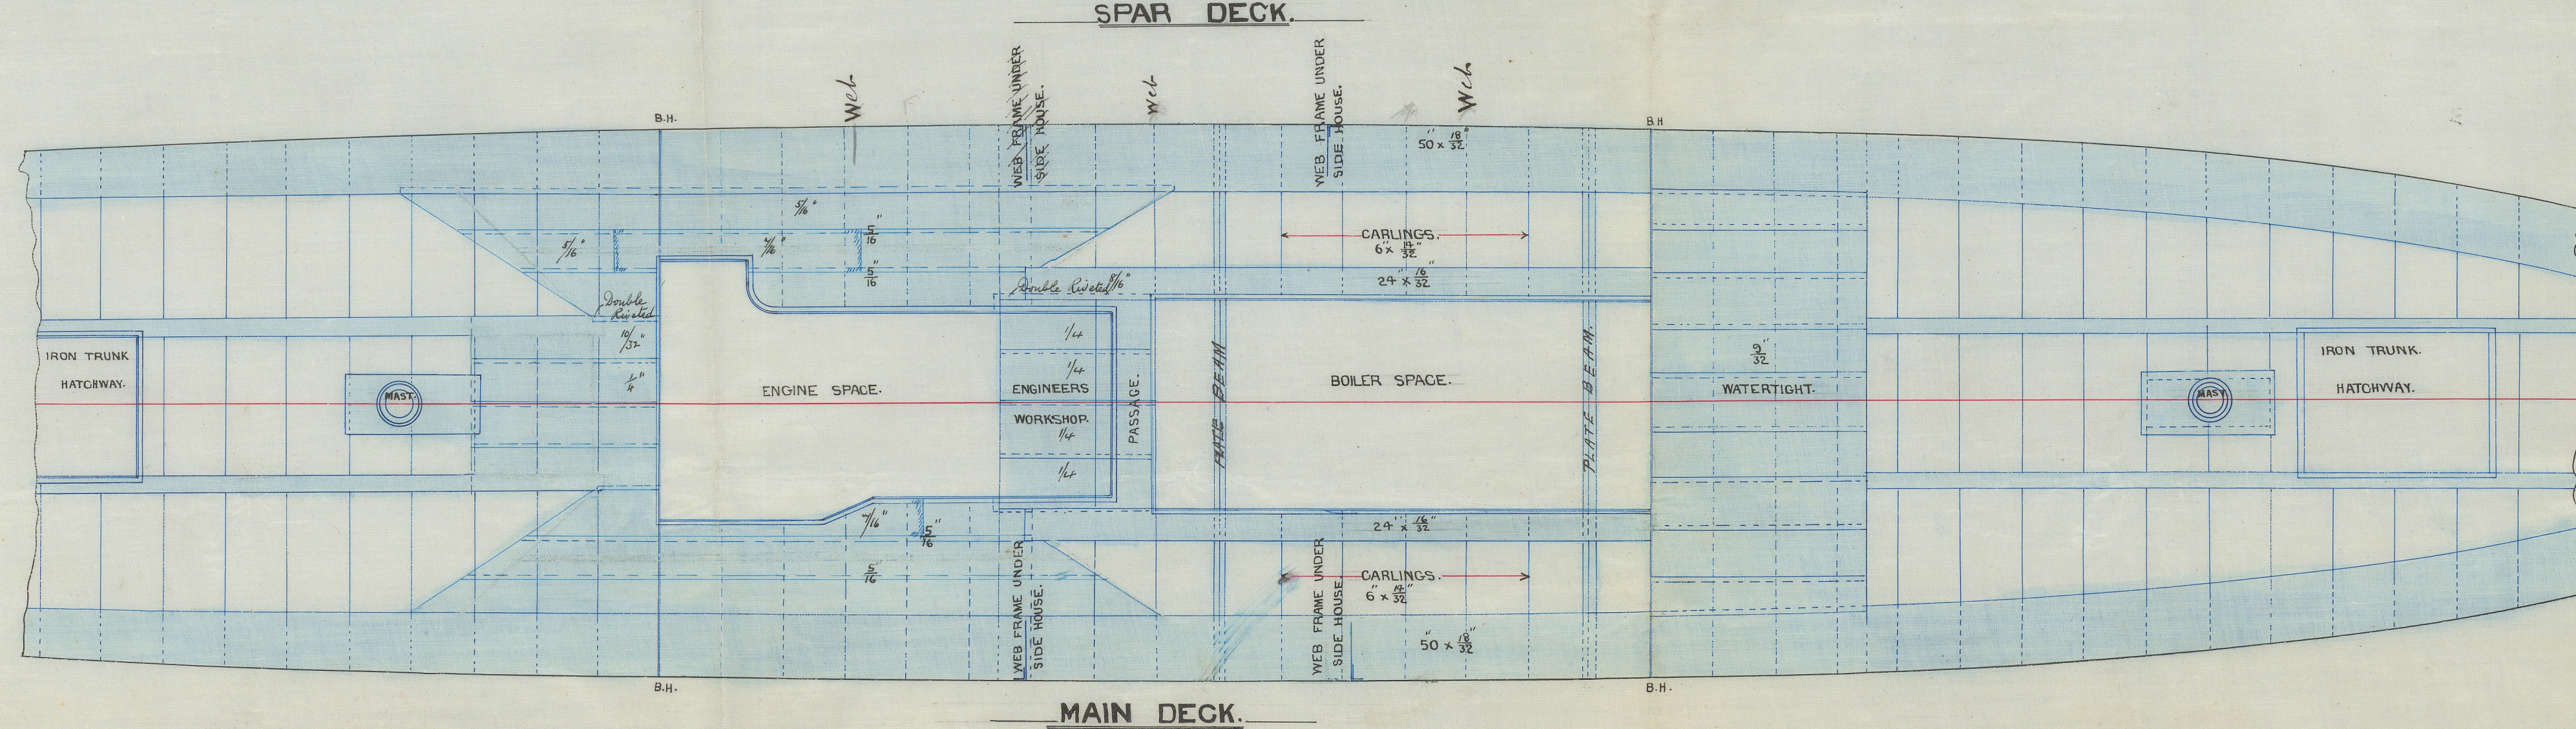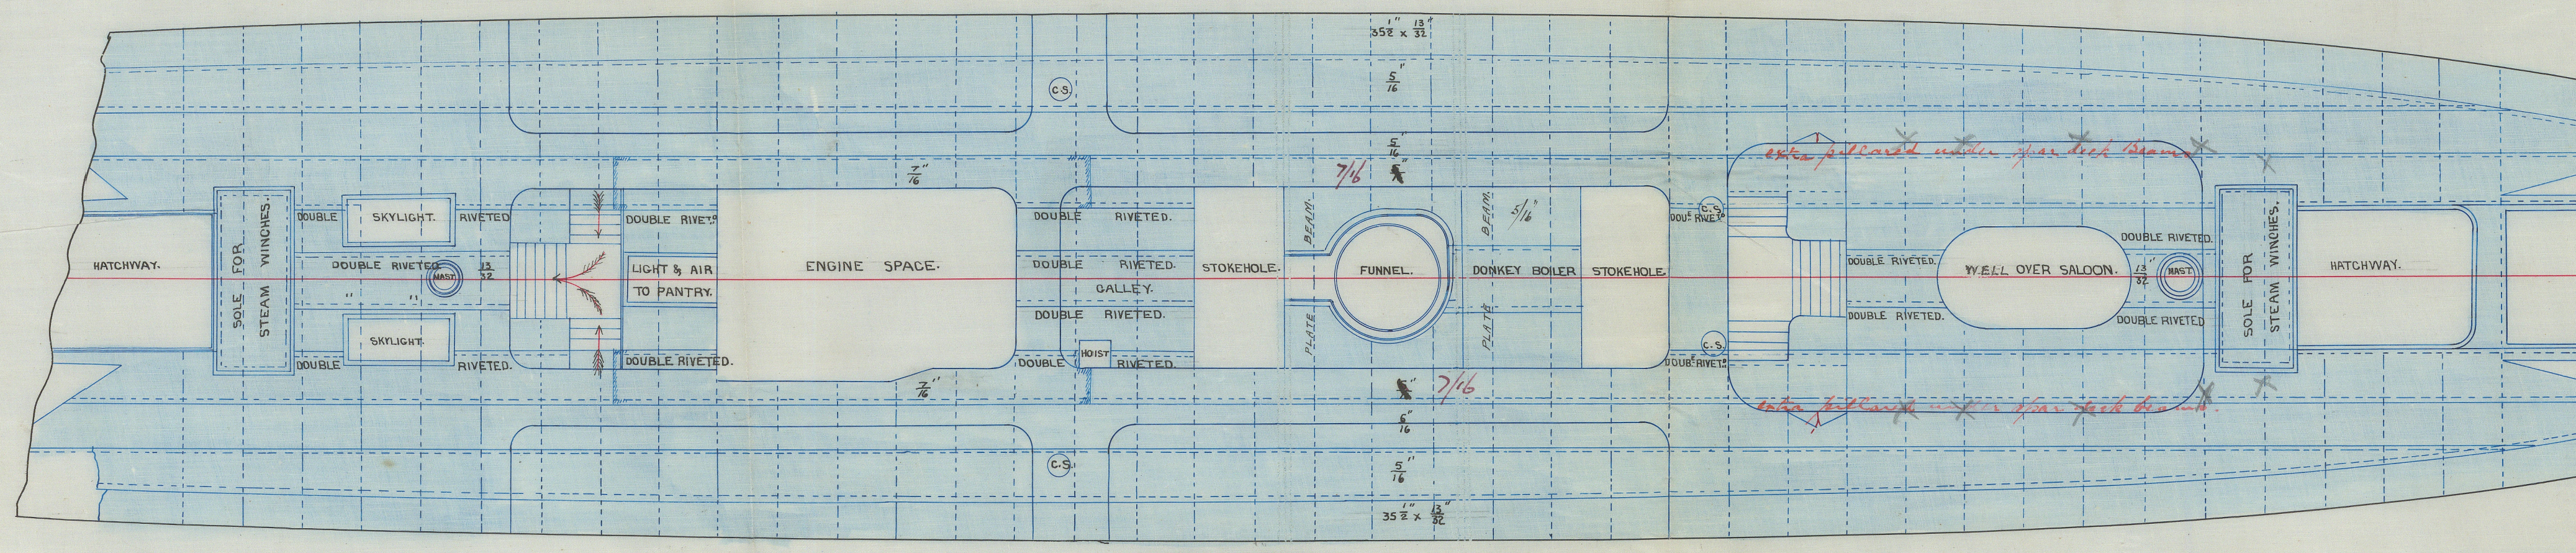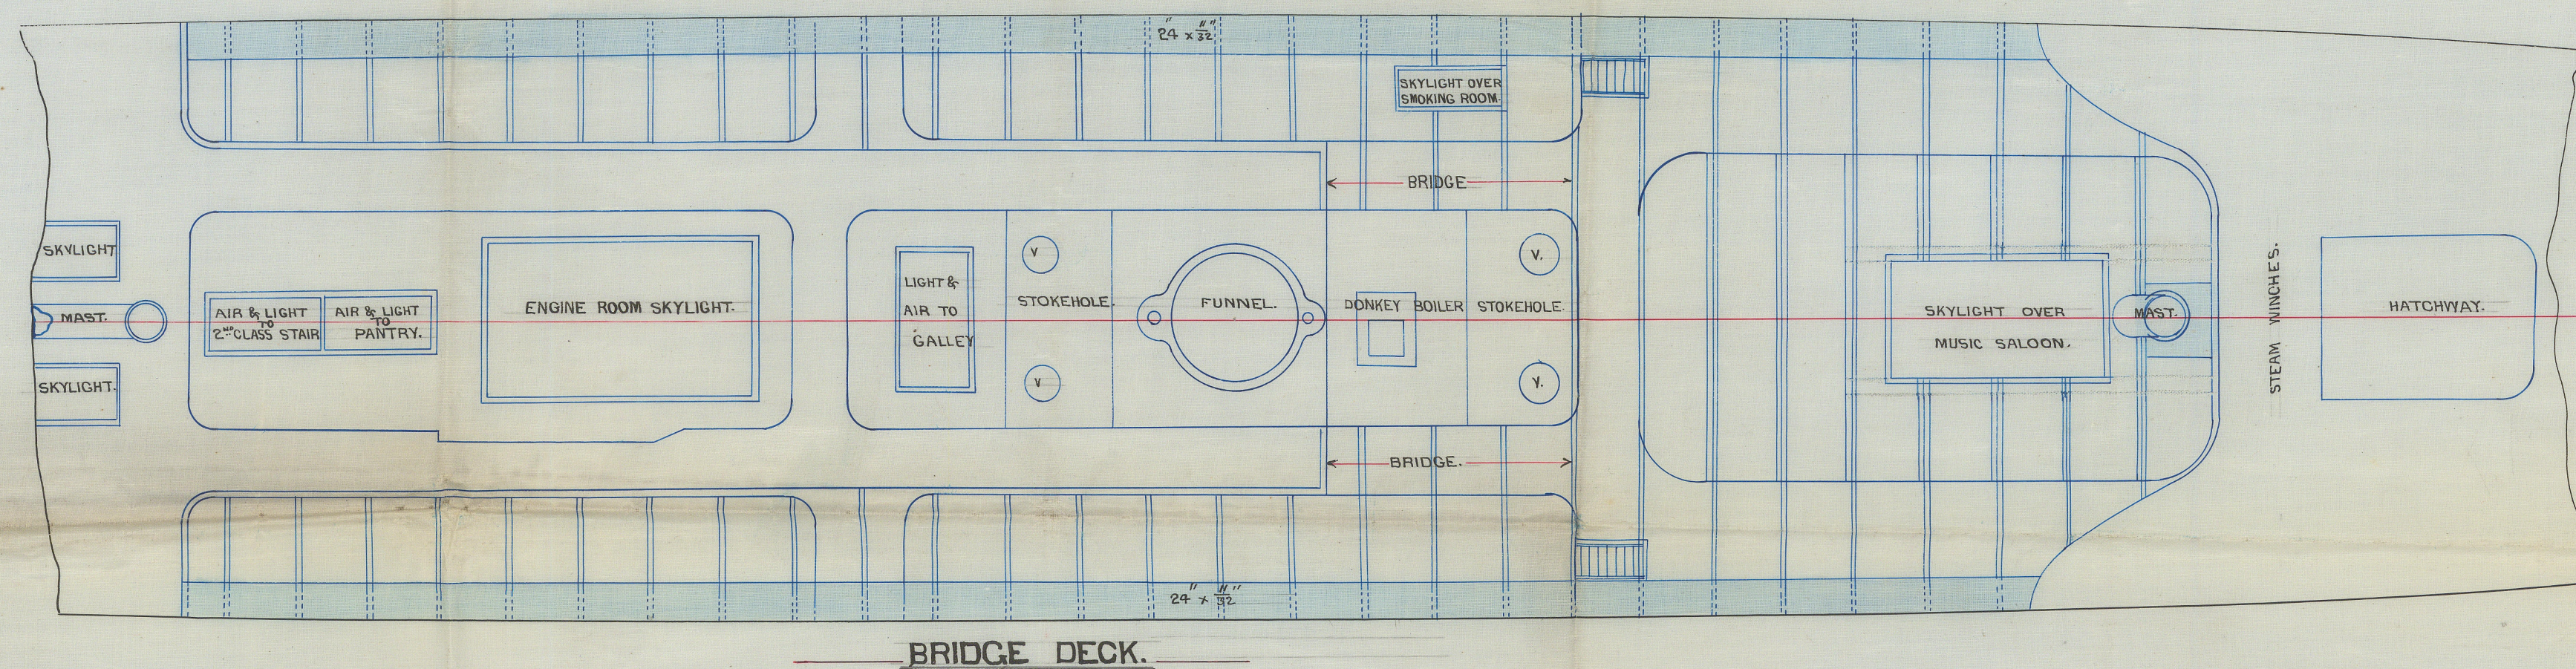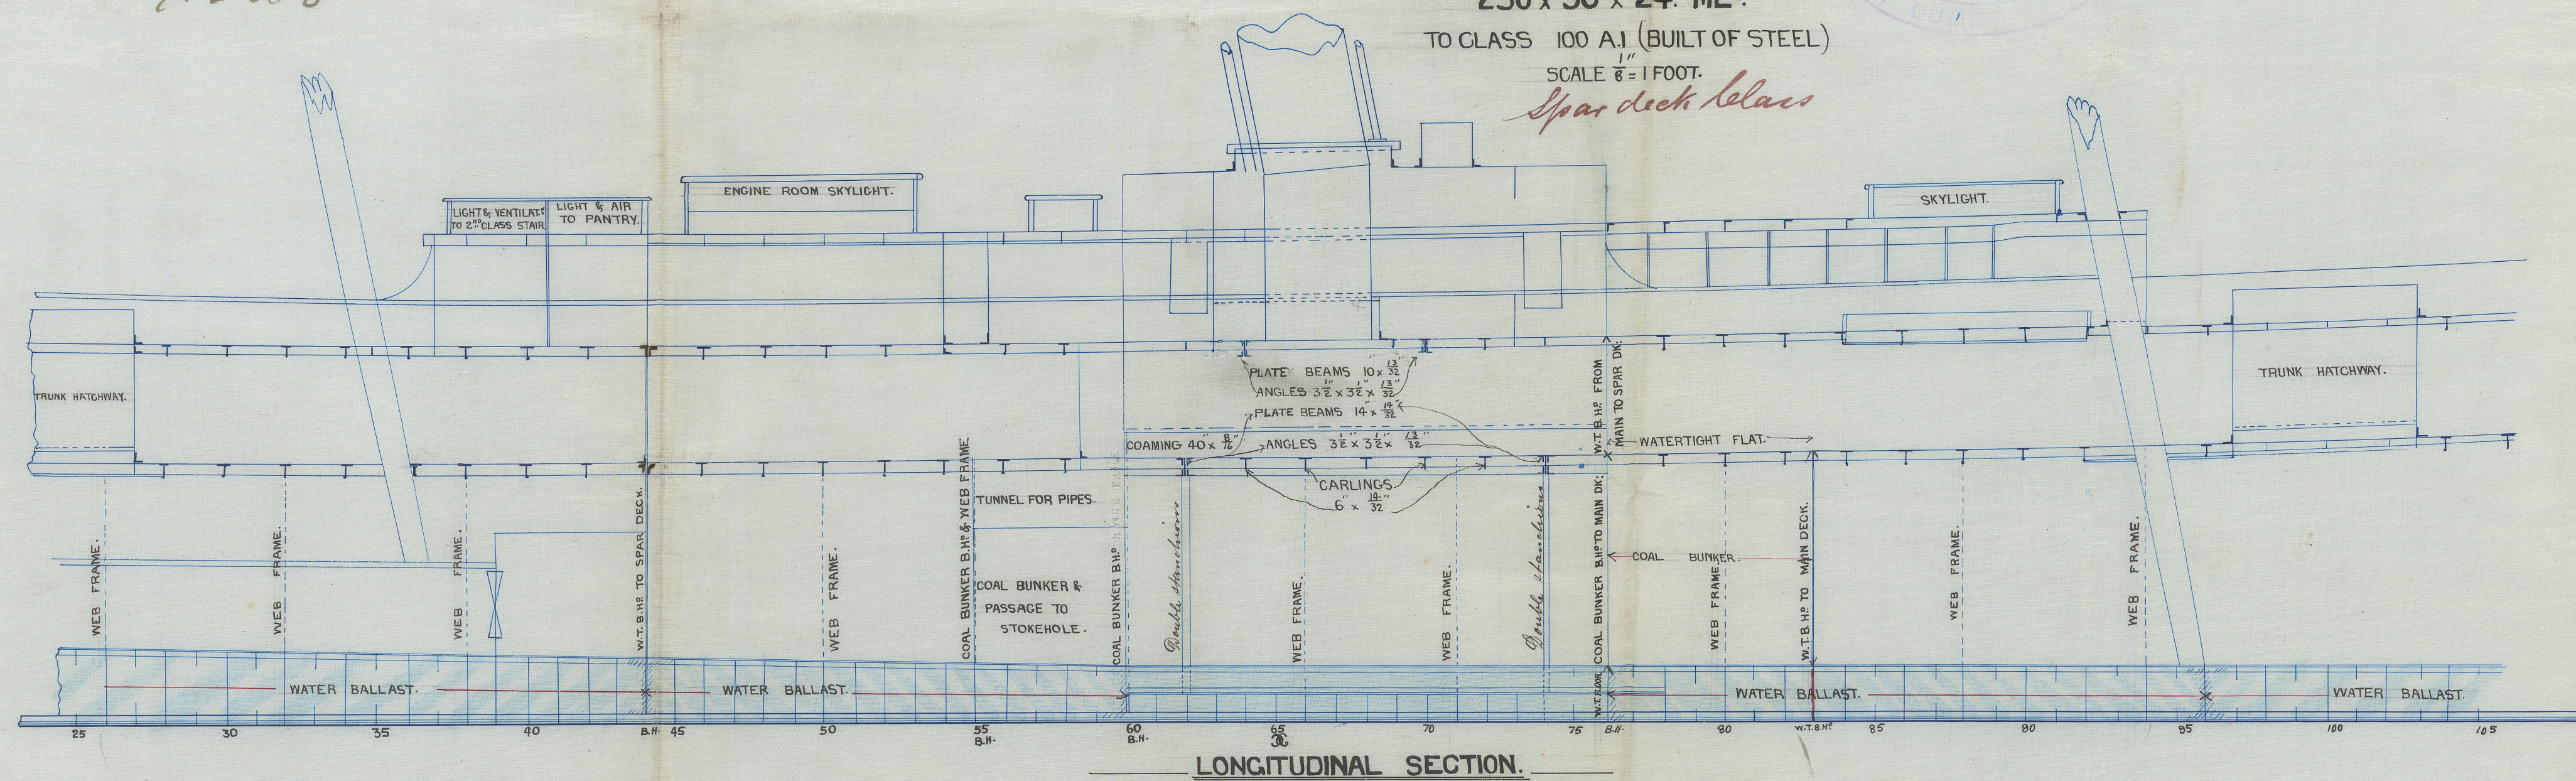

27/2/85  
GLS203-0146