



24.5 lb
30/3/85

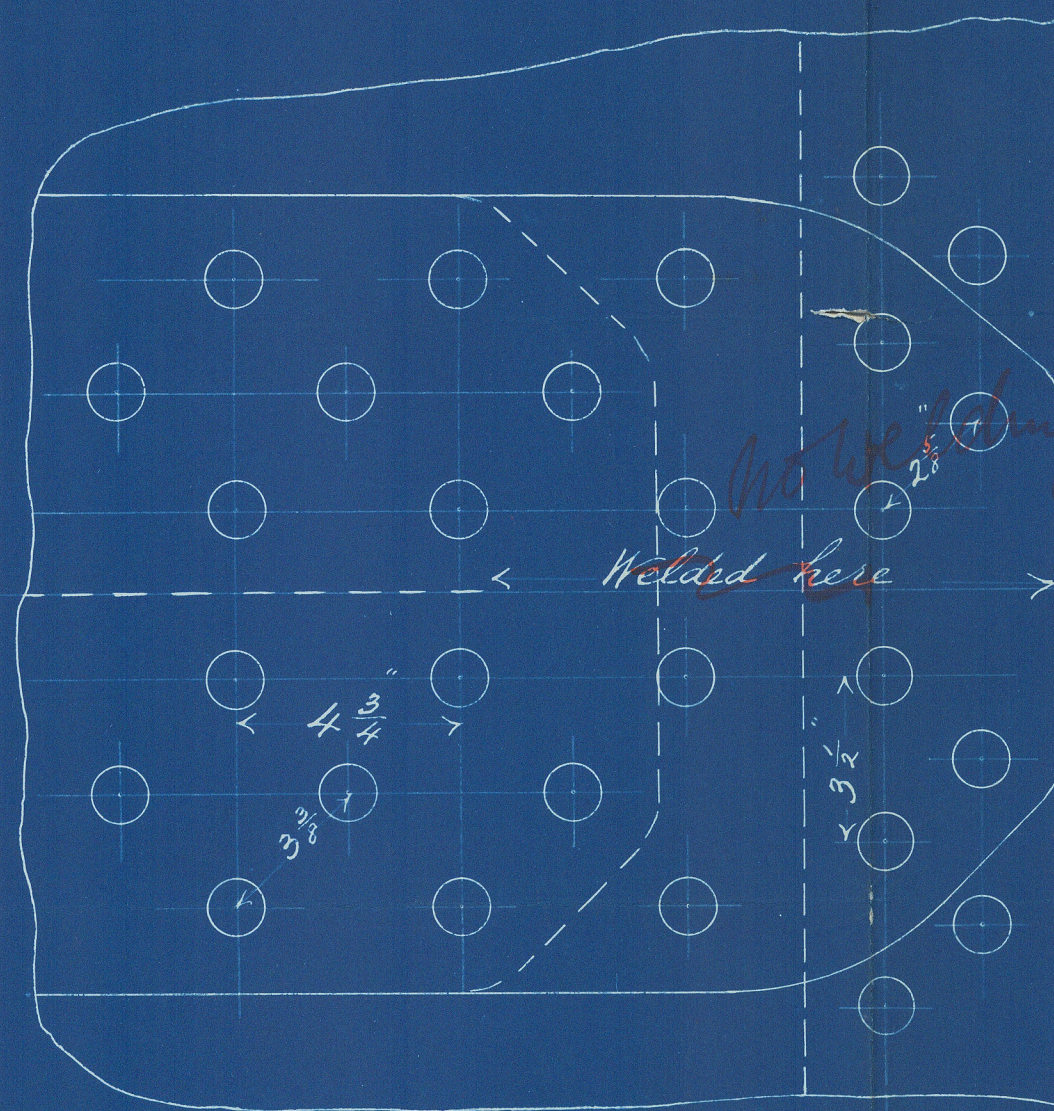

S. S. Duebracho
Glasgow Report
No. 4152.

Boiler No. 663
Working Pressure 100 lbs. per sq. in.



Sketch of Dome Riveting

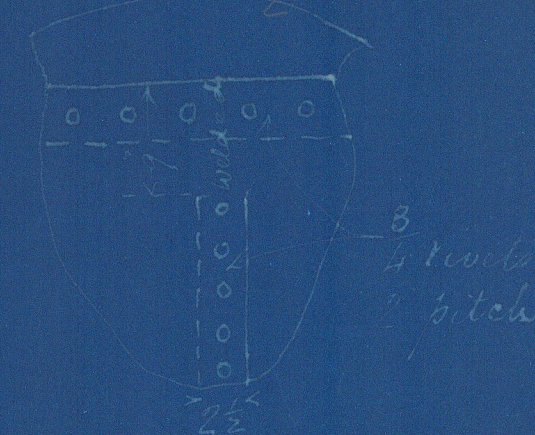

Manhole door on top 18" x 13"
Compensating Ring 7/8" 7/8"

James Anderson & Co.
MILLWRIGHTS
ENGINEERS & BOILERMAKERS
CLYDE ST. ENGINE WORKS
GLASGOW.
2/3/85.

Scale 1" = 1 foot
All Stays & Rivets of iron

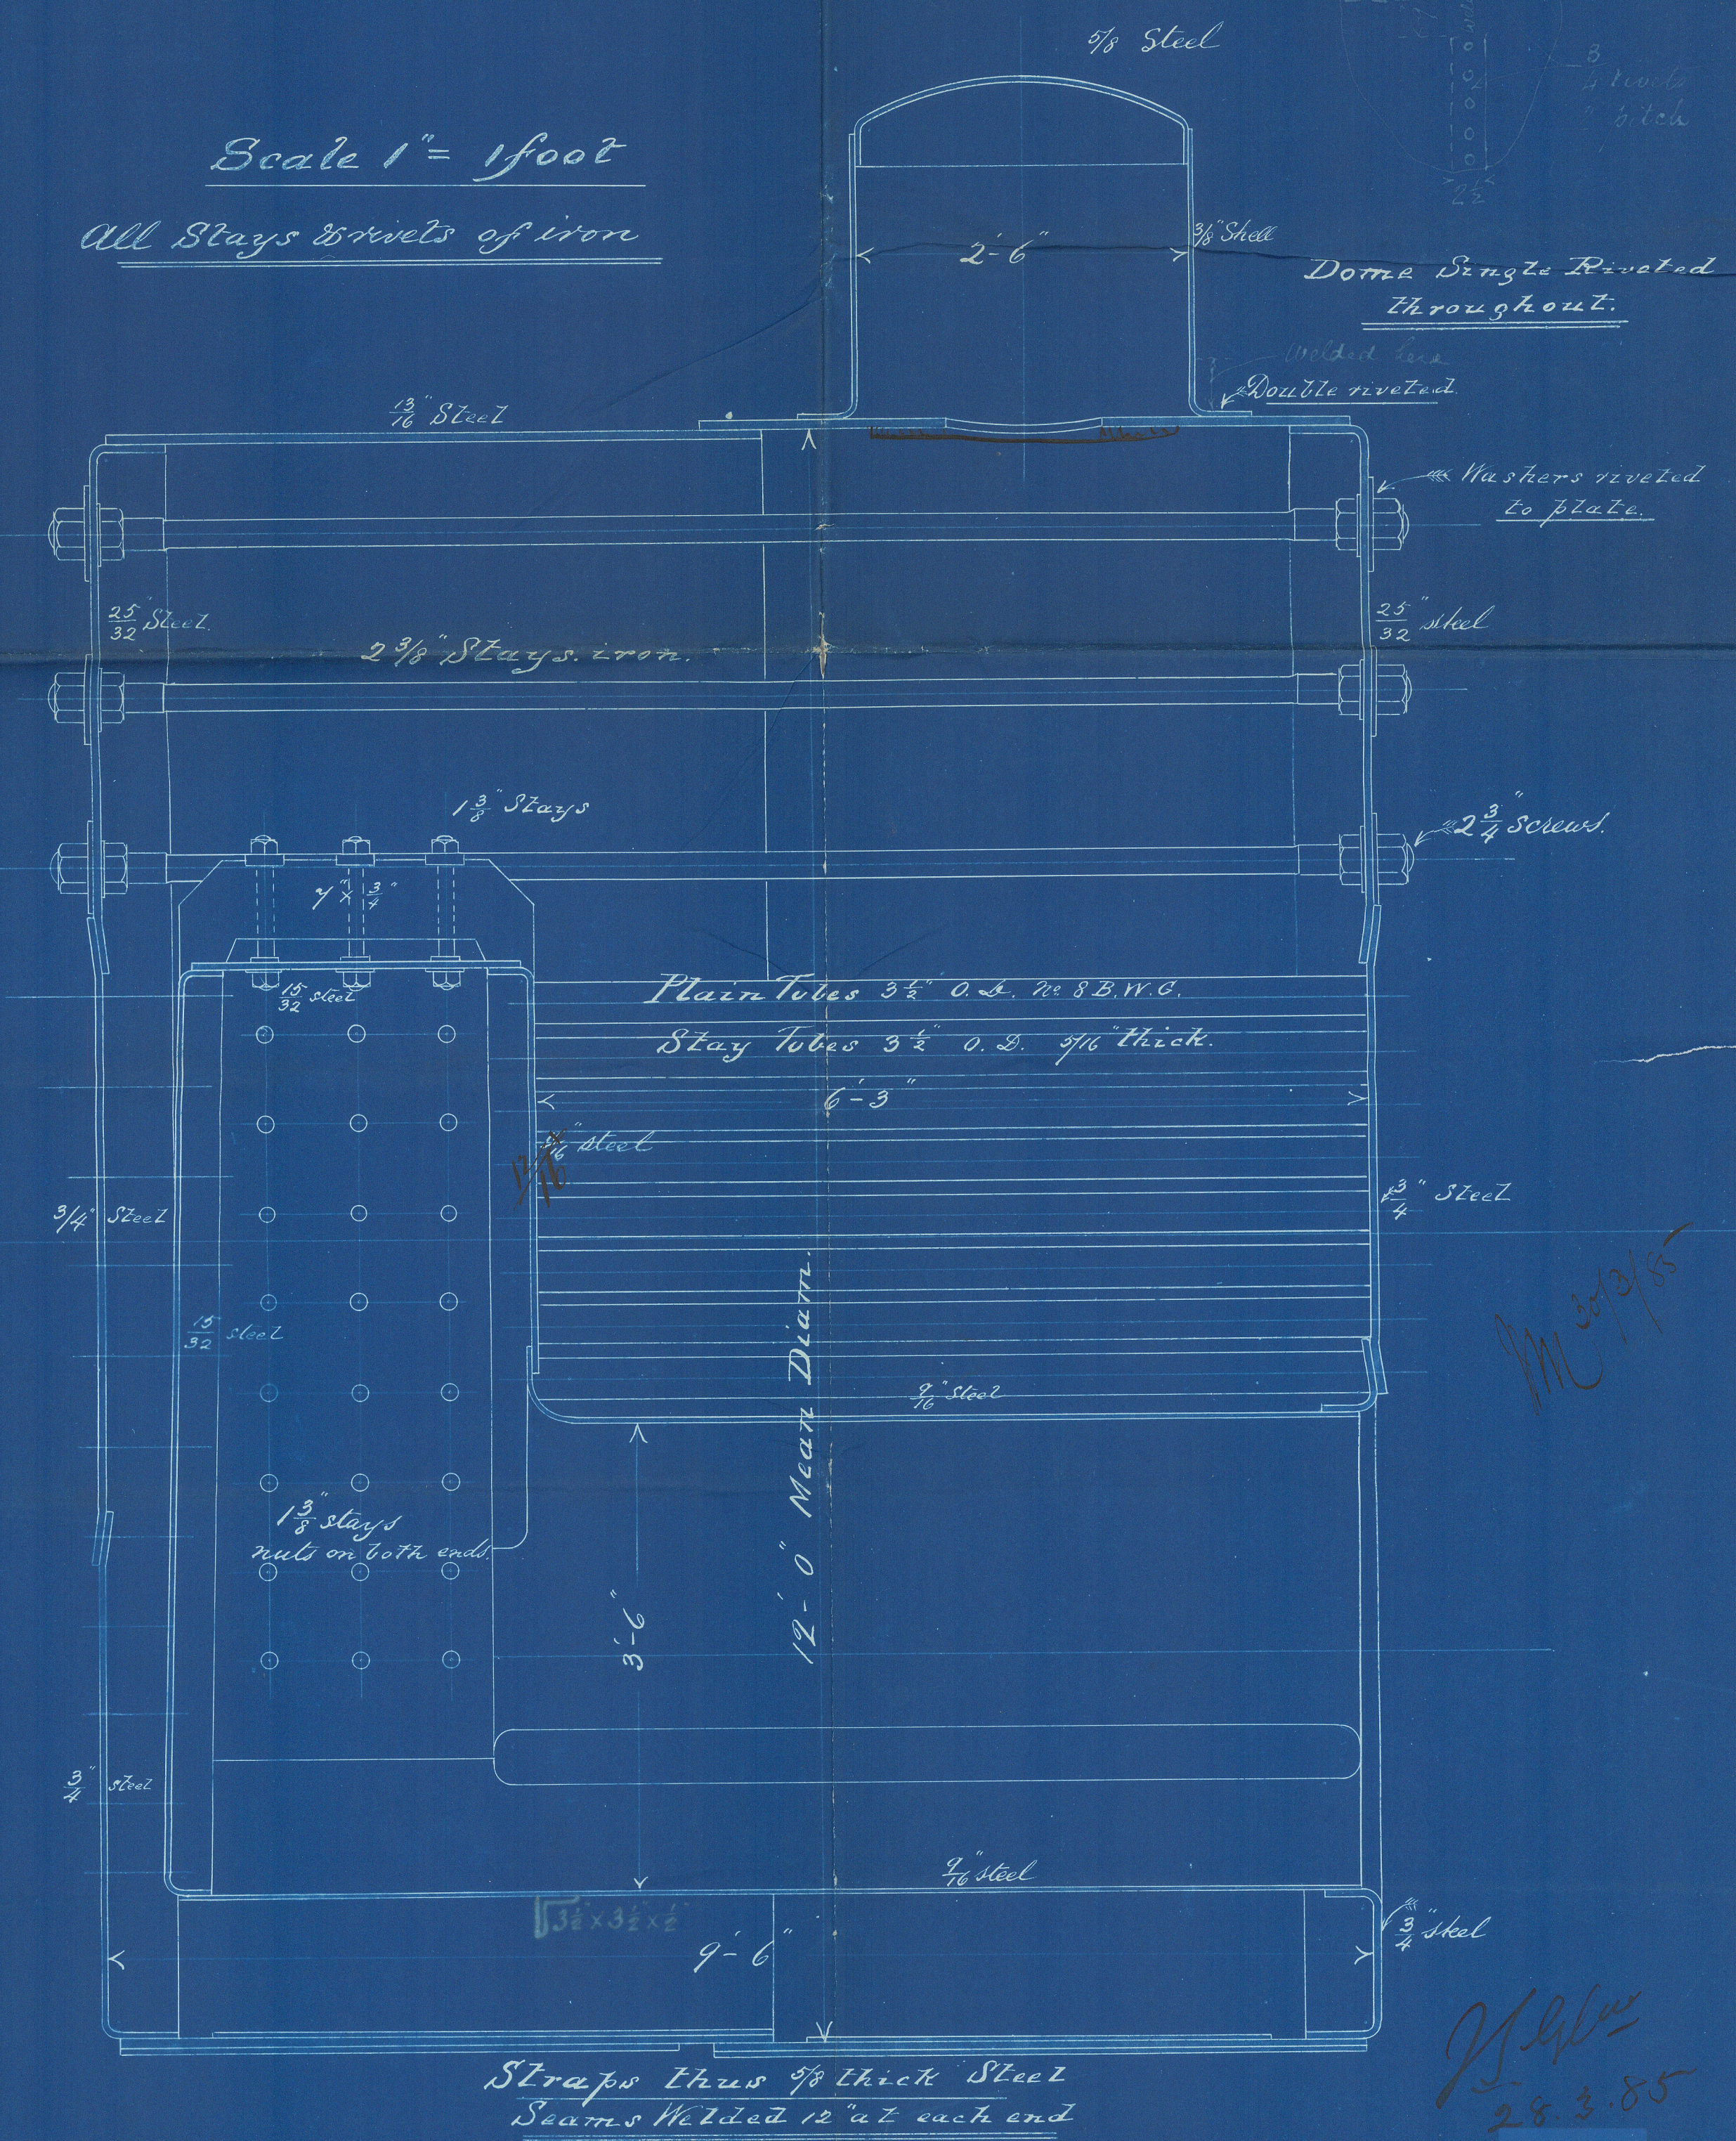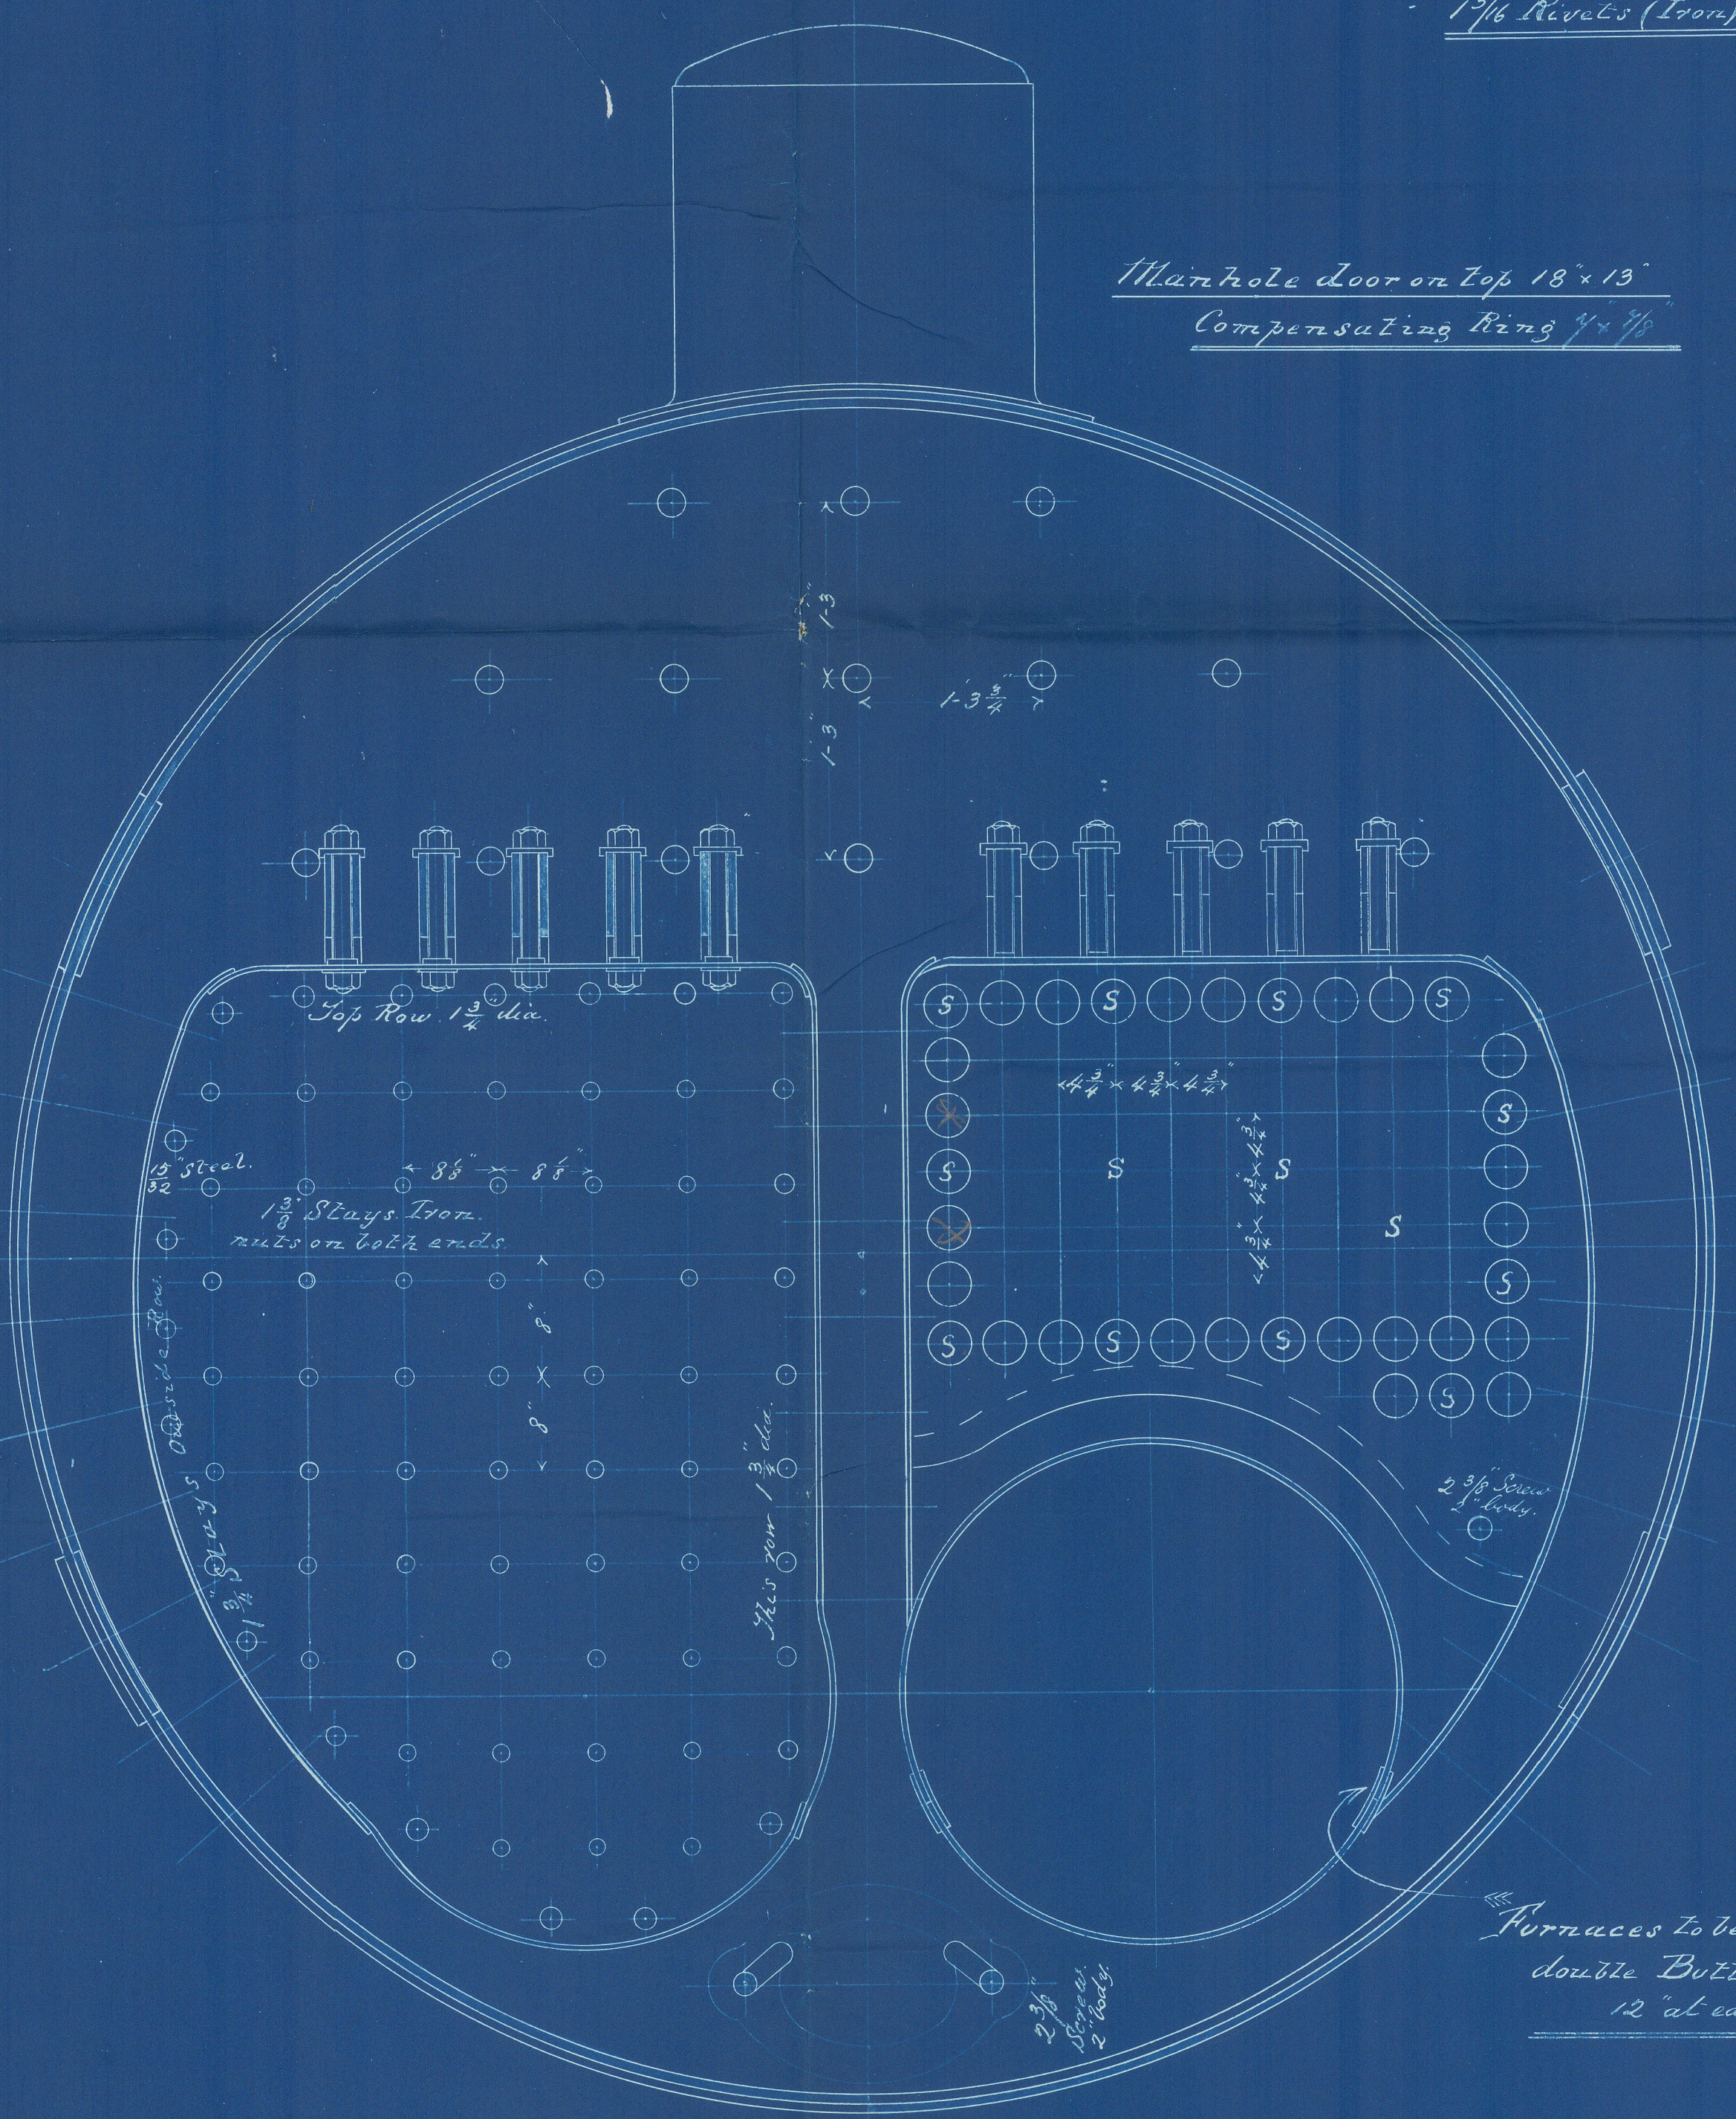

MC 24/3/85

28.3.85

G15203-0151



GLS203-0151



© 2021

Lloyd's Register
Foundation