





S. S. "Satties"  
Glasgow Report No 7 7144. —

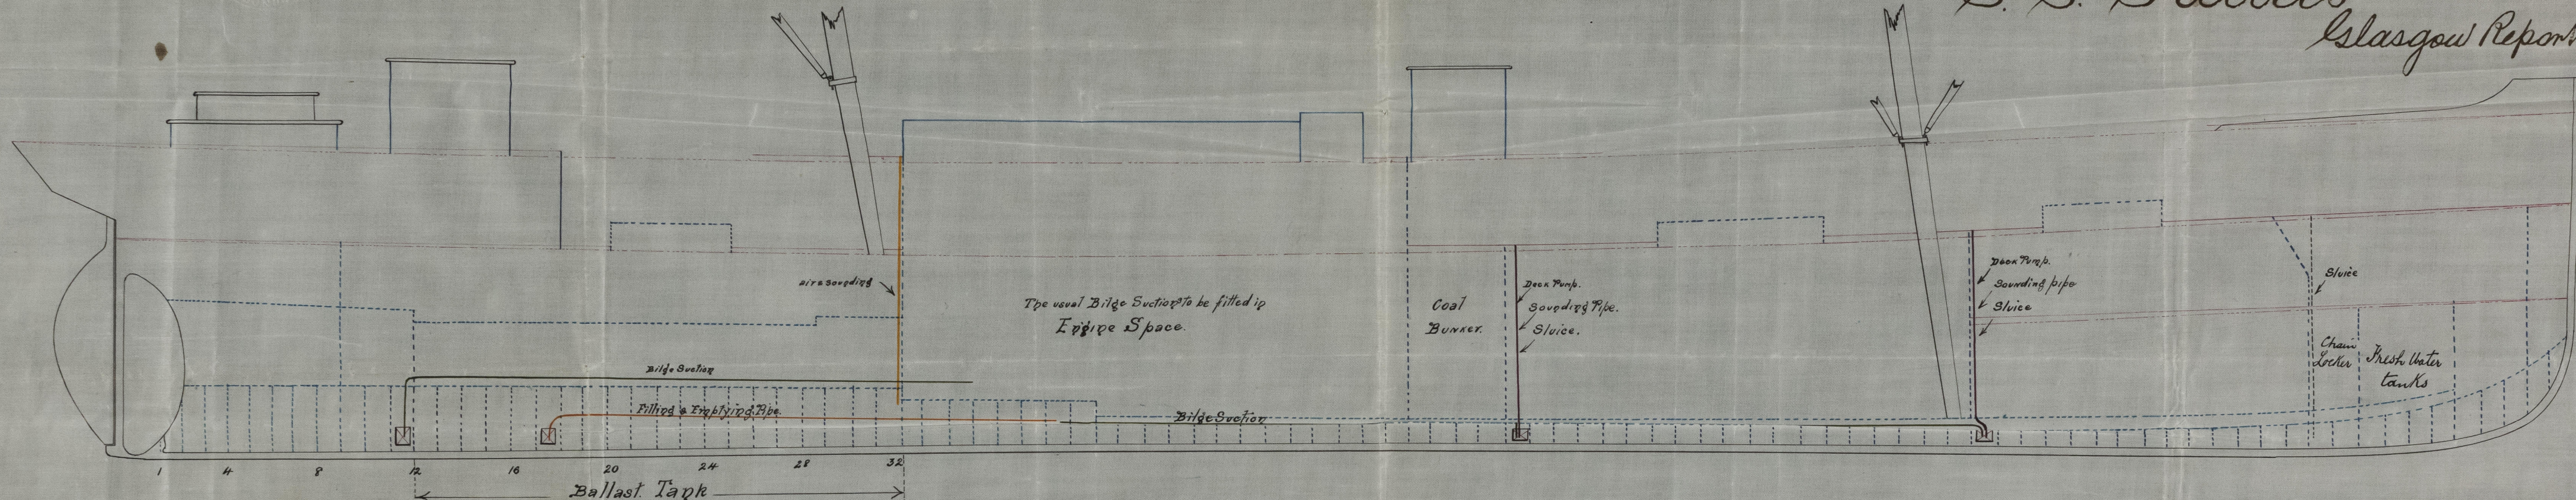

deck pump to after hold.

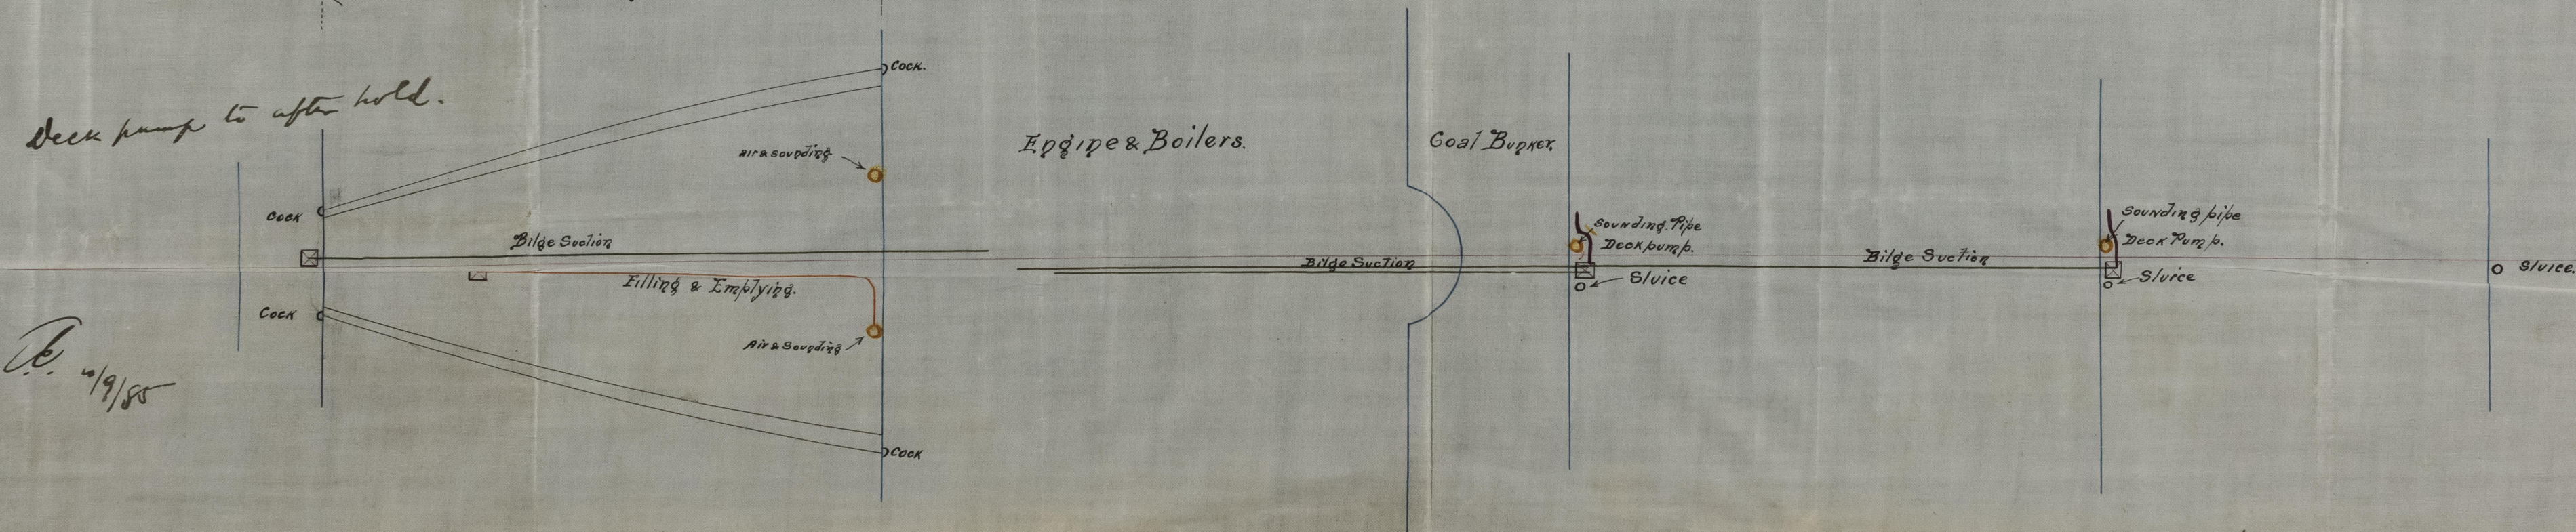

*P. 4/9/80*

\_\_\_\_\_ Piping Plan \_\_\_\_\_  
 \_\_\_\_\_ S.S. No 322 \_\_\_\_\_  
 \_\_\_\_\_ Scale  $\frac{1}{8}$ " = 100' Foot. \_\_\_\_\_



D.F.  
3/0/85

3/0/65

Lloyd's Register  
Foundation

GLS203-0173