



Lpr: to Glas. 24/4/85

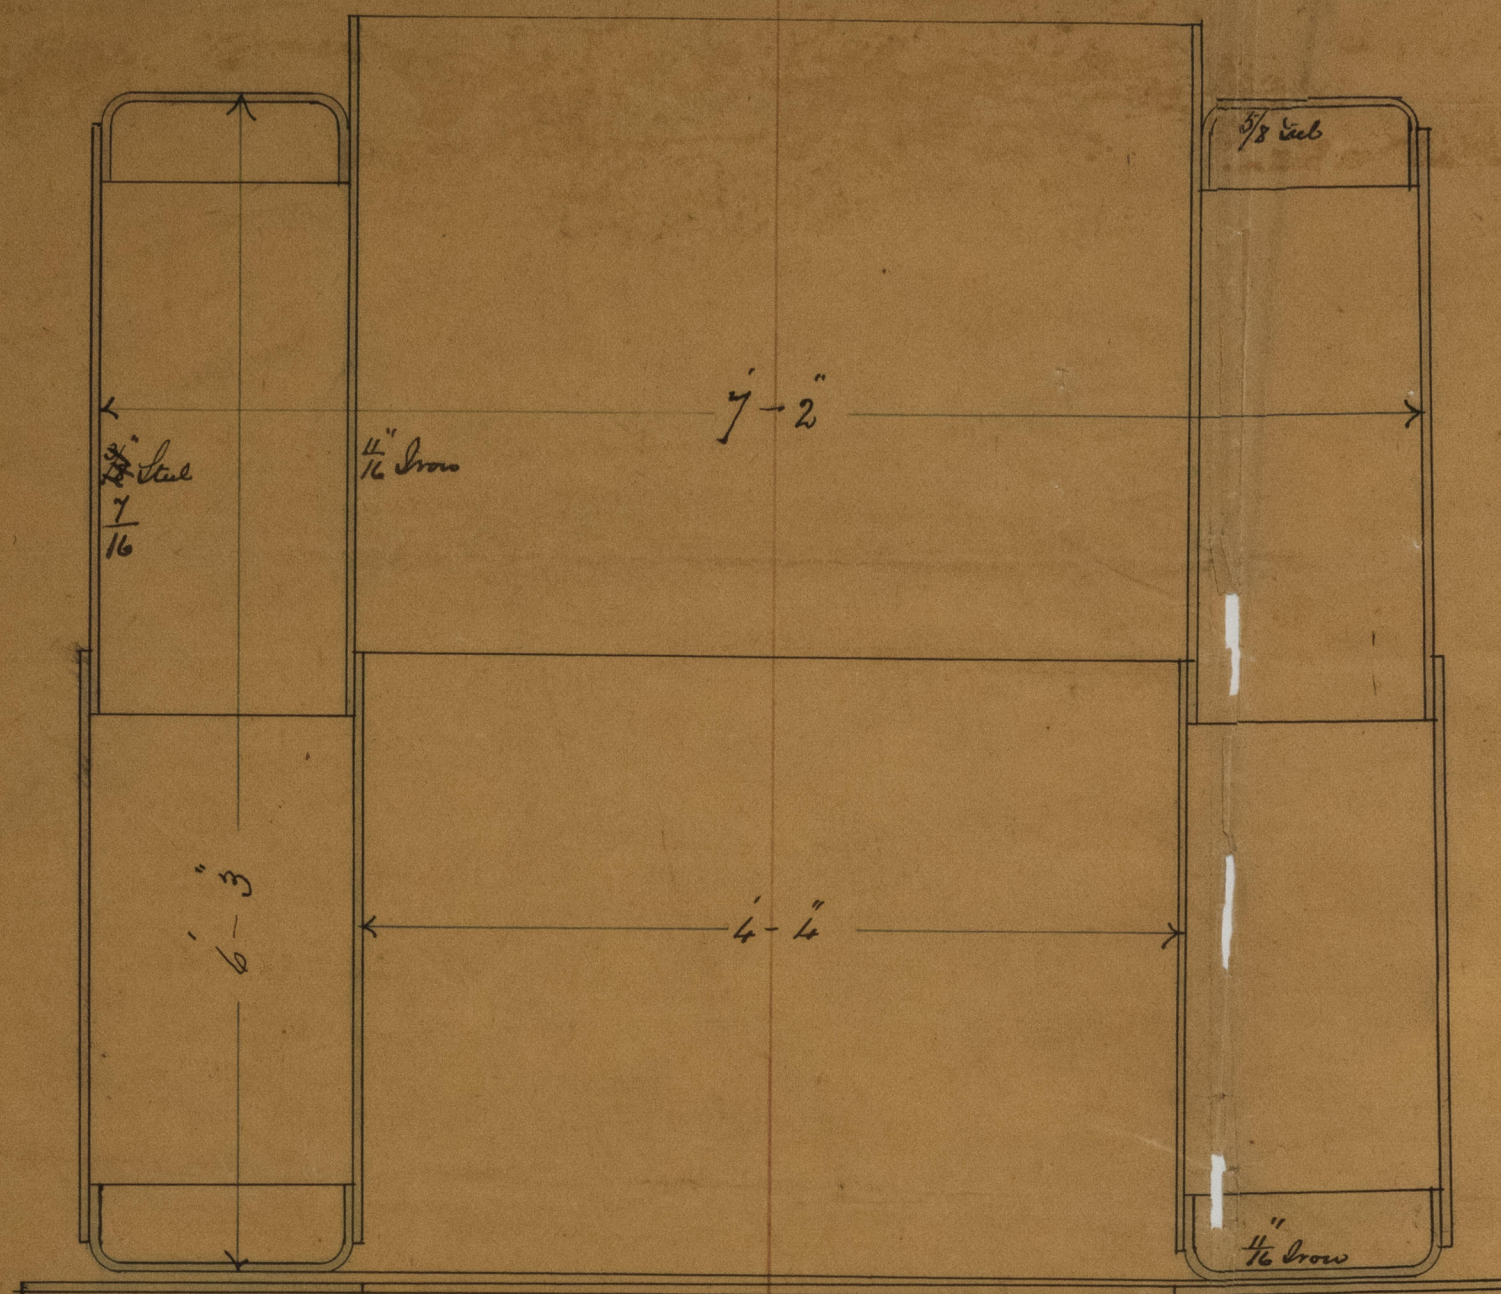

Superheater

Steel rivets in superheater shell 3/4" diam
Vertical seams - lap joints Double riveted 2 3/8" pitch - Drilled
Circum seams - Single riveted 2" pitch Drilled
Vertical seams in flue Double strap fixed & double riveted - Drilled
Rivet straps 3/8" thick

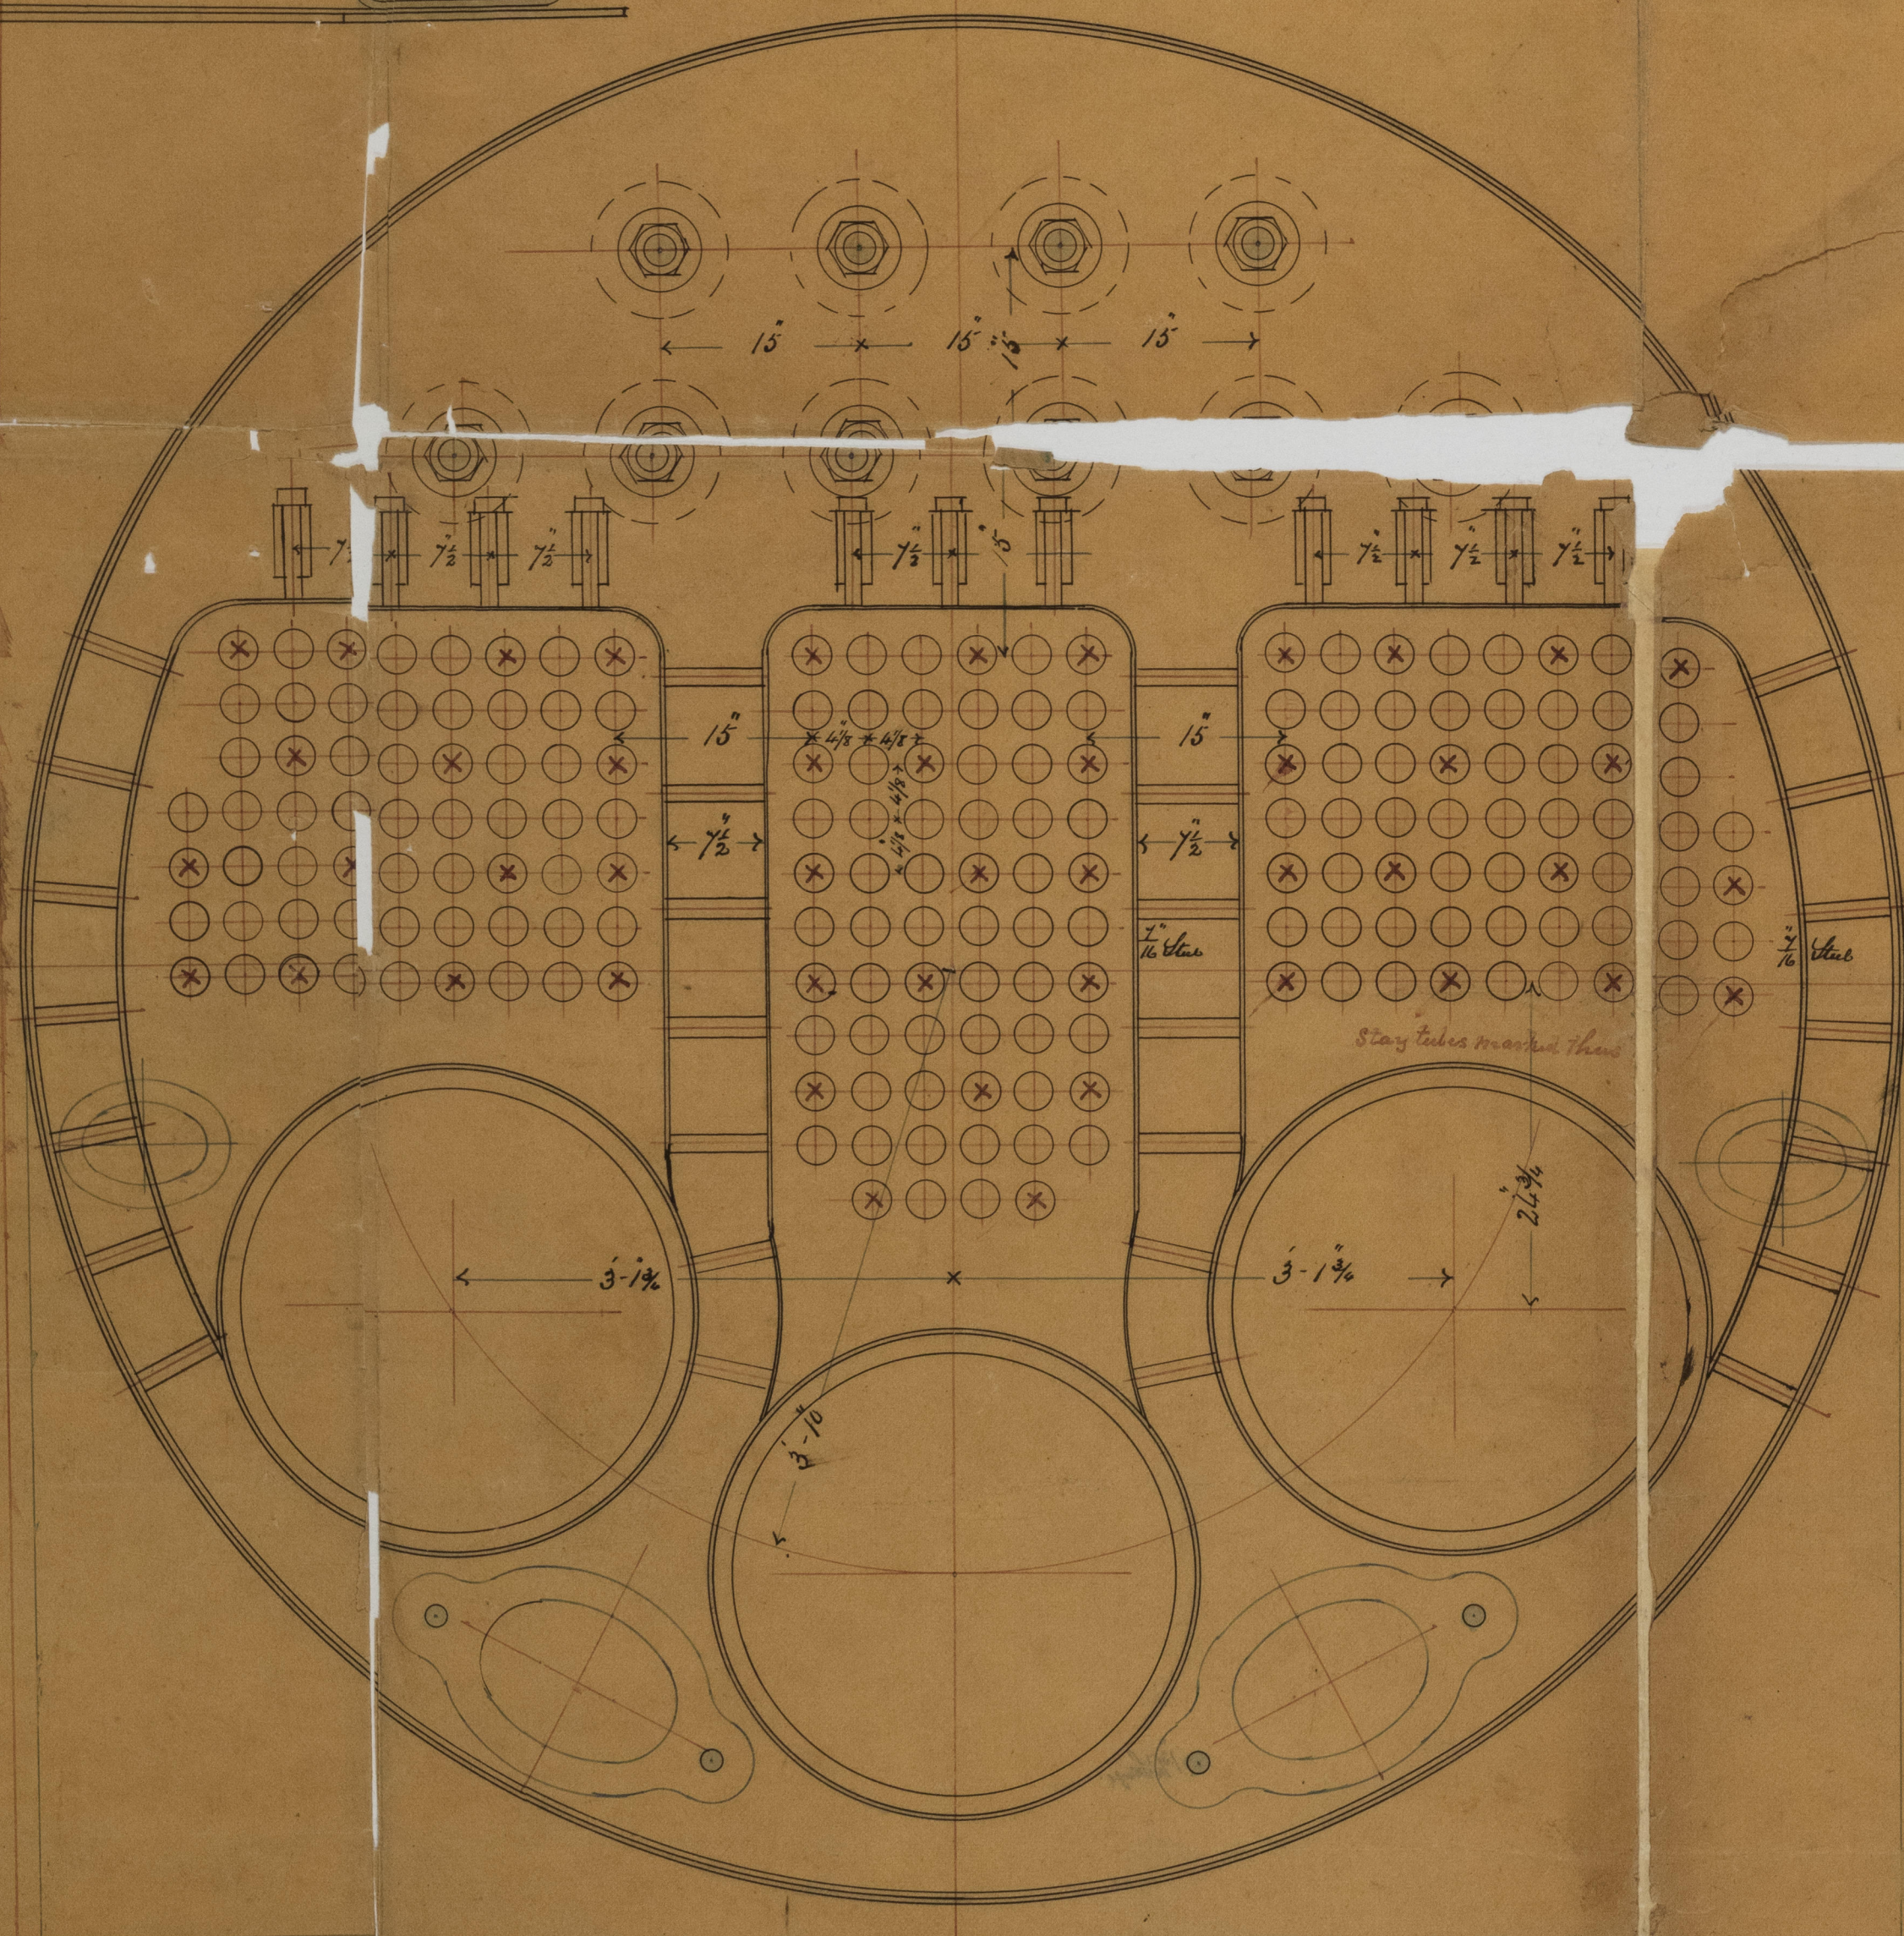


Boilers for S.S. "Courland" - Glasgow Report
Pressure 70 lbs

HARCLAY, CURLE & CO. LIMITED.
STOBROSS ENGINE WORKS,
GLASGOW.

21/7/85

M Glasgow
20/4/85

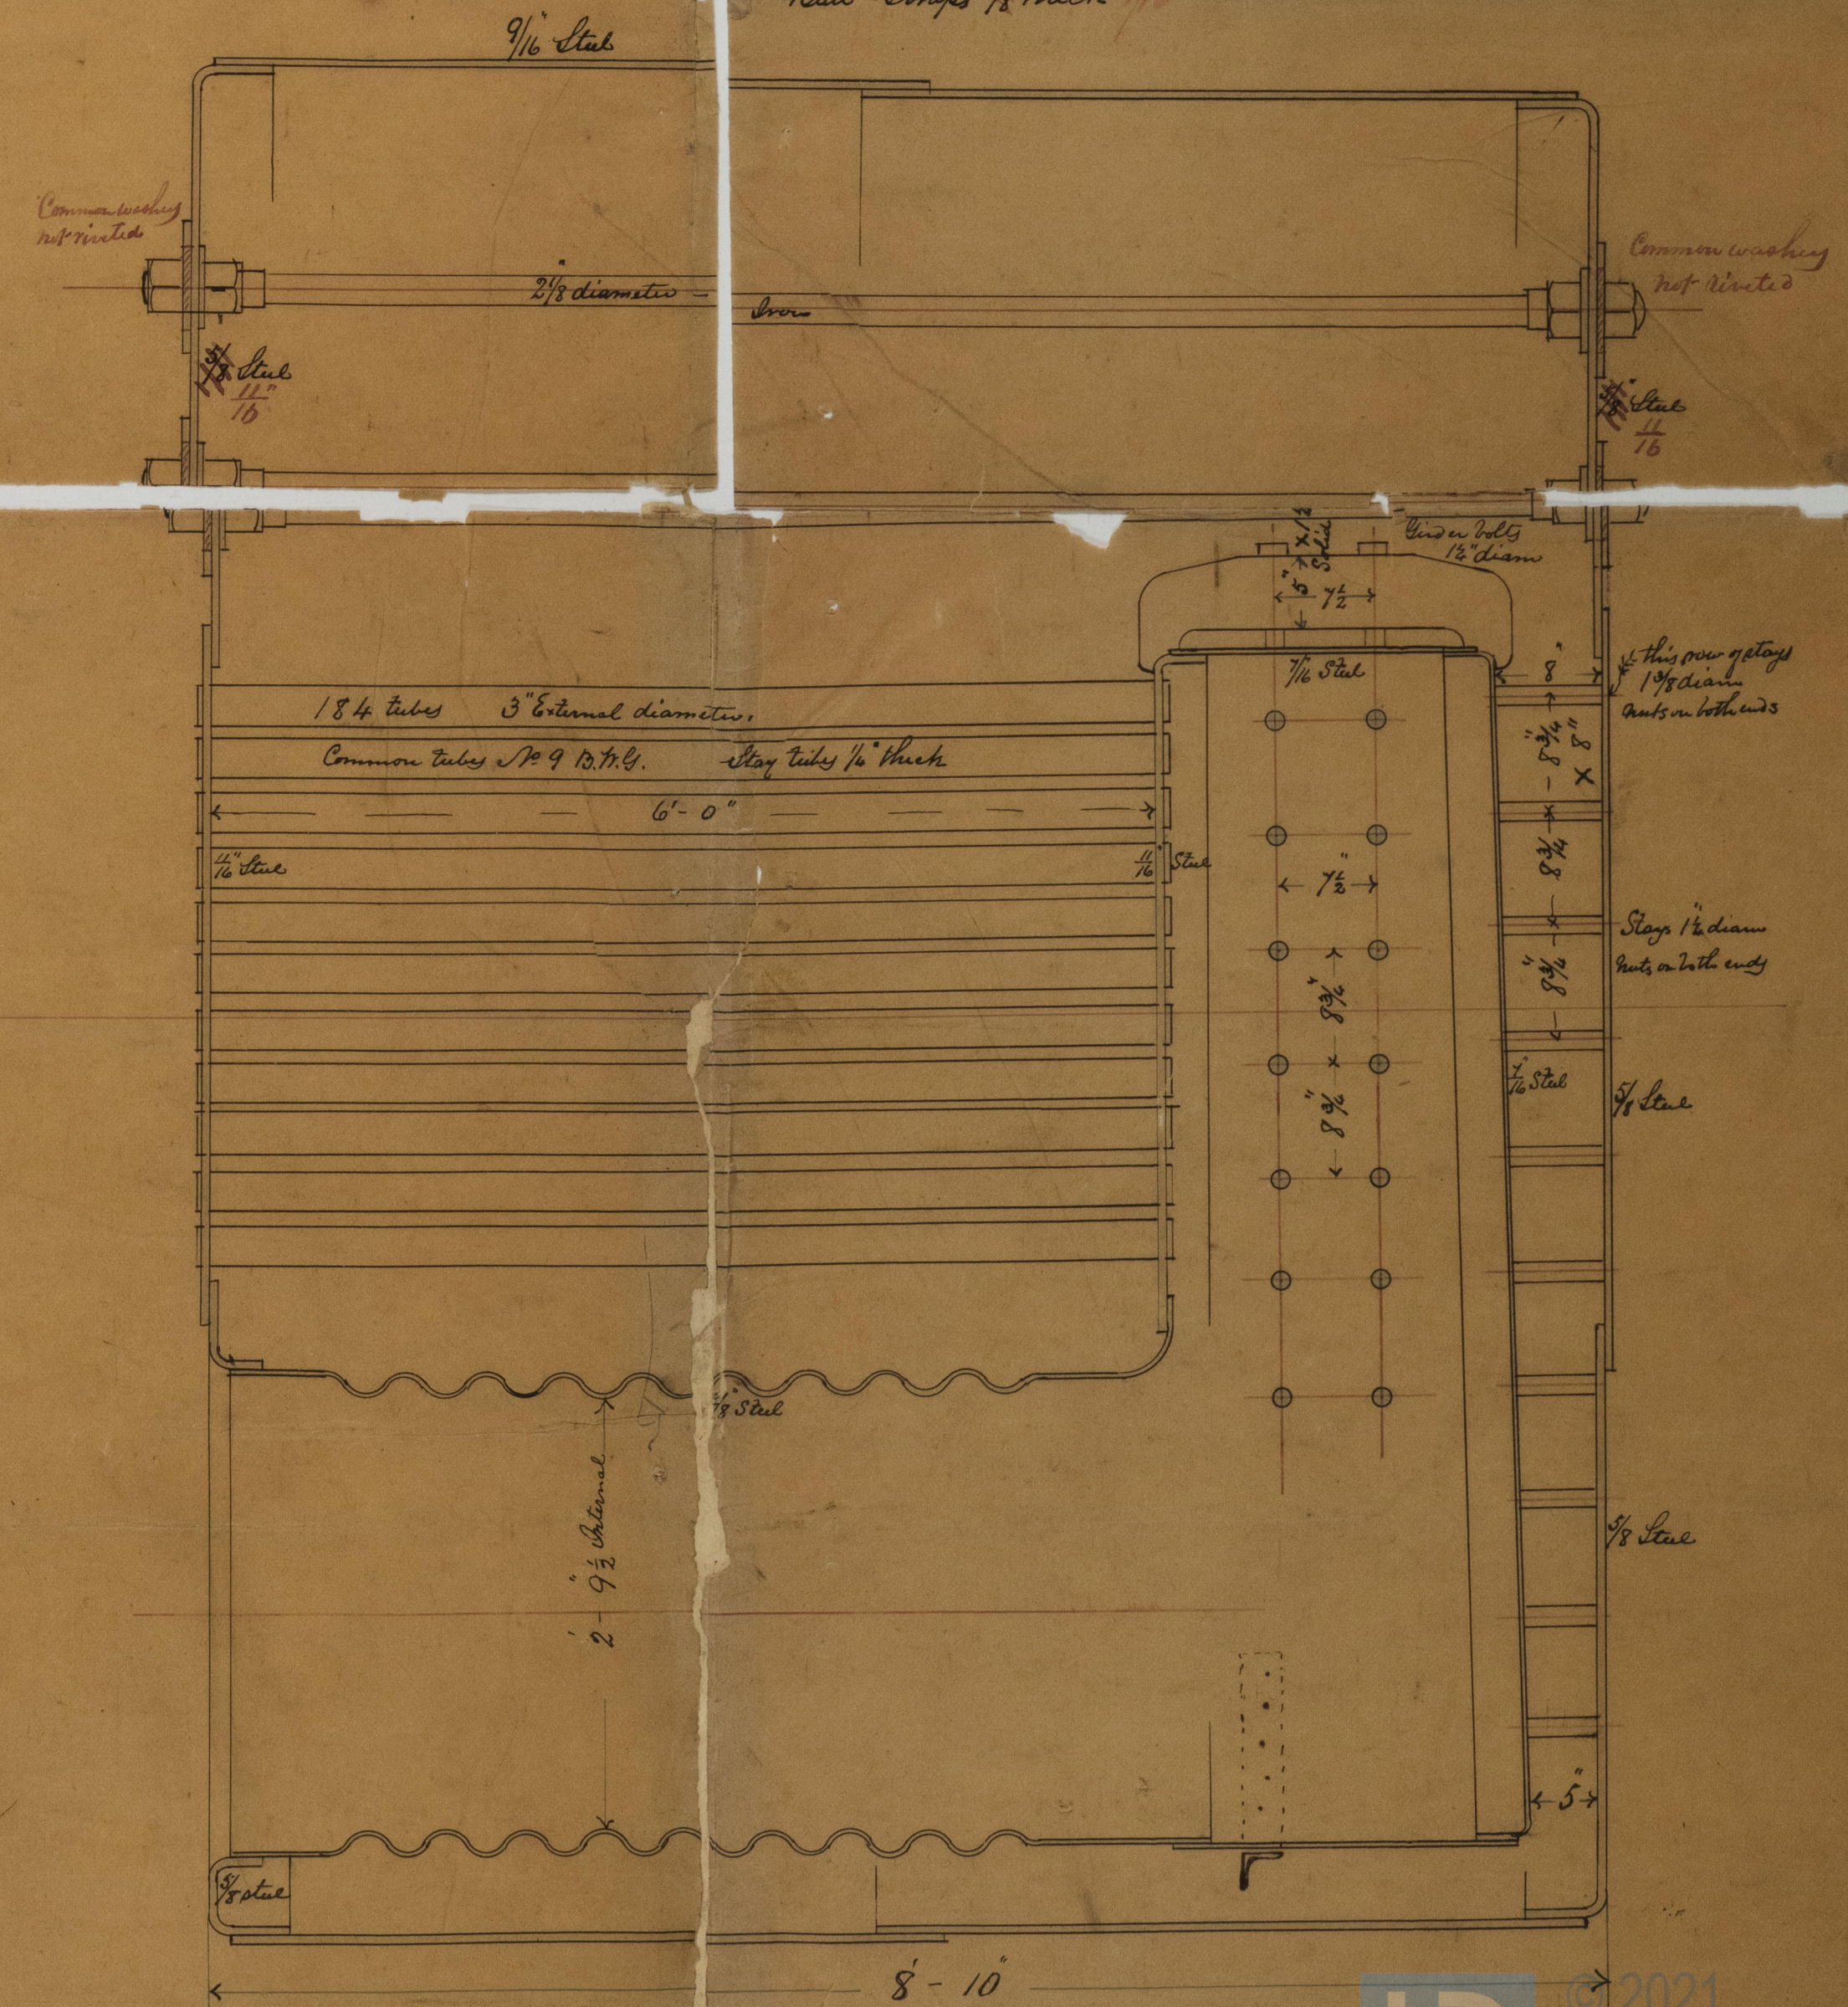

Boiler

Steel rivets in Boiler shell 7/8" diameter
Longitudinal seams Double strap fixed & double riveted 3 3/8" pitch - Drilled
Circum seams - Lap joints Double riveted - Drilled
Rivet straps 3/8" thick