

Lloyd's Register of British and Foreign Shipping.

(Report on Vessel No. 4319 Port Glasgow)

No. 323.A. SHIP FORGINGS OR CASTINGS.

I have to report that the undermentioned Iron or Steel Forgings or Castings, manufactured by

The Darlington Forge Co. of Darlington
for the Vessel No. 400, being built by Messrs R Napier & Sons
of Glasgow have been inspected by me as set forth below, and found
to be, so far as can be seen, sound.

The words FORGINGS or CASTINGS, IRON or STEEL, should be struck out as may be required.


Mark on Forgings.

Lloyd's
No. 323.A.
H.C.

Hugh Cameron
Sunderland

	STERN FRAME. <u>Port</u>	RUDDER FRAME.	STEM.
Material*	<u>Scrap iron</u>	<u>Scrap iron</u>	
How made	<u>Forged</u>	<u>Forged</u>	
Dimensions	<u>8 1/2" x 2 3/4"</u>	<u>4 1/4"</u>	
Progress on Inspection	<u>Forged Smithed</u>	<u>Forged Smithed</u>	<u>Not seen</u>
Dates when Inspected	<u>June 16-19-24/85</u>	<u>Sept 21 Oct 3-8-14-19/85</u>	

SKETCHES OF FRAMES SHEWING POSITION AND DESCRIPTION OF WELDS OF FORGINGS, OR PARTICULARS OF TESTS APPLIED TO CASTINGS.

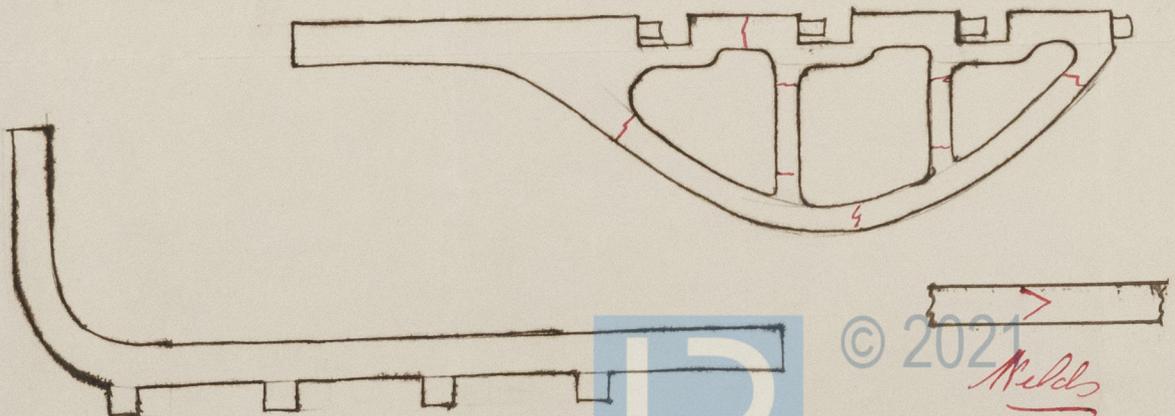

© 2021
Welds
Lloyd's Register
Foundation

* If of Iron, state whether scrap or puddled Iron.