

15311

No 400

Plan shewing dimensions of Masts & Spars.


Scale 1/16" = one foot.

S.S. "Mirror"

Glasgow Report No 4319.

19.11.85.

Prof. W. Napier & Sons
13. Nov 1885

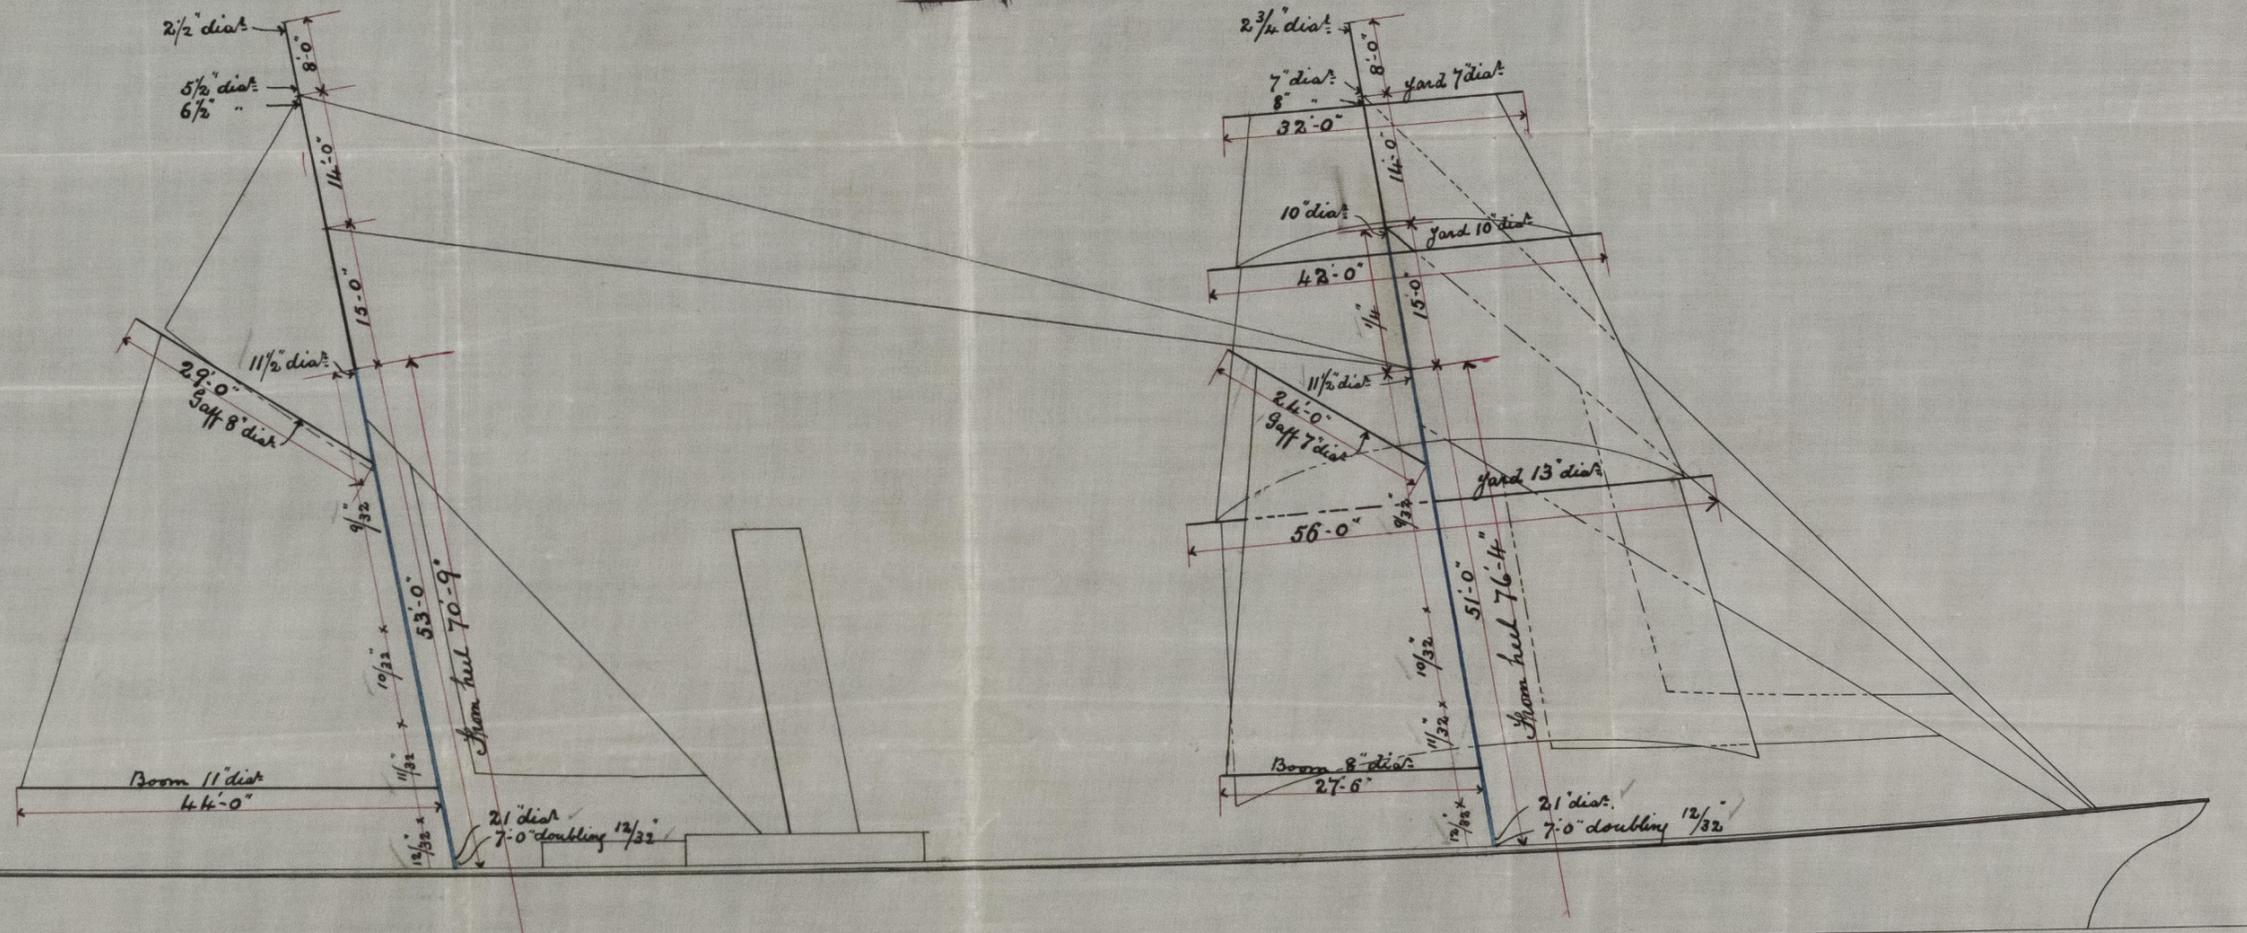

Main Mast steel. 2 plates
in the round - Extreme length 70'-9"

Main Mast 18" dia at heel
10/32 thick.

Steel shown in Blue.
Wood " " Black.

Fore Mast steel. 2 plates
in the round - Extreme length 76'-4"

Fore Mast 15" dia at heel
10/32 thick.

Wm J.L.
18 Nov 85
Sls. 13/11/85



© 2021
Lloyd's Register
Foundation

GLS204-0037