

№4-00

Glasgow Report N^o 4319. —

Twin Screw Steamer ^{of a Steel} for Cable Purposes


to Class 100 A. Spar Deck. Special Survey.

Builders Dimensions.

Length	(between perpendiculars)	250'-0"
Breadth	Moulded	34'-0"
Depth	"	26'-4"

R. Napier Esq
22nd June 1803

25.6.85.
1.8.85

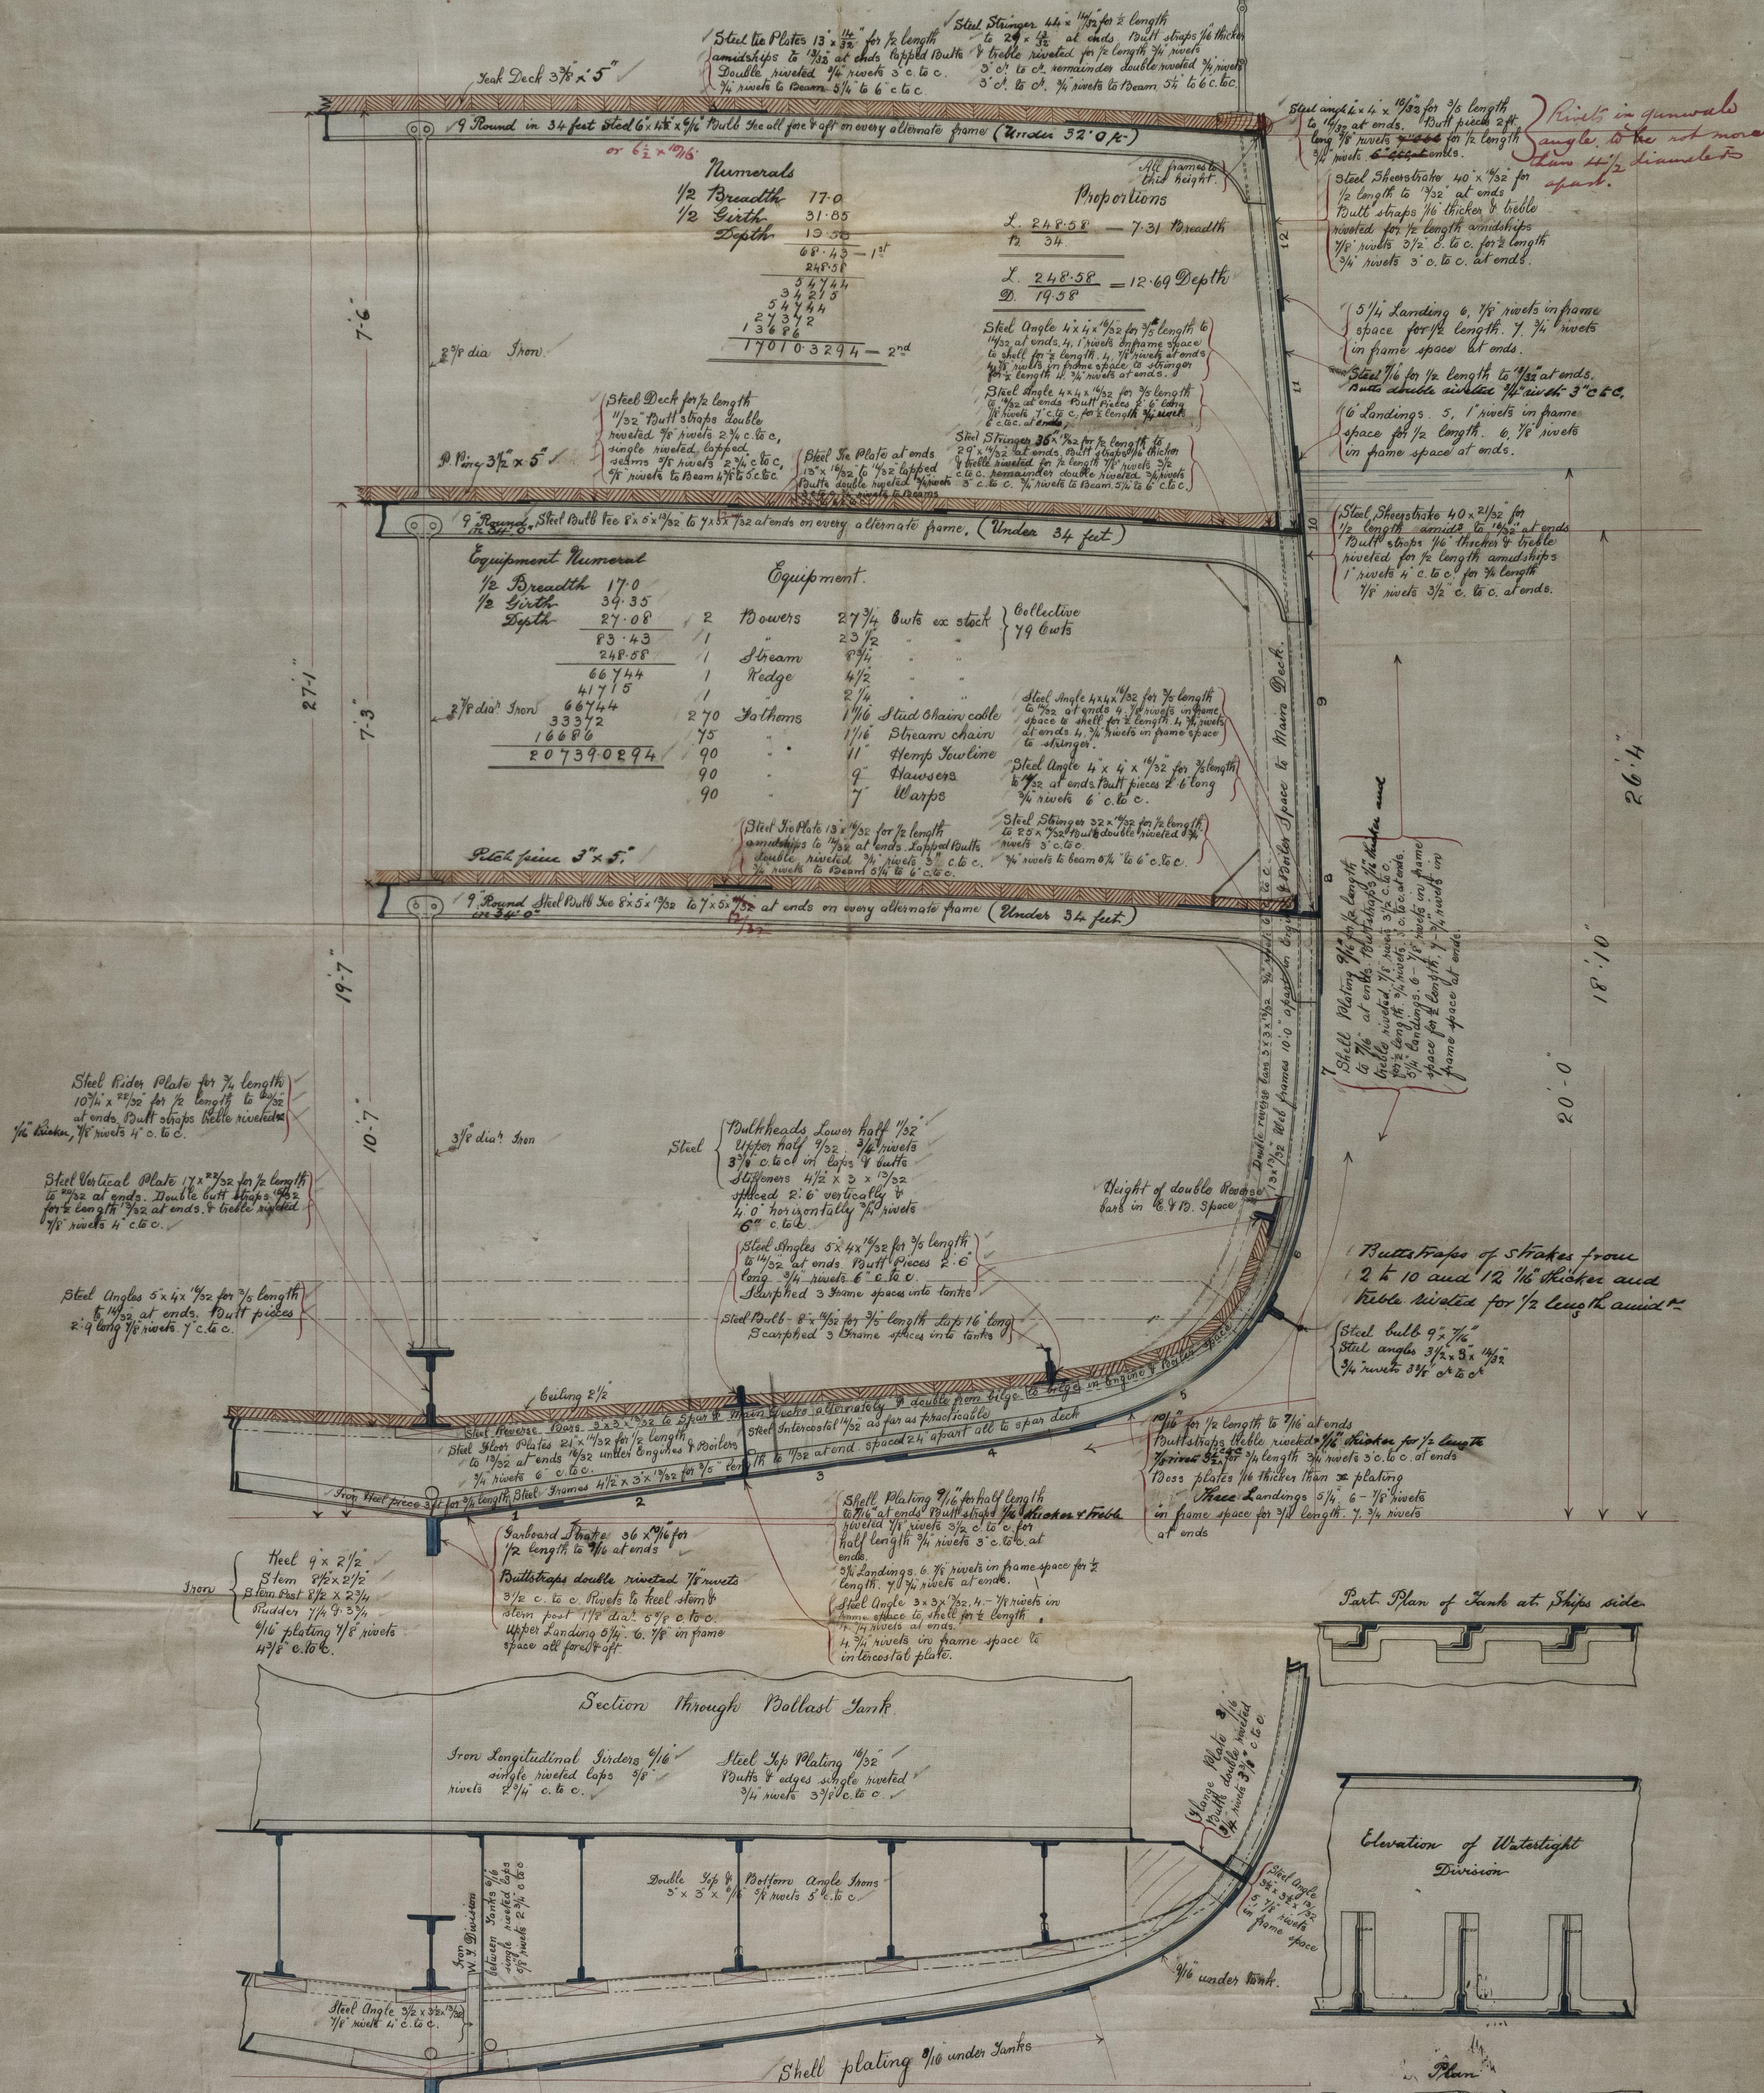

Part Plan of Tank at Ships side.

Elevation of Watertight
Division

Section through Ballast Tank

Shell plating $\frac{3}{16}$ under same

J. L.
Lth. 23/6/85

Diagram illustrating the internal structure of a ship's hull, showing various components and their relative positions:

- Reverse Beams**: Located at the top of the hull structure.
- Centre Line**: The central longitudinal axis of the hull.
- Long Pieces**: Longitudinal structural members running along the length of the hull.
- Reverse Beams (cont.)**: Additional reverse beams located lower in the hull structure.
- Ship**: The overall hull structure.