

N^o 400


14914

1.8.86.


General Arrangement of Bulkheads, Keelson &c

Scale 1/8" = one foot.
 W. H. Phipps & Co
 28/7/85

S. S. "Mirror"
 Glasgow Report No. 4319.

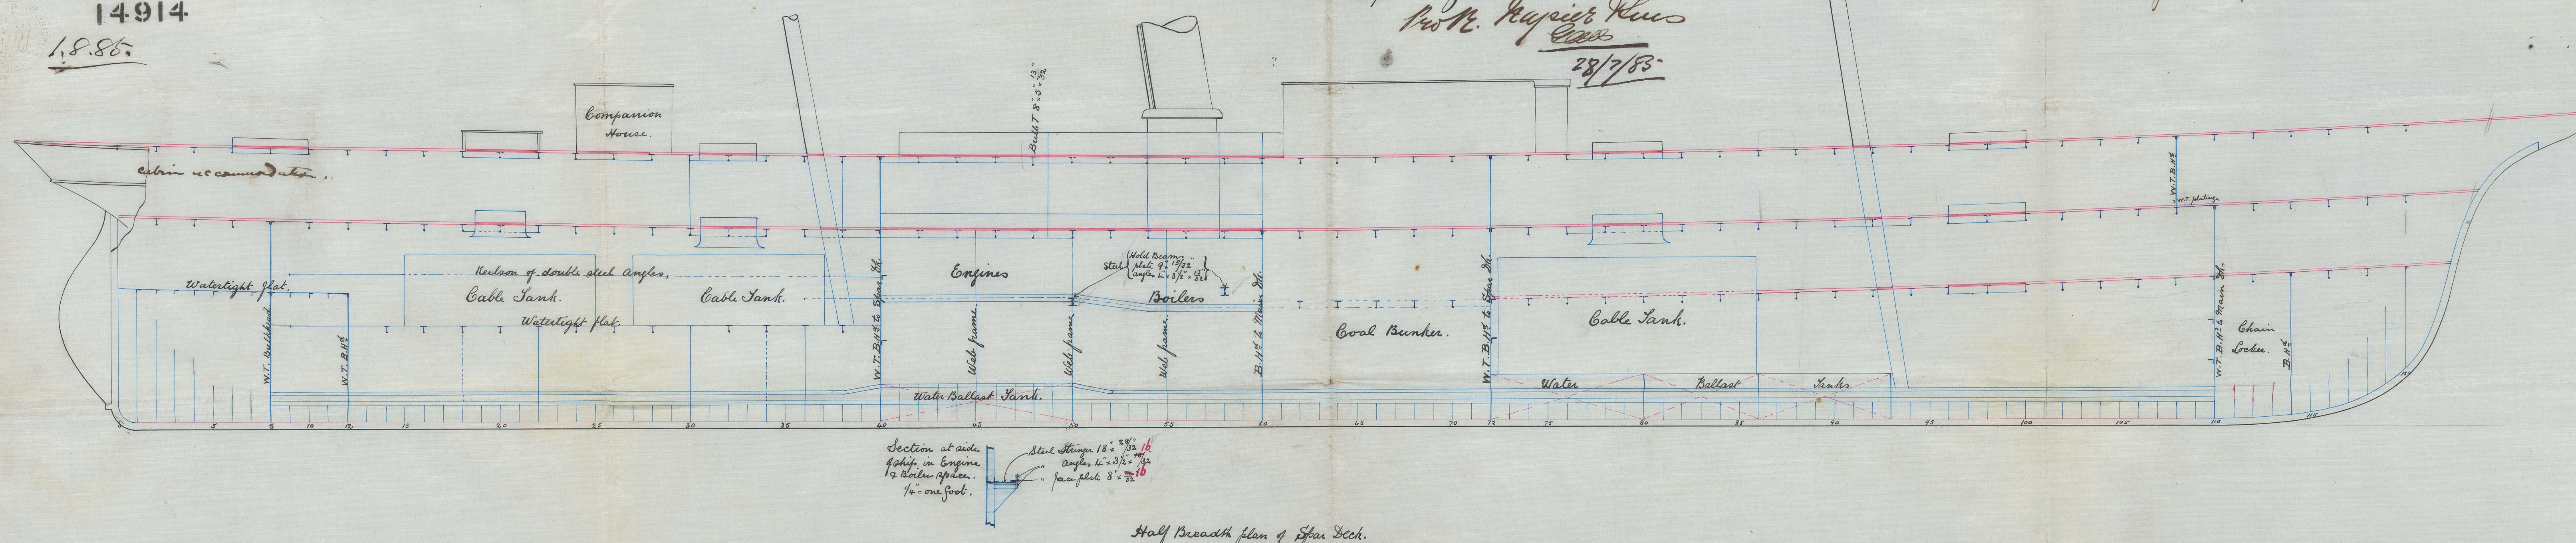


Half Breadth plan of Upper Deck.

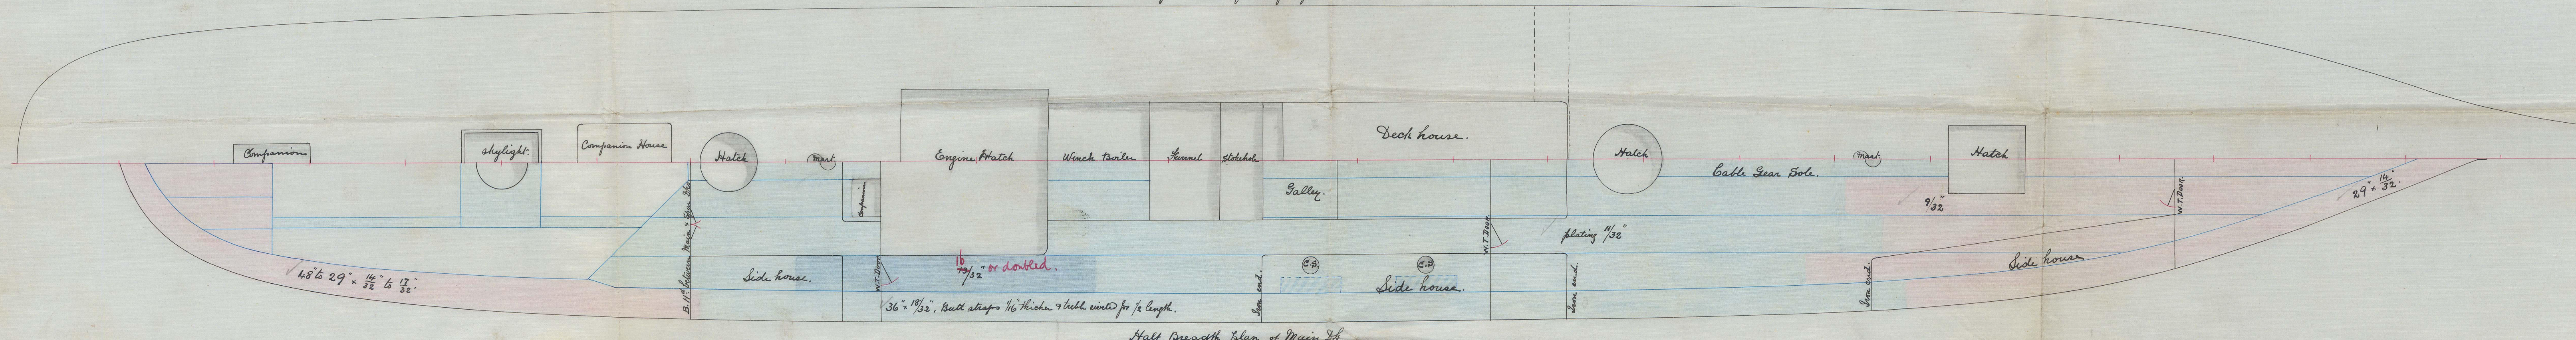

Half Breadth plan of Main Deck.

Half Breadth plan of Lower Deck.

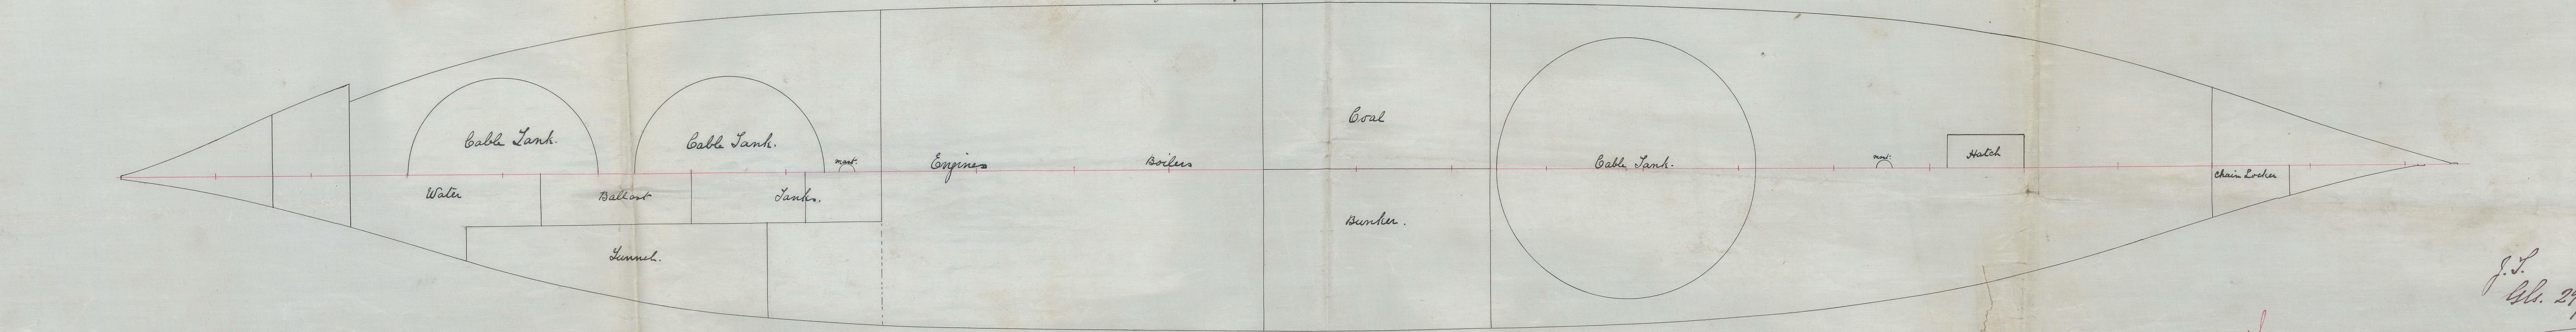

Half Breadth plan of Lower Deck.

J. L. 29/4/85

J. L. 29/4/85