

# Lloyd's Register of British and Foreign Shipping.

(Report on Vessel No. 4320 Port Glasgow)

No. 1092

## SHIP FORGINGS OR CASTINGS.

I have to report that the undermentioned Iron ~~or Steel~~ Forgings ~~or Castings~~, manufactured by The Portland Forge Co of Kilmarnock for the Vessel No. 268, being built by Messrs A. McMillan & Son of Dumbarton have been inspected by me as set forth below, and found to be, so far as can be seen, sound and efficient.

The words FORGINGS or CASTINGS, IRON or STEEL, should be struck out as may be required.

Mark on Forgings.

**Lloyd's**  
No. 1092  
G. N.


George Newcomb

Glasgow

26/8/85.

	STERN FRAME.	RUDDER FRAME.	STEM & Keel
Material*	<u>Scrap iron</u>	/	<u>Scrap iron</u>
How made	<u>Forged</u>		<u>Forged</u>
Dimensions	<u>9 x 2 1/2</u>		<u>9 x 2 1/2</u>
Progress on Inspection	<u>Forging &amp; smithing</u>		<u>Forging &amp; completed</u>
Dates when Inspected	<u>24.30/7/85.</u> <u>14.26/8/85.</u>		<u>16.24/7/85.</u> <u>14.25/8/85.</u>

SKETCHES OF FRAMES SHEWING POSITION AND DESCRIPTION OF WELDS OF FORGINGS, OR PARTICULARS OF TESTS APPLIED TO CASTINGS.

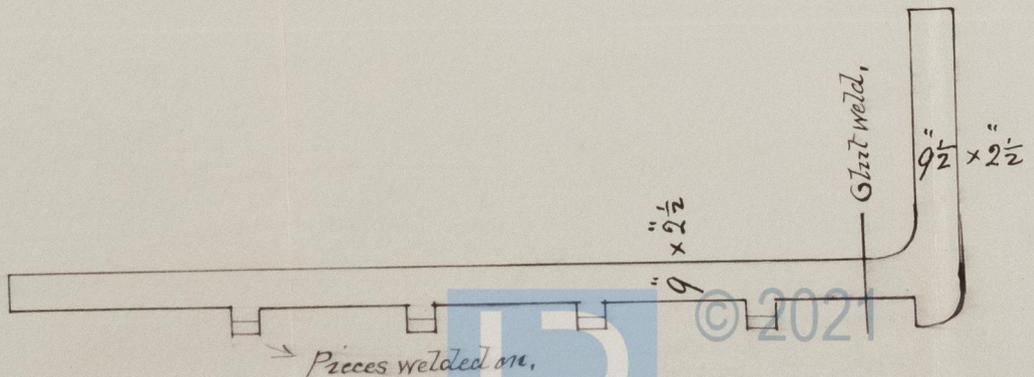

\* If of Iron, state whether scrap or puddled Iron.