

Lloyd's Register of British and Foreign Shipping.

(Report on Vessel No. 4320 Port Glasgow)

No. 1092

SHIP FORGINGS OR CASTINGS.

I have to report that the undermentioned Iron or ~~Steel~~ Forgings or Castings, manufactured by The Portland Forge Co of Kilmarnock, for the Vessel No. 268, being built by Messrs A. Mc Millan & Son of Dumbarton have been inspected by me as set forth below, and found to be, so far as can be seen, sound and efficient.

The words FORGINGS or CASTINGS, IRON or STEEL, should be struck out as may be required.

Mark on Forgings.


Lloyd's
No. 1092
G. N.

George Newcomb
Glasgow

9/12/85.

	STERN FRAME.	RUDDER FRAME.	STEM.
Material*	/	Scrap iron	/
How made		Forged.	
Dimensions		6 1/2 & 3 1/2	
Progress on Inspection		Forging & smithing	
Dates when Inspected		14.25/8/85. 7.14.21/9/85. 12/10/85. 1.7/12/85.	

SKETCHES OF FRAMES SHEWING POSITION AND DESCRIPTION OF WELDS OF FORGINGS, OR PARTICULARS OF TESTS APPLIED TO CASTINGS.

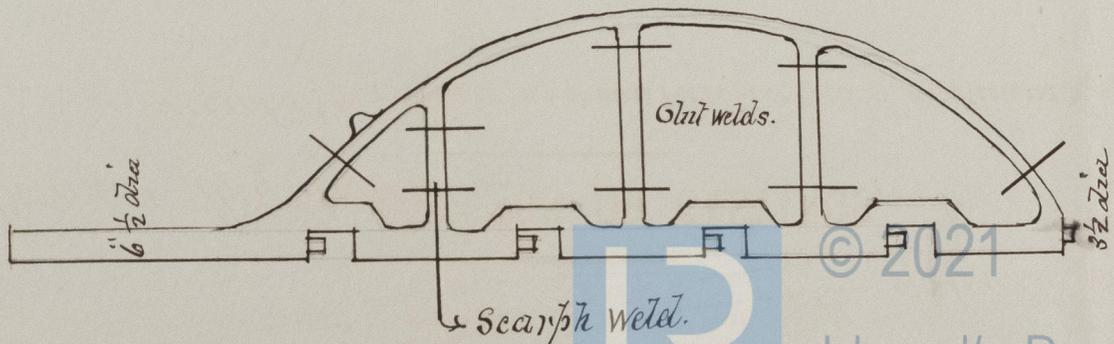

* If of Iron, state whether scrap or puddled iron.