Ship "Marion Inglis" Glasgow Report No 4435

As built

Rules 1885.

LLOYD'S REGISTER OF SHIPPING
RECEIVED
14 FEB 86
LONDON

Midships Section of Ship No 271.

To Class ✠100 A1 Steel at Lloyds

Scale ½" = 1 foot.

Steel Scantlings in Red.

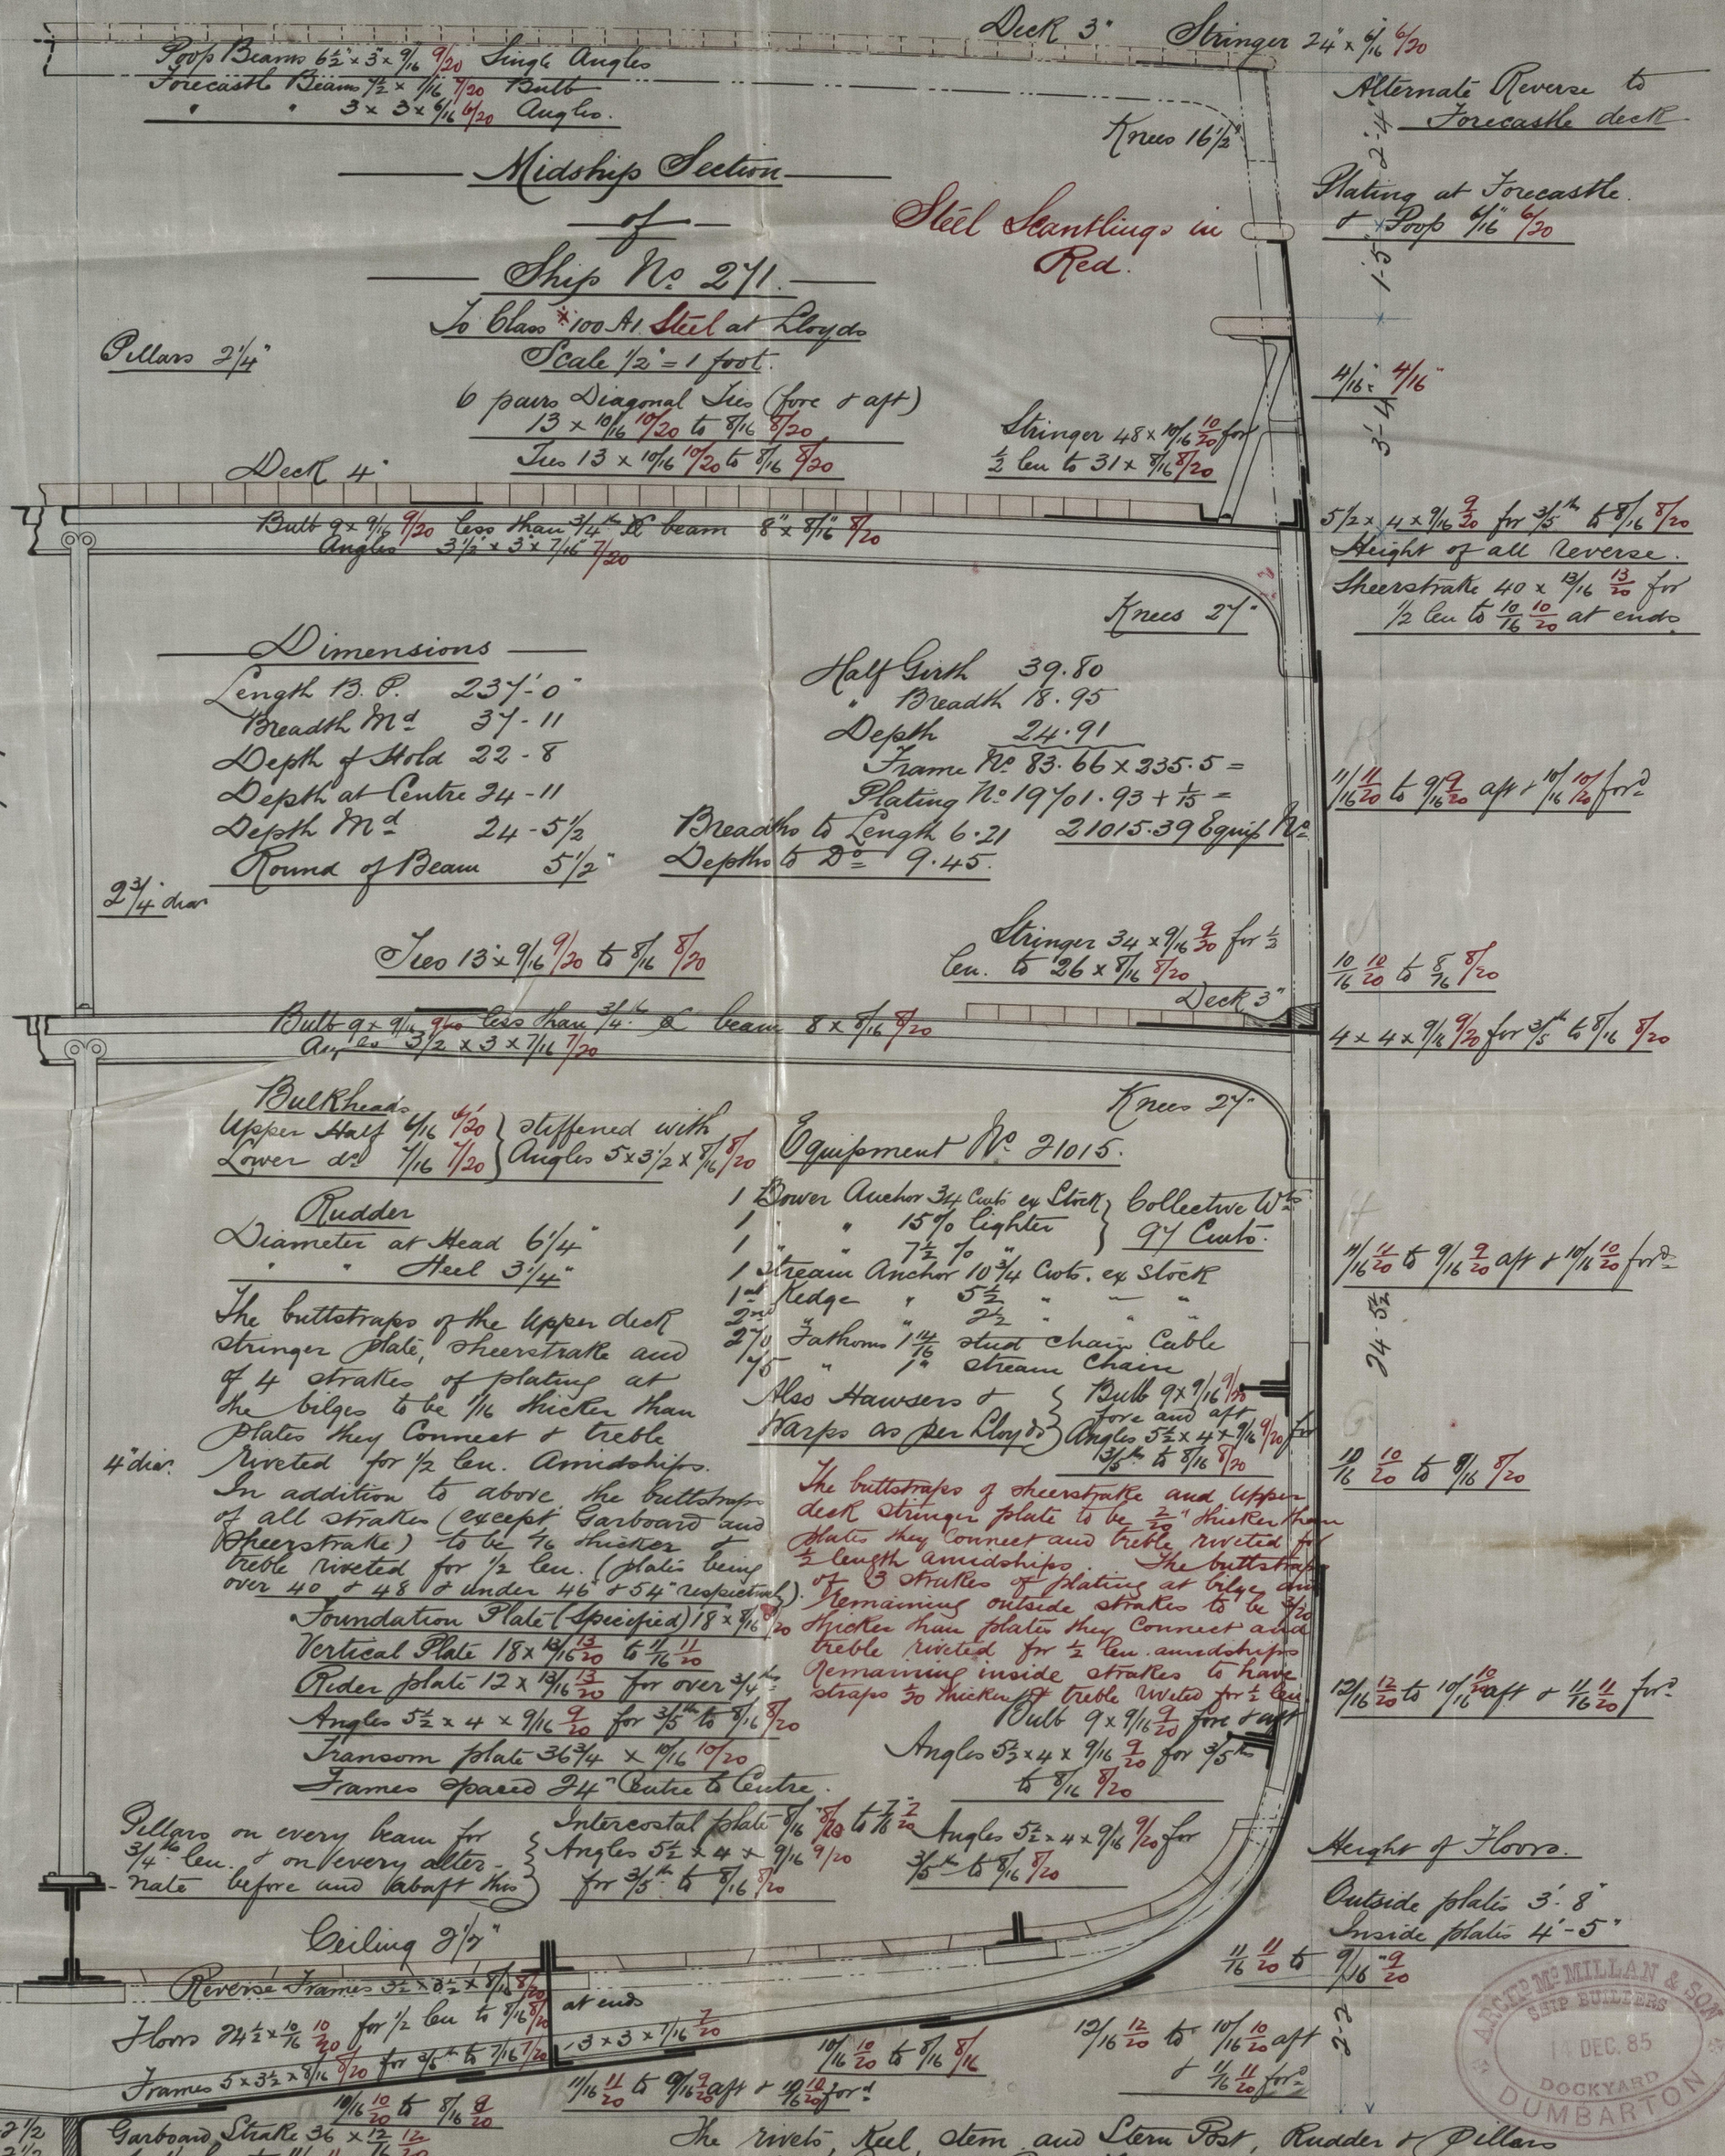

Dimensions

Length B.P.	237'-0"
Breadth Mld	37'-11"
Depth of Hold	22'-8"
Depth at Centre	24'-11"
Depth Mld	24'-5½"
Round of Beam	5½"

Equipment No 21015.

1 Bower Anchor	3¼ Cwts ex Stock
1 "	15% Lighter
1 "	7½ %
1 Stream Anchor	10¾ Cwts. ex Stock
1 Kedge "	5½ " " "
270 Fathoms	1 14/16 stud chain Cable
45 "	1" Stream Chain
Also Hawsers & Warps as per Lloyds	

Collective Wt 97 Cwts.

The buttstraps of sheerstrake and upper deck stringer plate to be 2/20" thicker than plates they connect and treble riveted for ½ length amidships. The buttstraps of 3 strakes of plating at bilges and remaining outside strakes to be 1/20 thicker than plates they connect and treble riveted for ½ len. amidships. Remaining inside strakes to have straps 1/20 thicker & treble riveted for ½ len.

The rivets, Keel, stem and Stern Post, Rudder & Pillars Hatchway Combgs, Poop, Forecastle & Deck erections to be iron.

ARCH.D McMILLAN & SON
SHIP BUILDERS
14 DEC. 85
DOCKYARD
DUMBARTON

approved J. Ford
15 Dec 1885.
See letter of this date.

© 2021 Lloyd's Register Foundation

GLS204-0106