

Nº 341

Ship "Bannockburn" Glasgow Report N<sup>o</sup> 4481.

SCALE  $\frac{1}{2}$  INCH TO A FOOT

SCANTLINGS TO CLASS 100 A AT LLOYDS.

Short full Poop & Topgallant Forecastle

Dimensions by Lloyds Length 242.42' x D 42.25' x D 26.50'

Half Girth. 42.25

• Breadth. 21.12

Depth . 26.50

$89.84 =$  Numeral

Length  $272.42' \times 89.84 = 24482.38$  - Numeral


add  $\frac{1}{15}$  =  $1632 \cdot 15$

26114 '53 = Equipment humeral

# Proportions

Beams 6'44

Depth 10.33

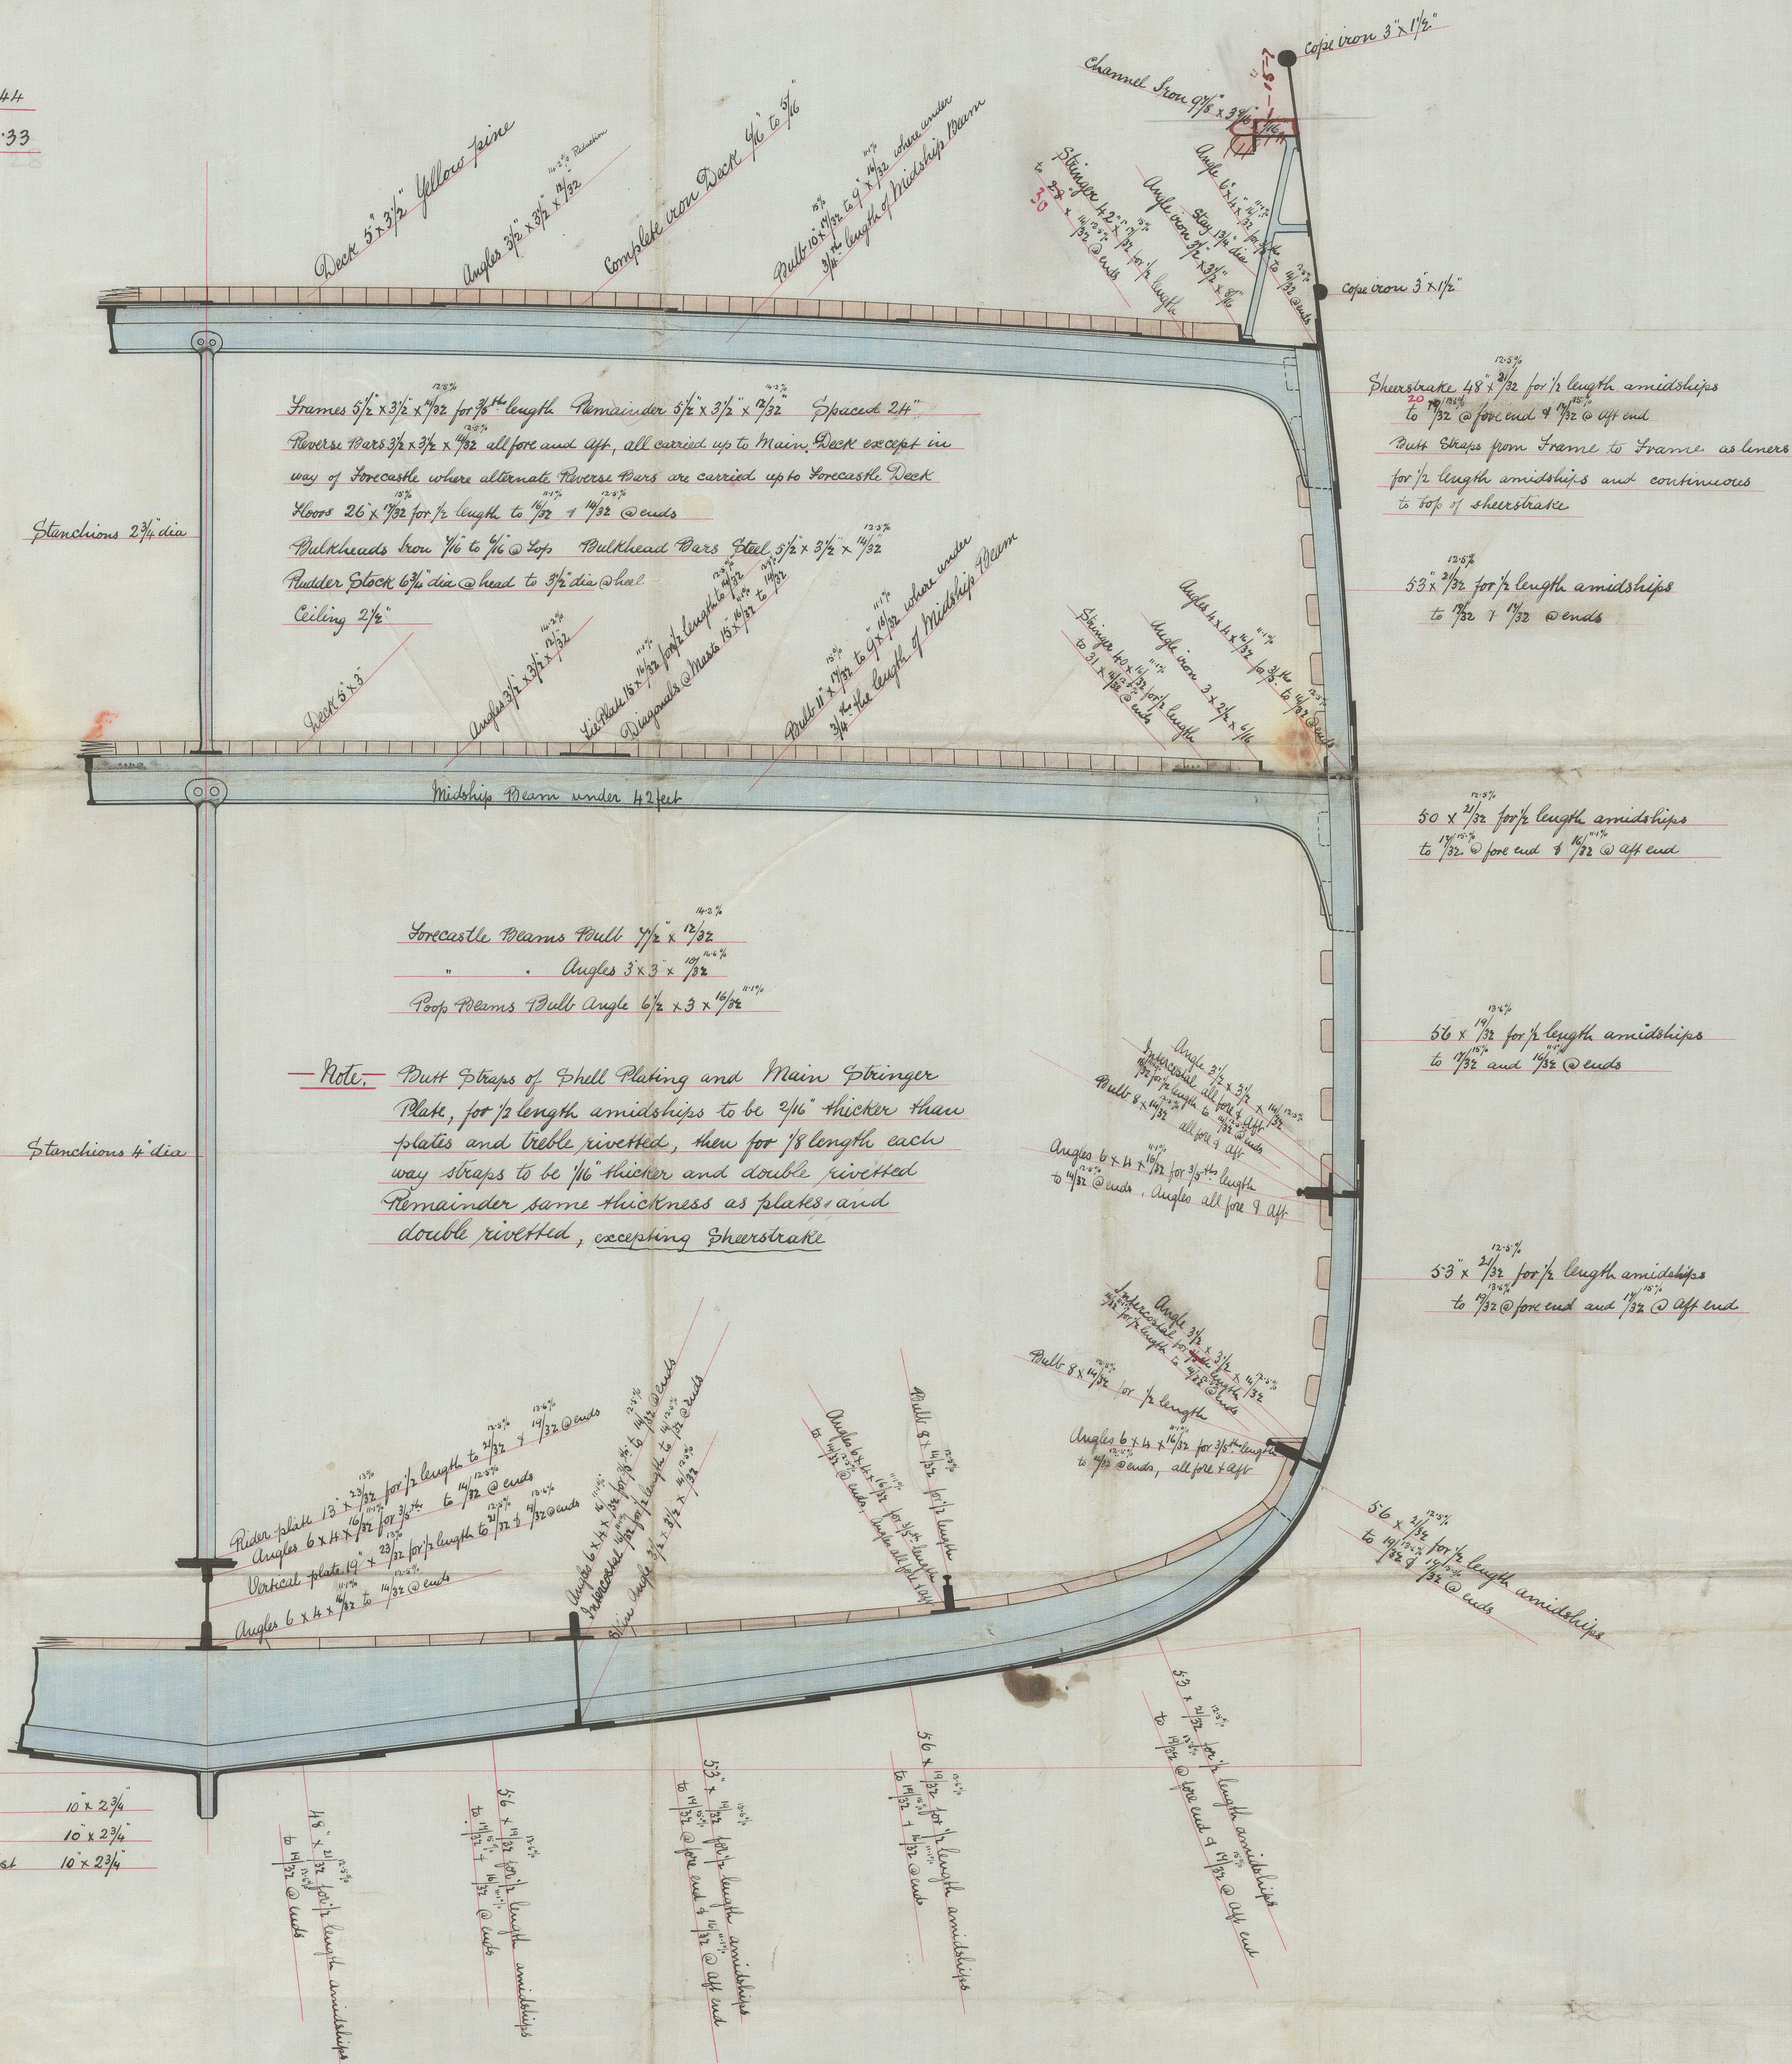

— Note, Percentage of Reduction from size in iron is marked above scantlings

28  
10/83

May 21 10 85  
C. F.