

RECEIVED  
-6 JAN. 86  
LONDON

Ship "County of Roxburgh"  
Glasgow Report No. 4523.—

12/2/85.

## MIDSHIP - SECTION - OF - SHIP

Nº - 3 43

Scale  $\frac{1}{2}'' = 1$  Foot.

Scantings to Floyds for 100 A class

Dimensions by Lloyd - Length 242.5 - B. 43.25 - D 26.75

Half Breadth = 21.63

Girth = 43.00

Depth = 26.45

91.38 = Numeral.

Length  $242.5 \times 91.38 = 24901.05$

Add  $\frac{1}{15} = 1660.04$

26561.12 = Equipment Numeral.



Equipment - Numeral = 96541.12

3 Bower Anchors 114 Cwts Collective weight. Elx Stock

1 Stream anchor 12 " c + Stock

1 Kedge

1 Kedge

240 Fathoms Steel chain cable  $2\frac{1}{8}$   $4\frac{5}{16}$  Tons Admiralty Test  
100 Shaggs 12 1/2

100 .. Stream .. 1 <sup>2</sup>/<sub>16</sub>

90 " Towline 12"


90 Warps 11"

90 " Warp 4"

## Proportions

FB earns 6.30

Depths 10.18

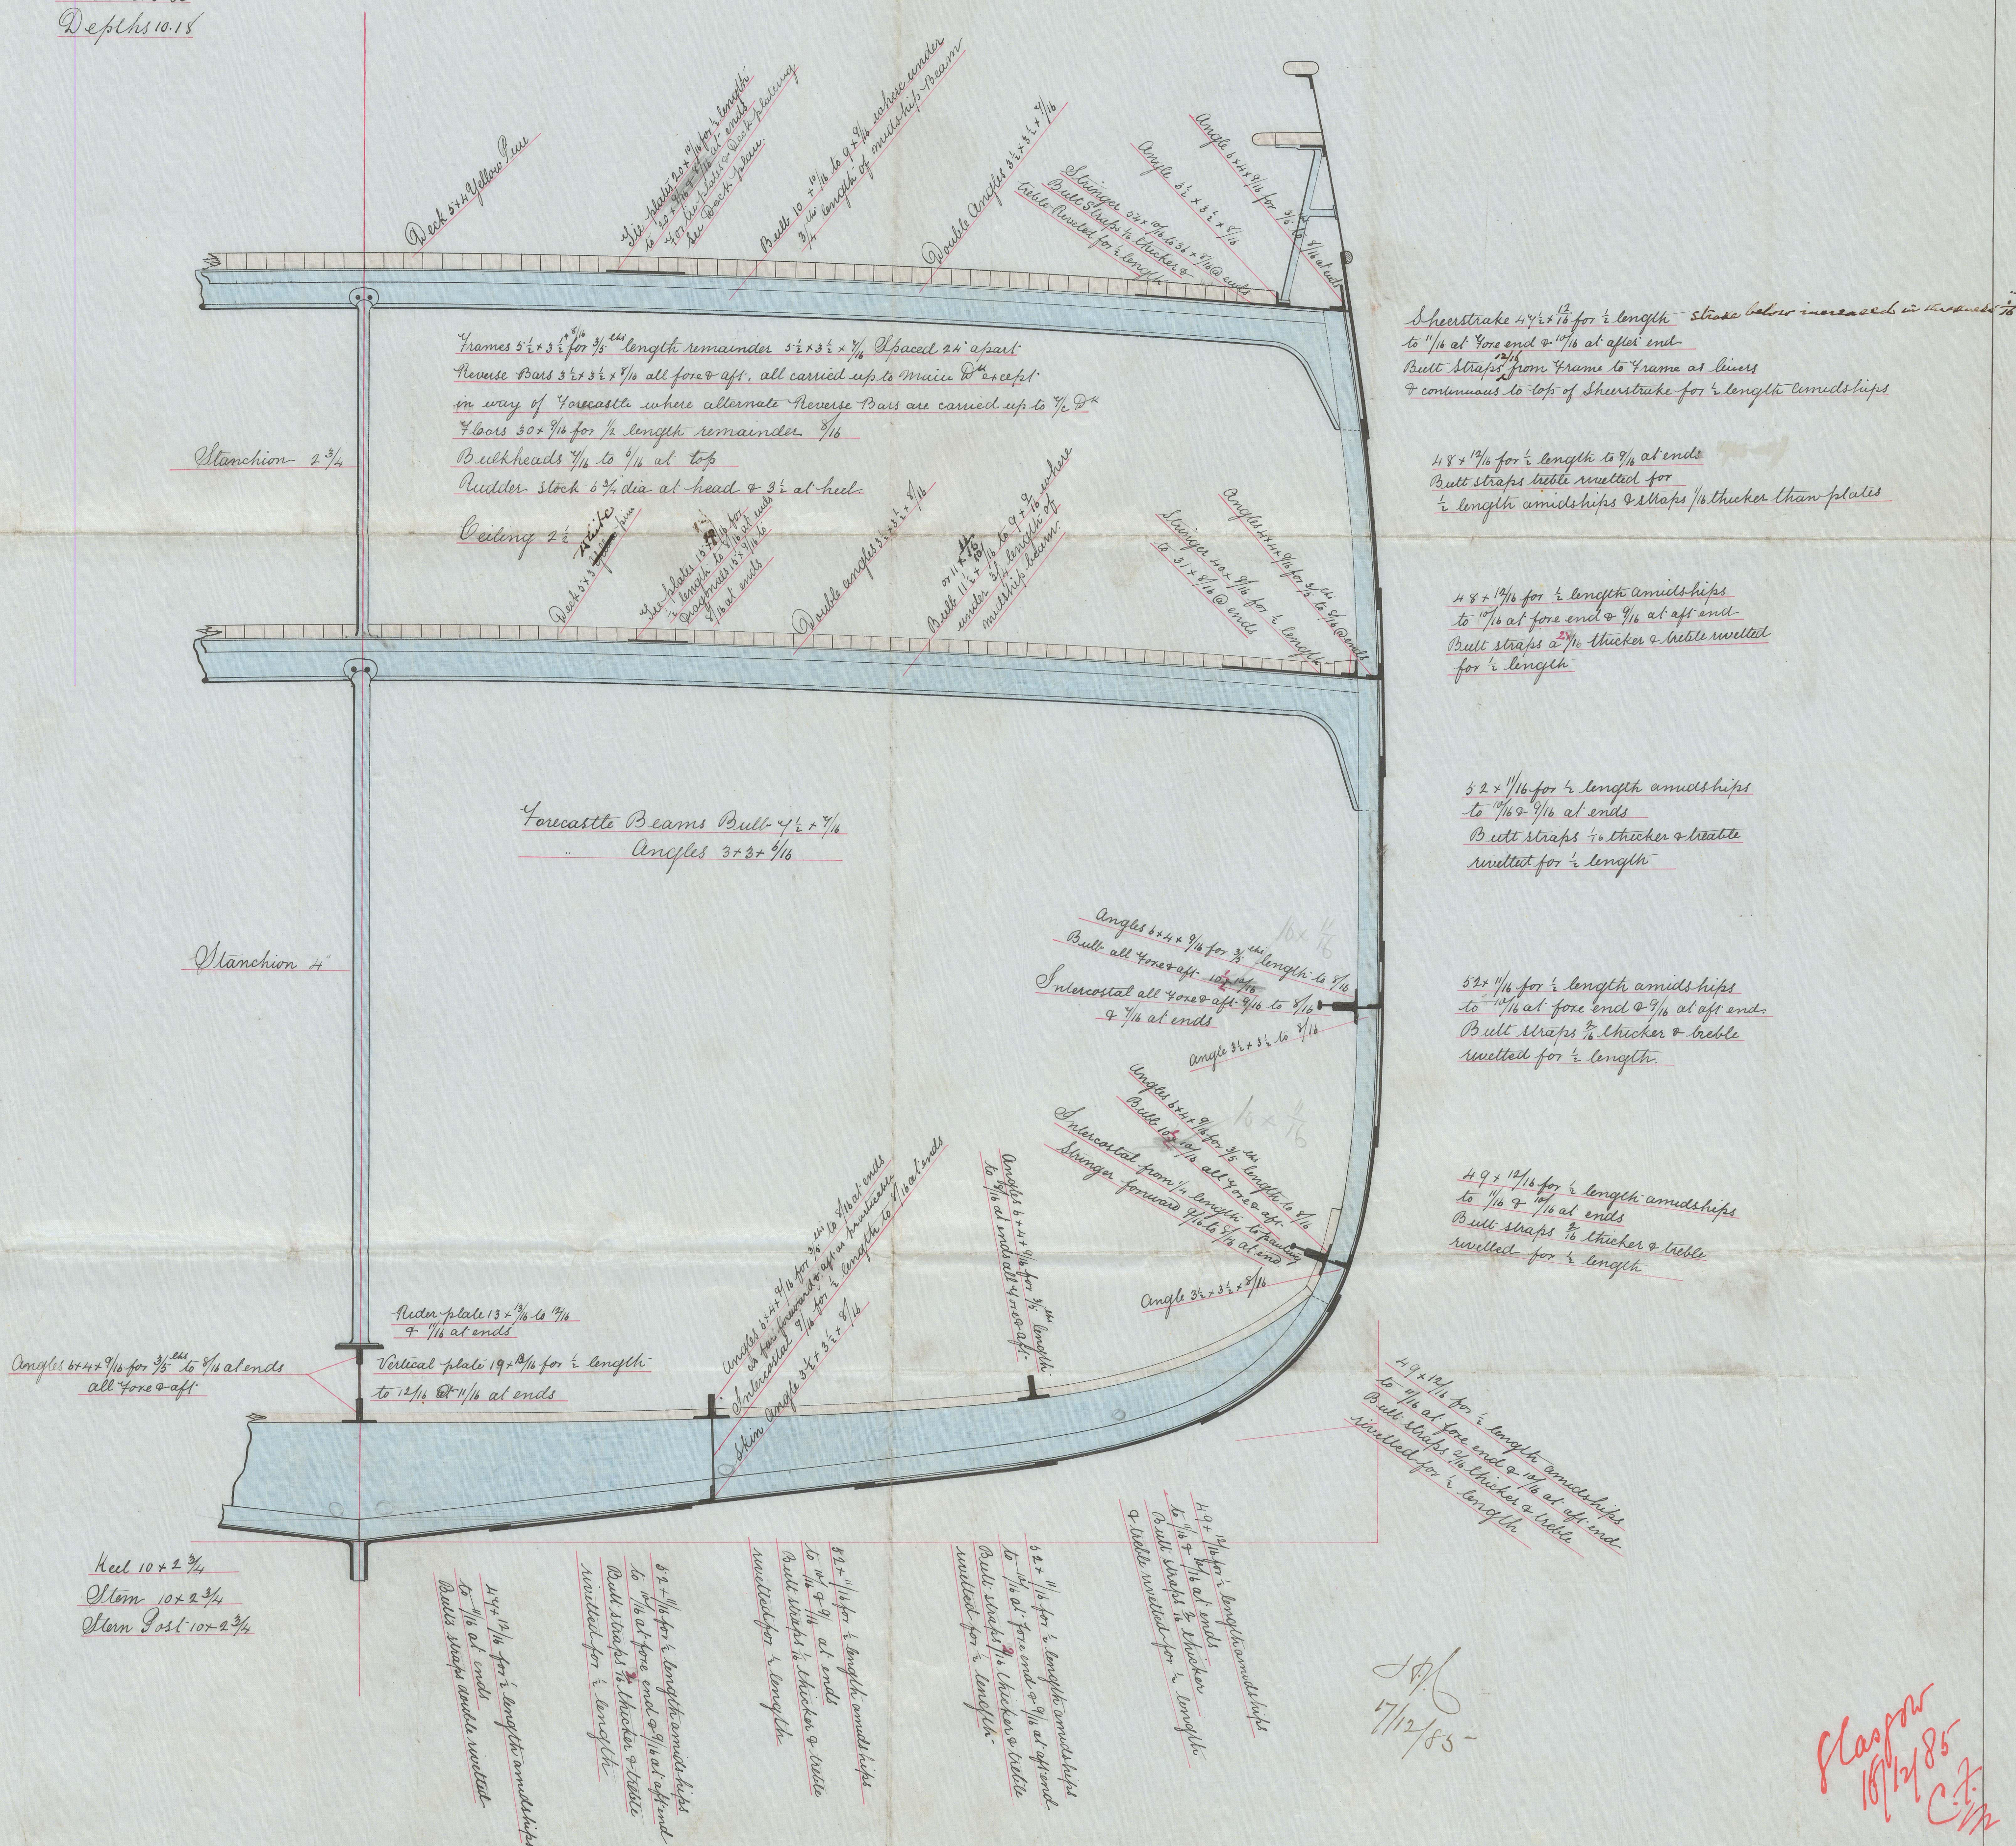

Glasgow  
16/12/85  
C.F.