





S.S. "Medway" Glasgow Report No 4530.-

LOWER DECK

5/1/86.

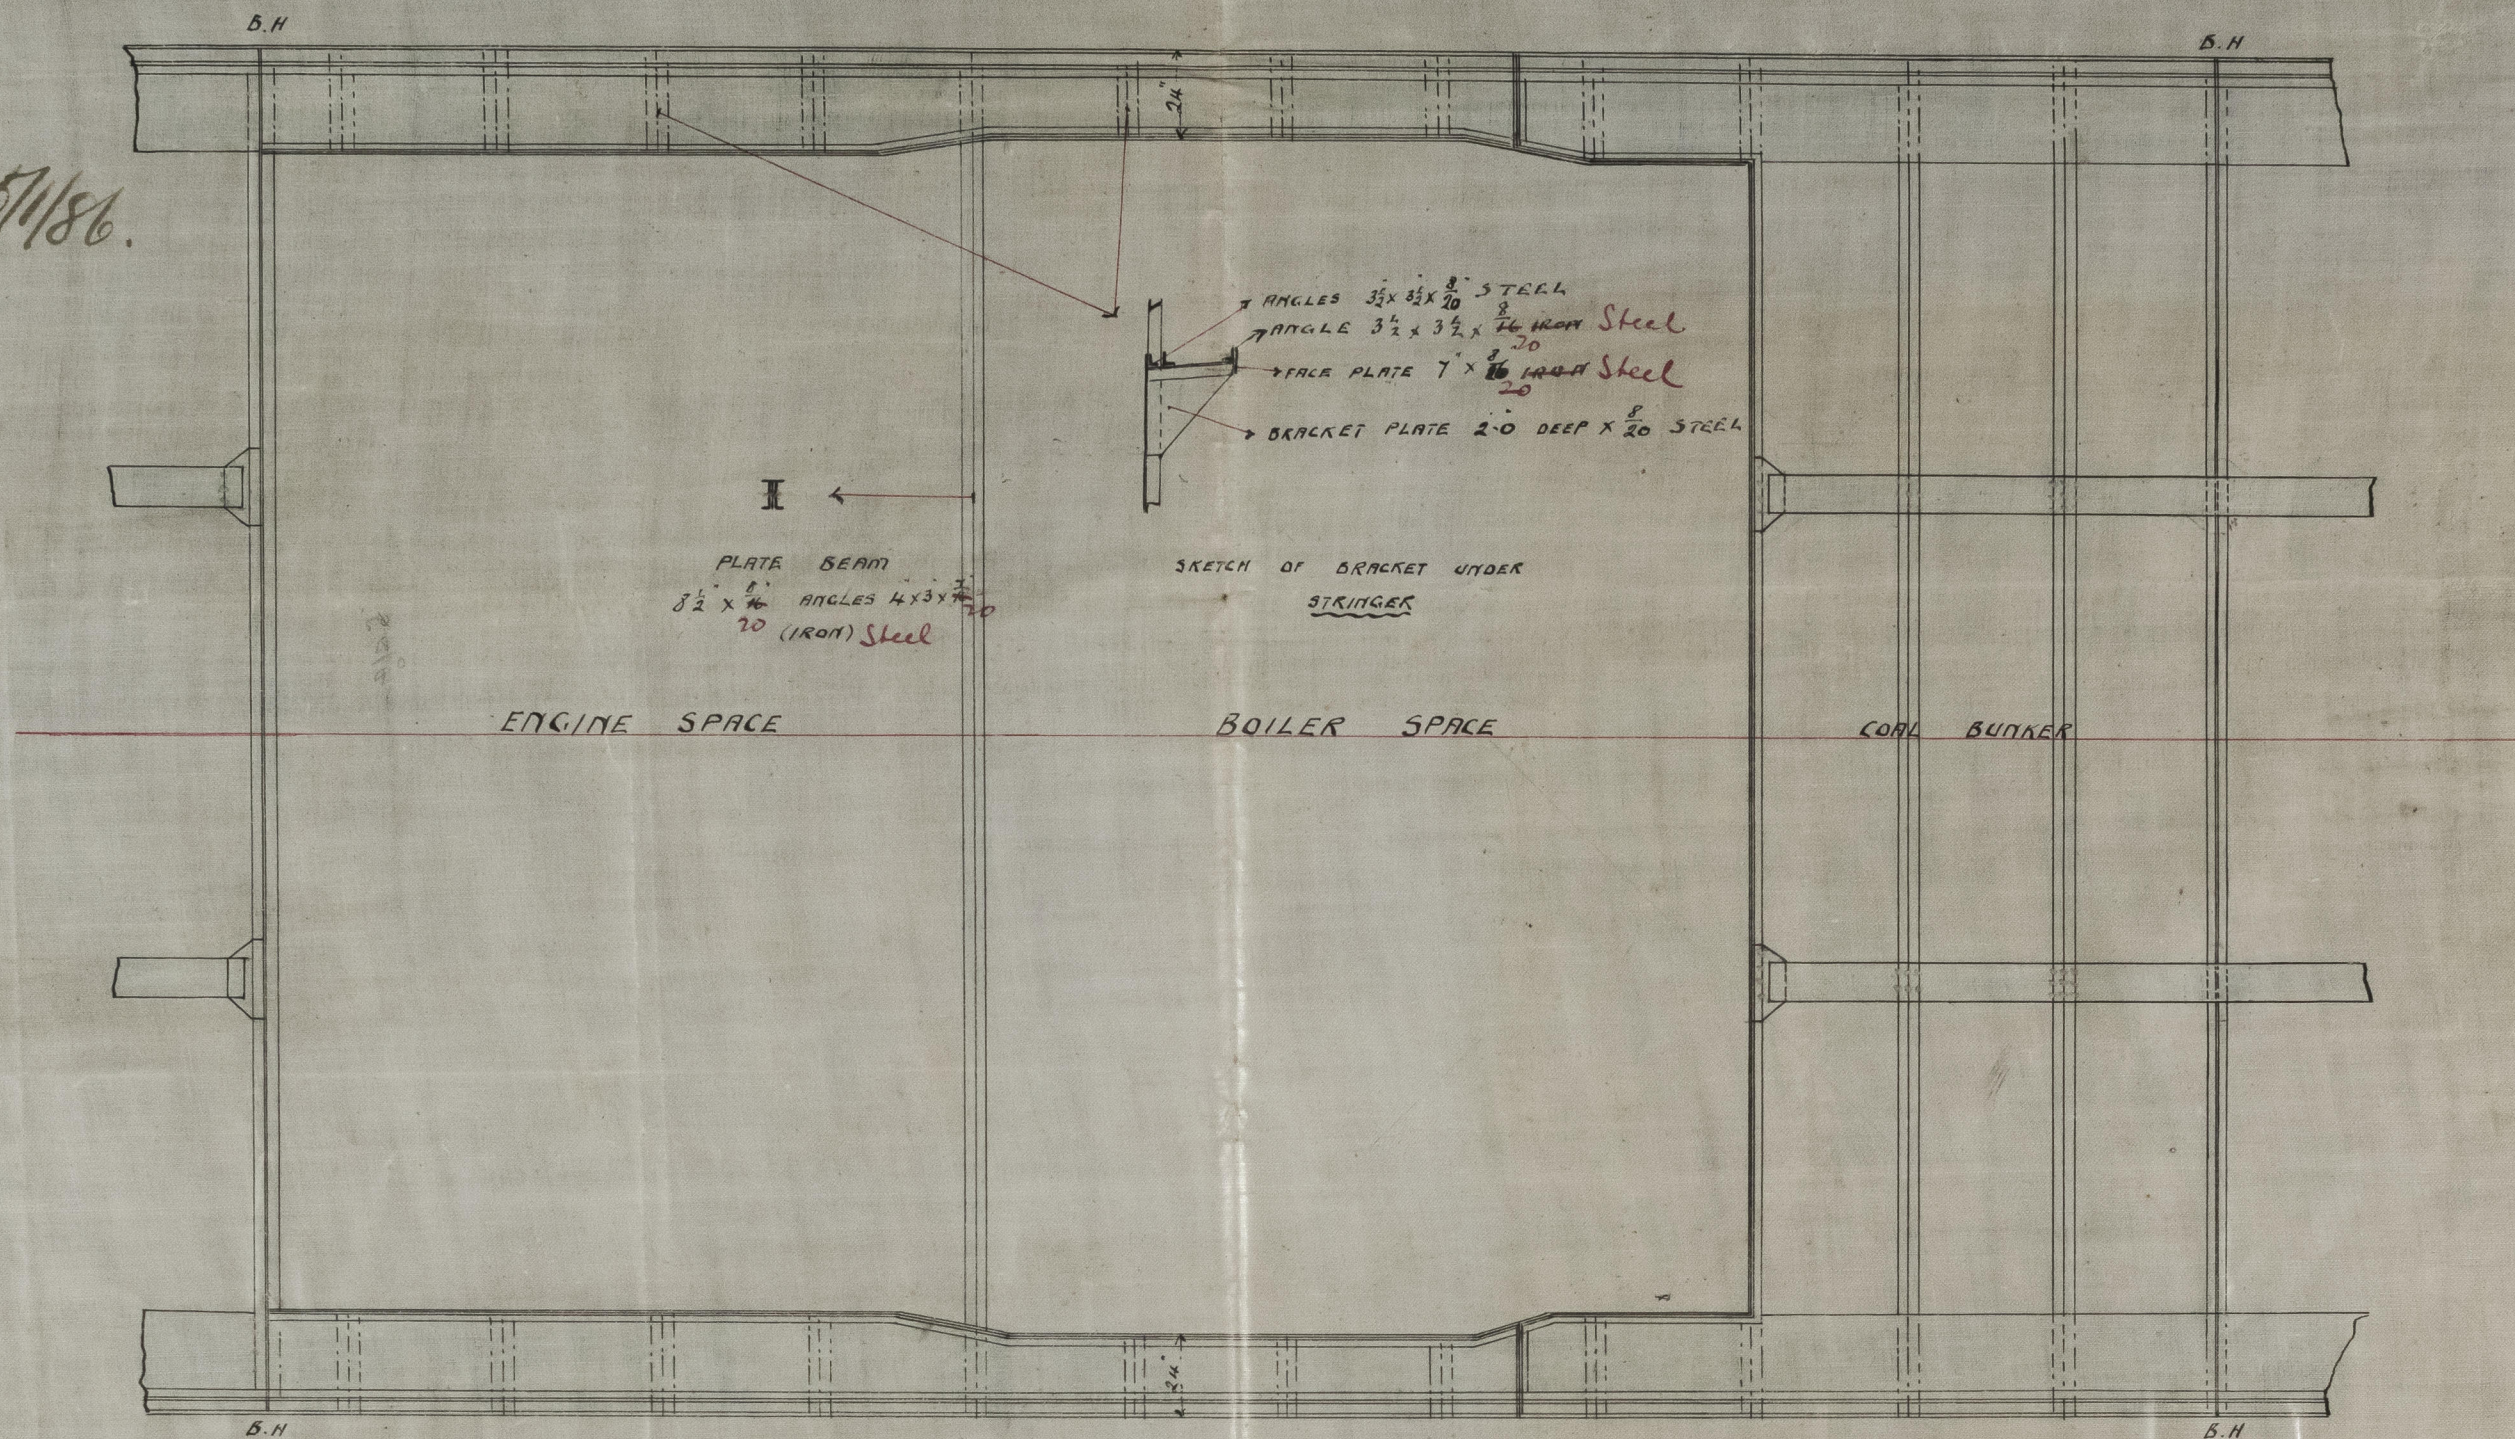

MAIN DECK

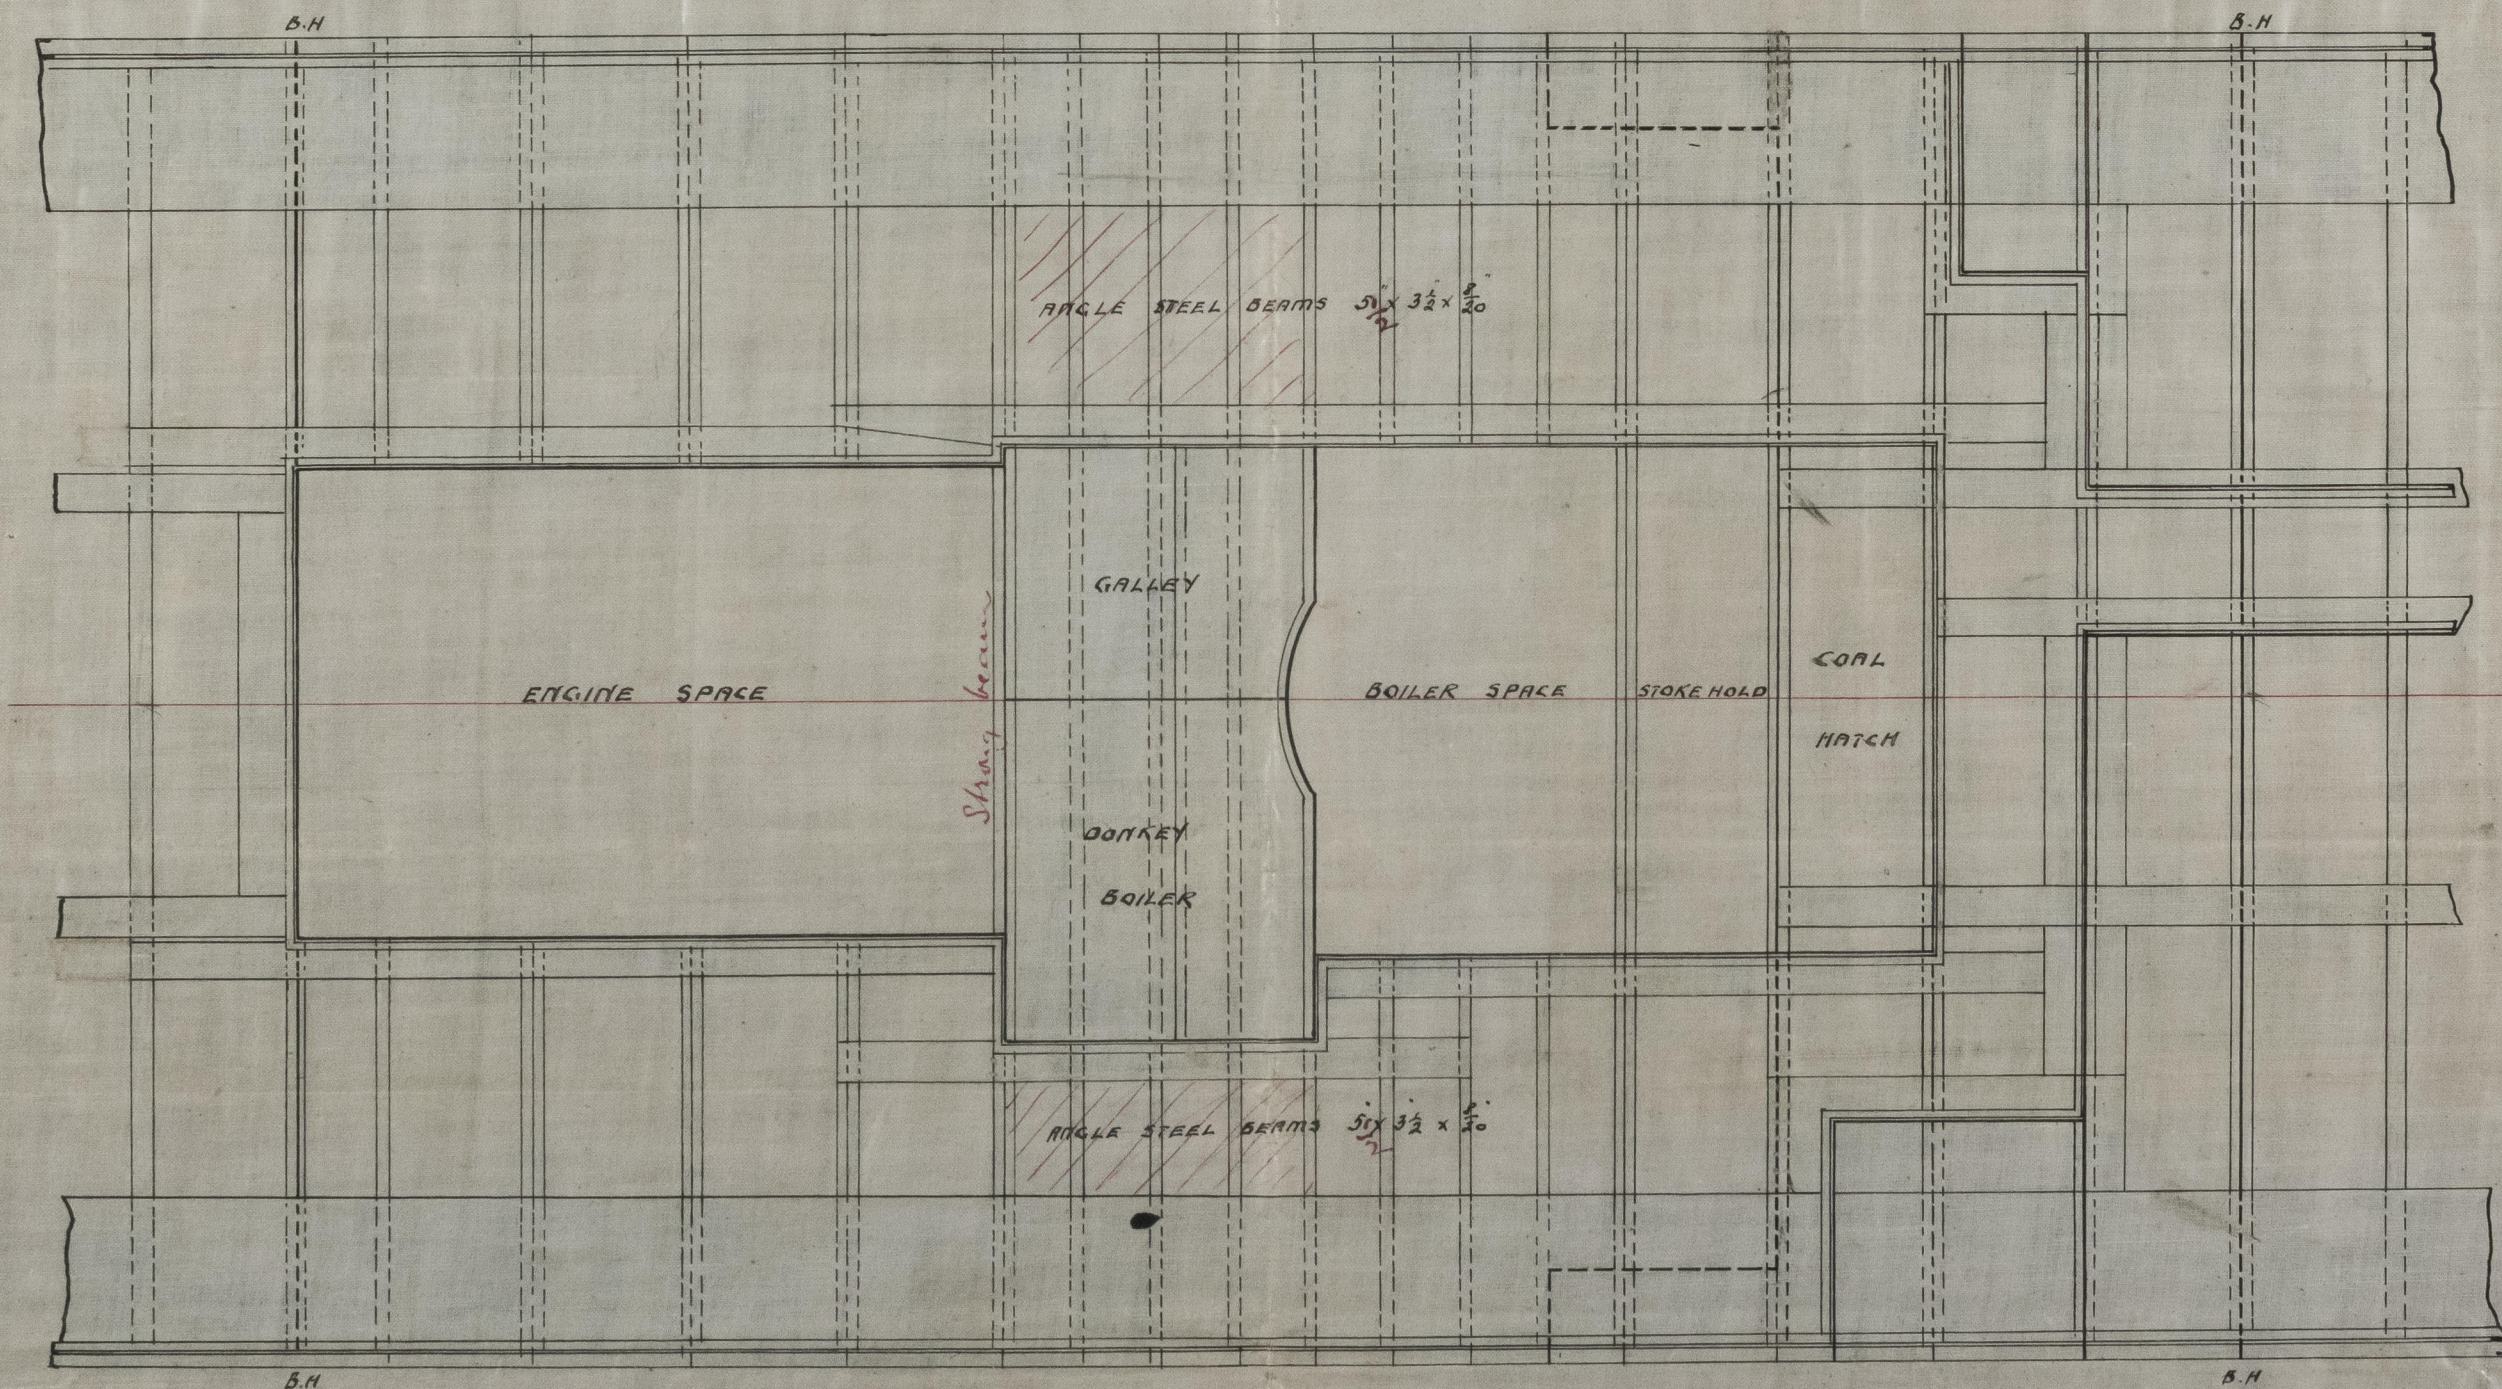

SKETCH SHEWING ARRANGEMENT FOR
STRENGTHENING ENGINE & BOILER SPACE S.S. No 146

SCALE $\frac{1}{4}$ INCH = ONE FOOT