

LLOYD'S REGISTER OF SHIPBUILDERS  
 RECEIVED  
 DEC. 85  
 LONDON  
 LLOYD'S REGISTER OF SHIPBUILDERS  
 RECEIVED  
 22 DEC. 85  
 LONDON  
 LLOYD'S REGISTER OF SHIPBUILDERS  
 RECEIVED  
 15 JAN. 86  
 LONDON  
 LLOYD'S REGISTER OF SHIPBUILDERS  
 RECEIVED  
 15 JAN. 86  
 LONDON

# MIDSHIP SECTION STEEL SCREW STEAMER N° 146

SCALE 1/2 INCH PER FOOT

## DIMENSIONS


LENGTH AS PER RULES	223-9 1/2	OR	223.79
HALF MOULDED BREADTH	16-0	"	16-0
DEPTH FROM TOP OF KEEL TO M.D. BEAMS	17-3	"	17.25
GIRTH OF HALF MIDSHIP FRAME SECTION	29-9	"	29.75

NUMERALS 63/14098  
 DO FOR EQUIP 15,508

## PROPORTIONS

DEPTHS IN LENGTH	12.9
BREADTHS "	6.9

*S.S. Medway*  
*Glasgow Report N° 4530-*

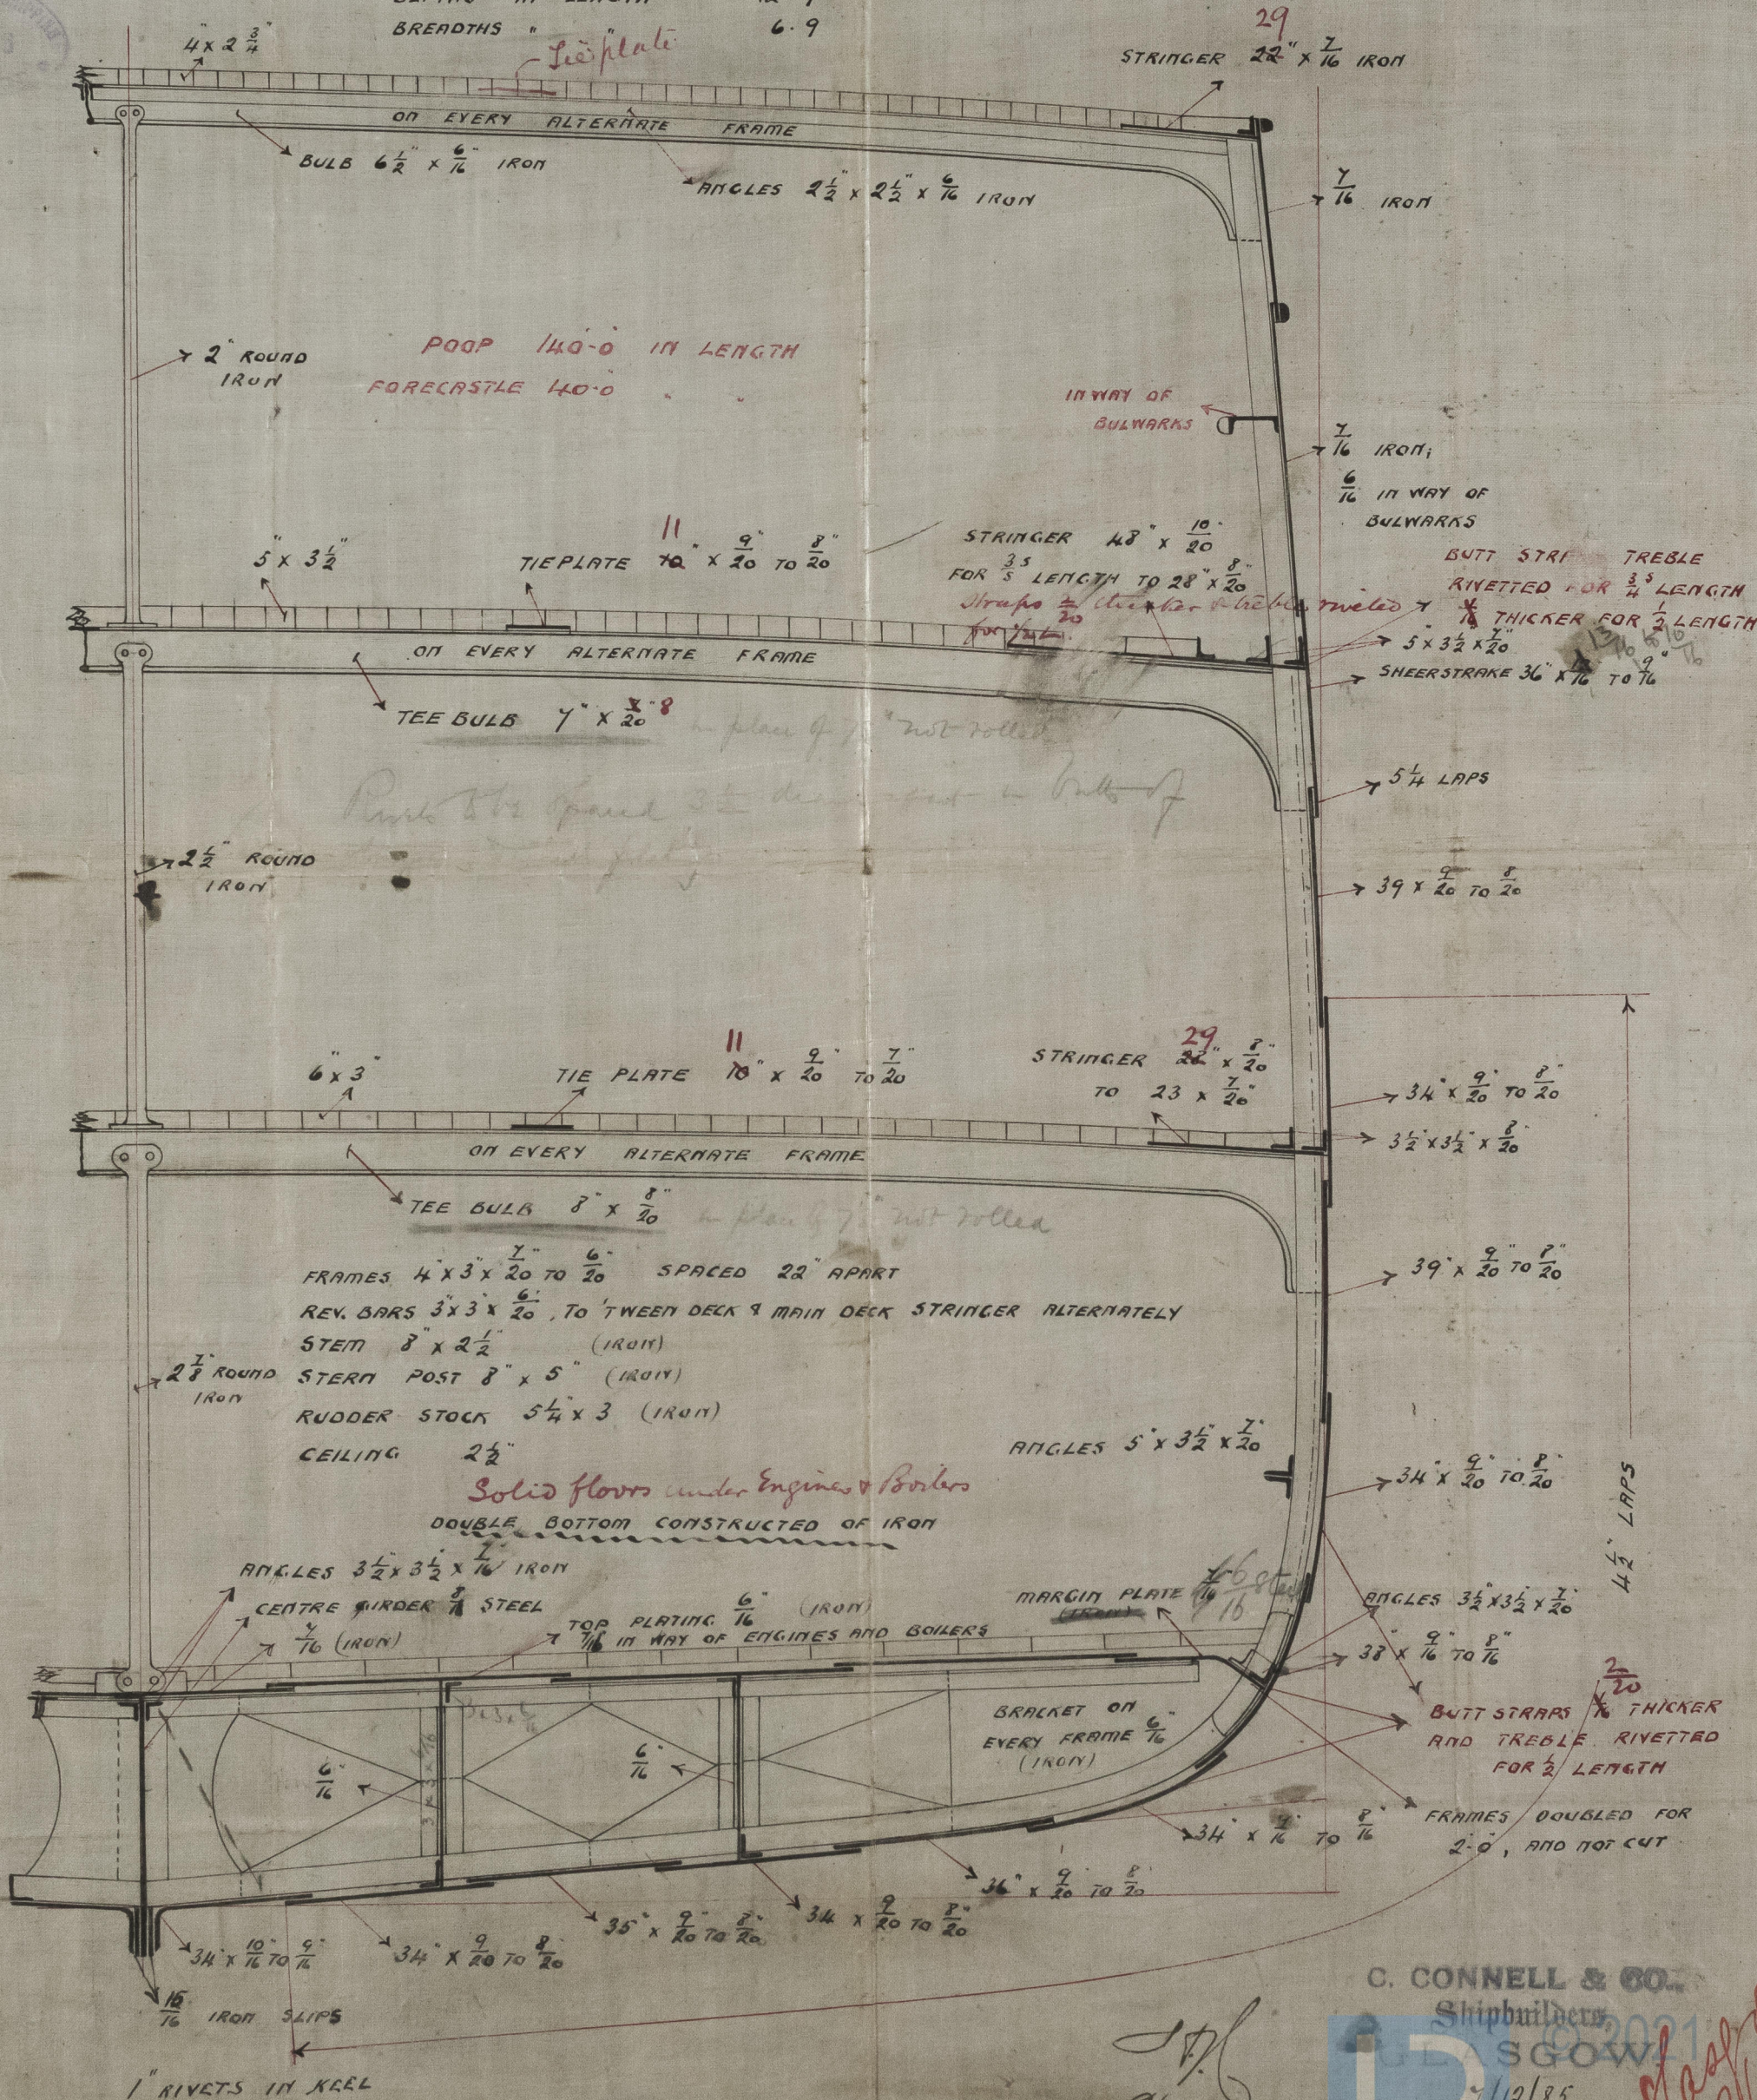

C. CONNELL & CO.  
 Shipbuilders  
 GLASGOW

9/12/85

GLS204-0170

Lloyds Register  
 Foundation