




S. S. "Medway" Glasgow Report No. 4530.

31.12.85

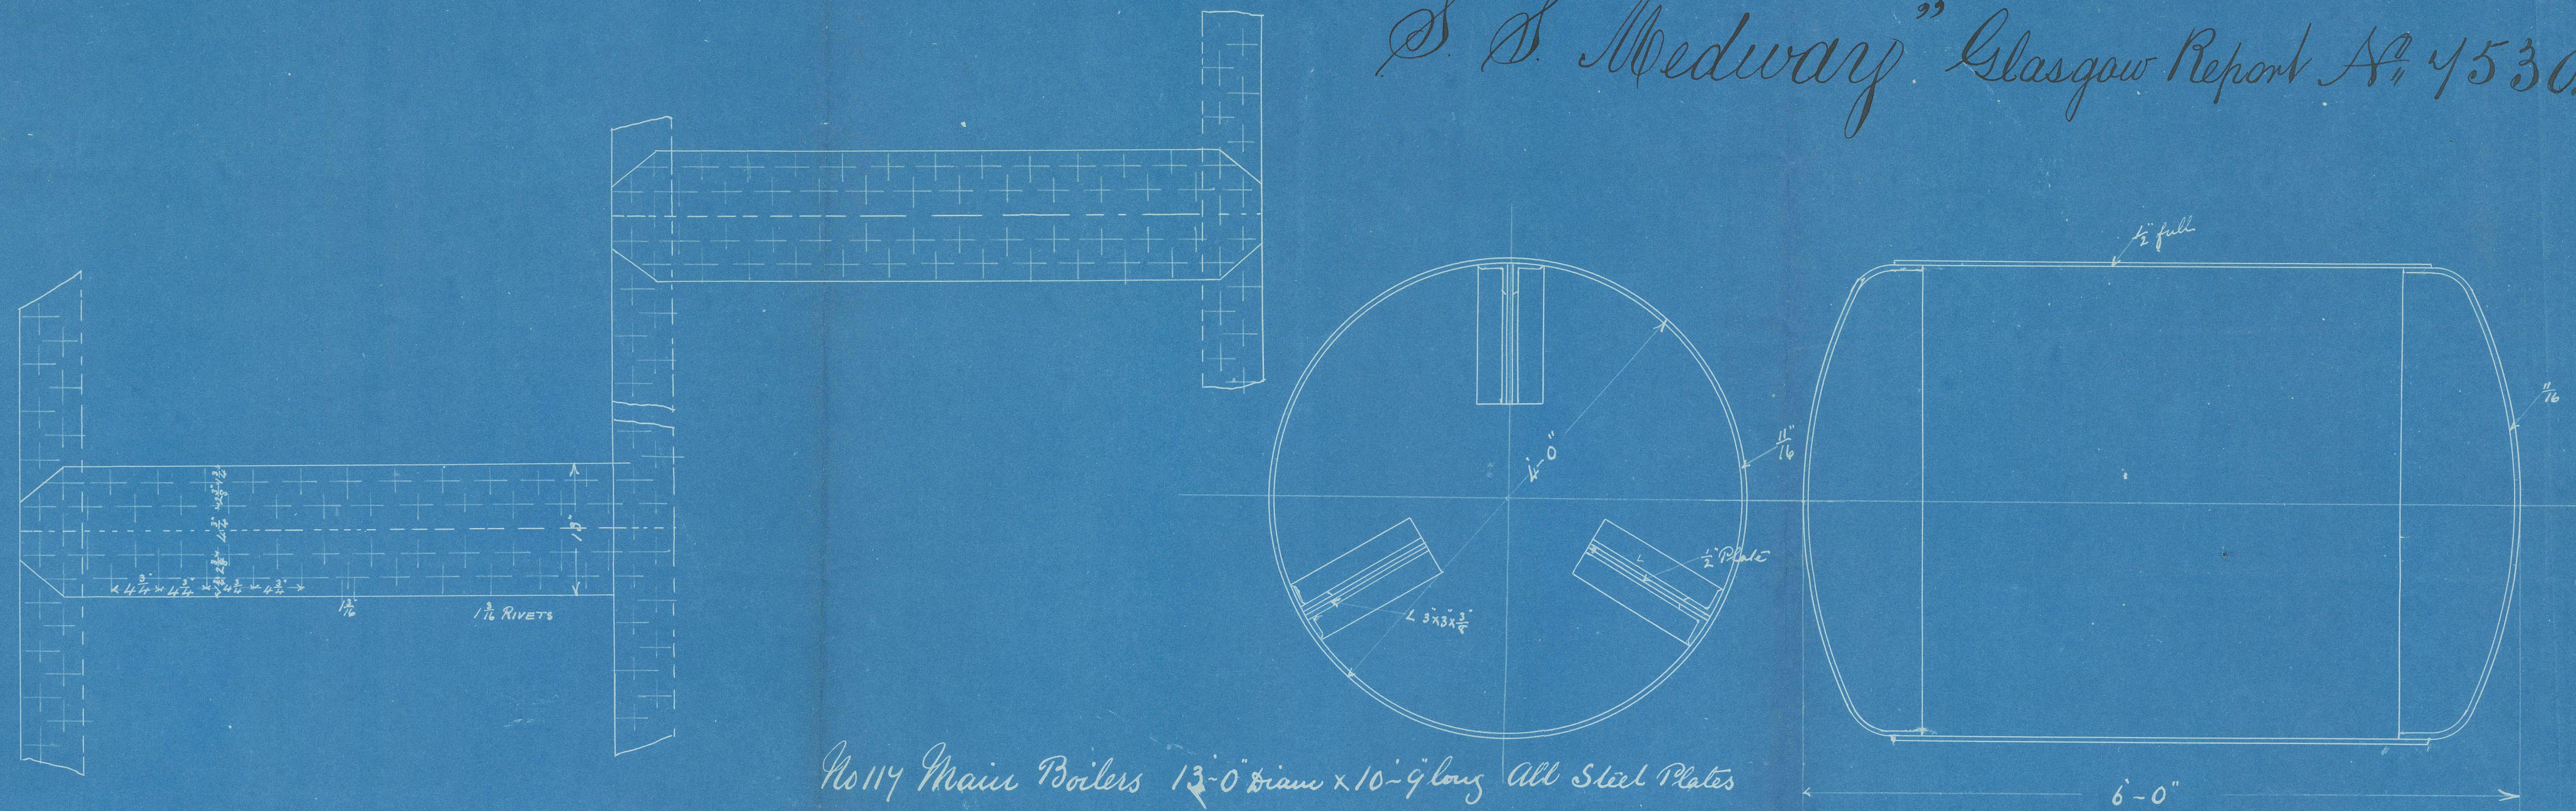

Pressure 100 lbs per sq inch
Scale 1 inch = 1 foot.

ENGINEERING
GLASGOW

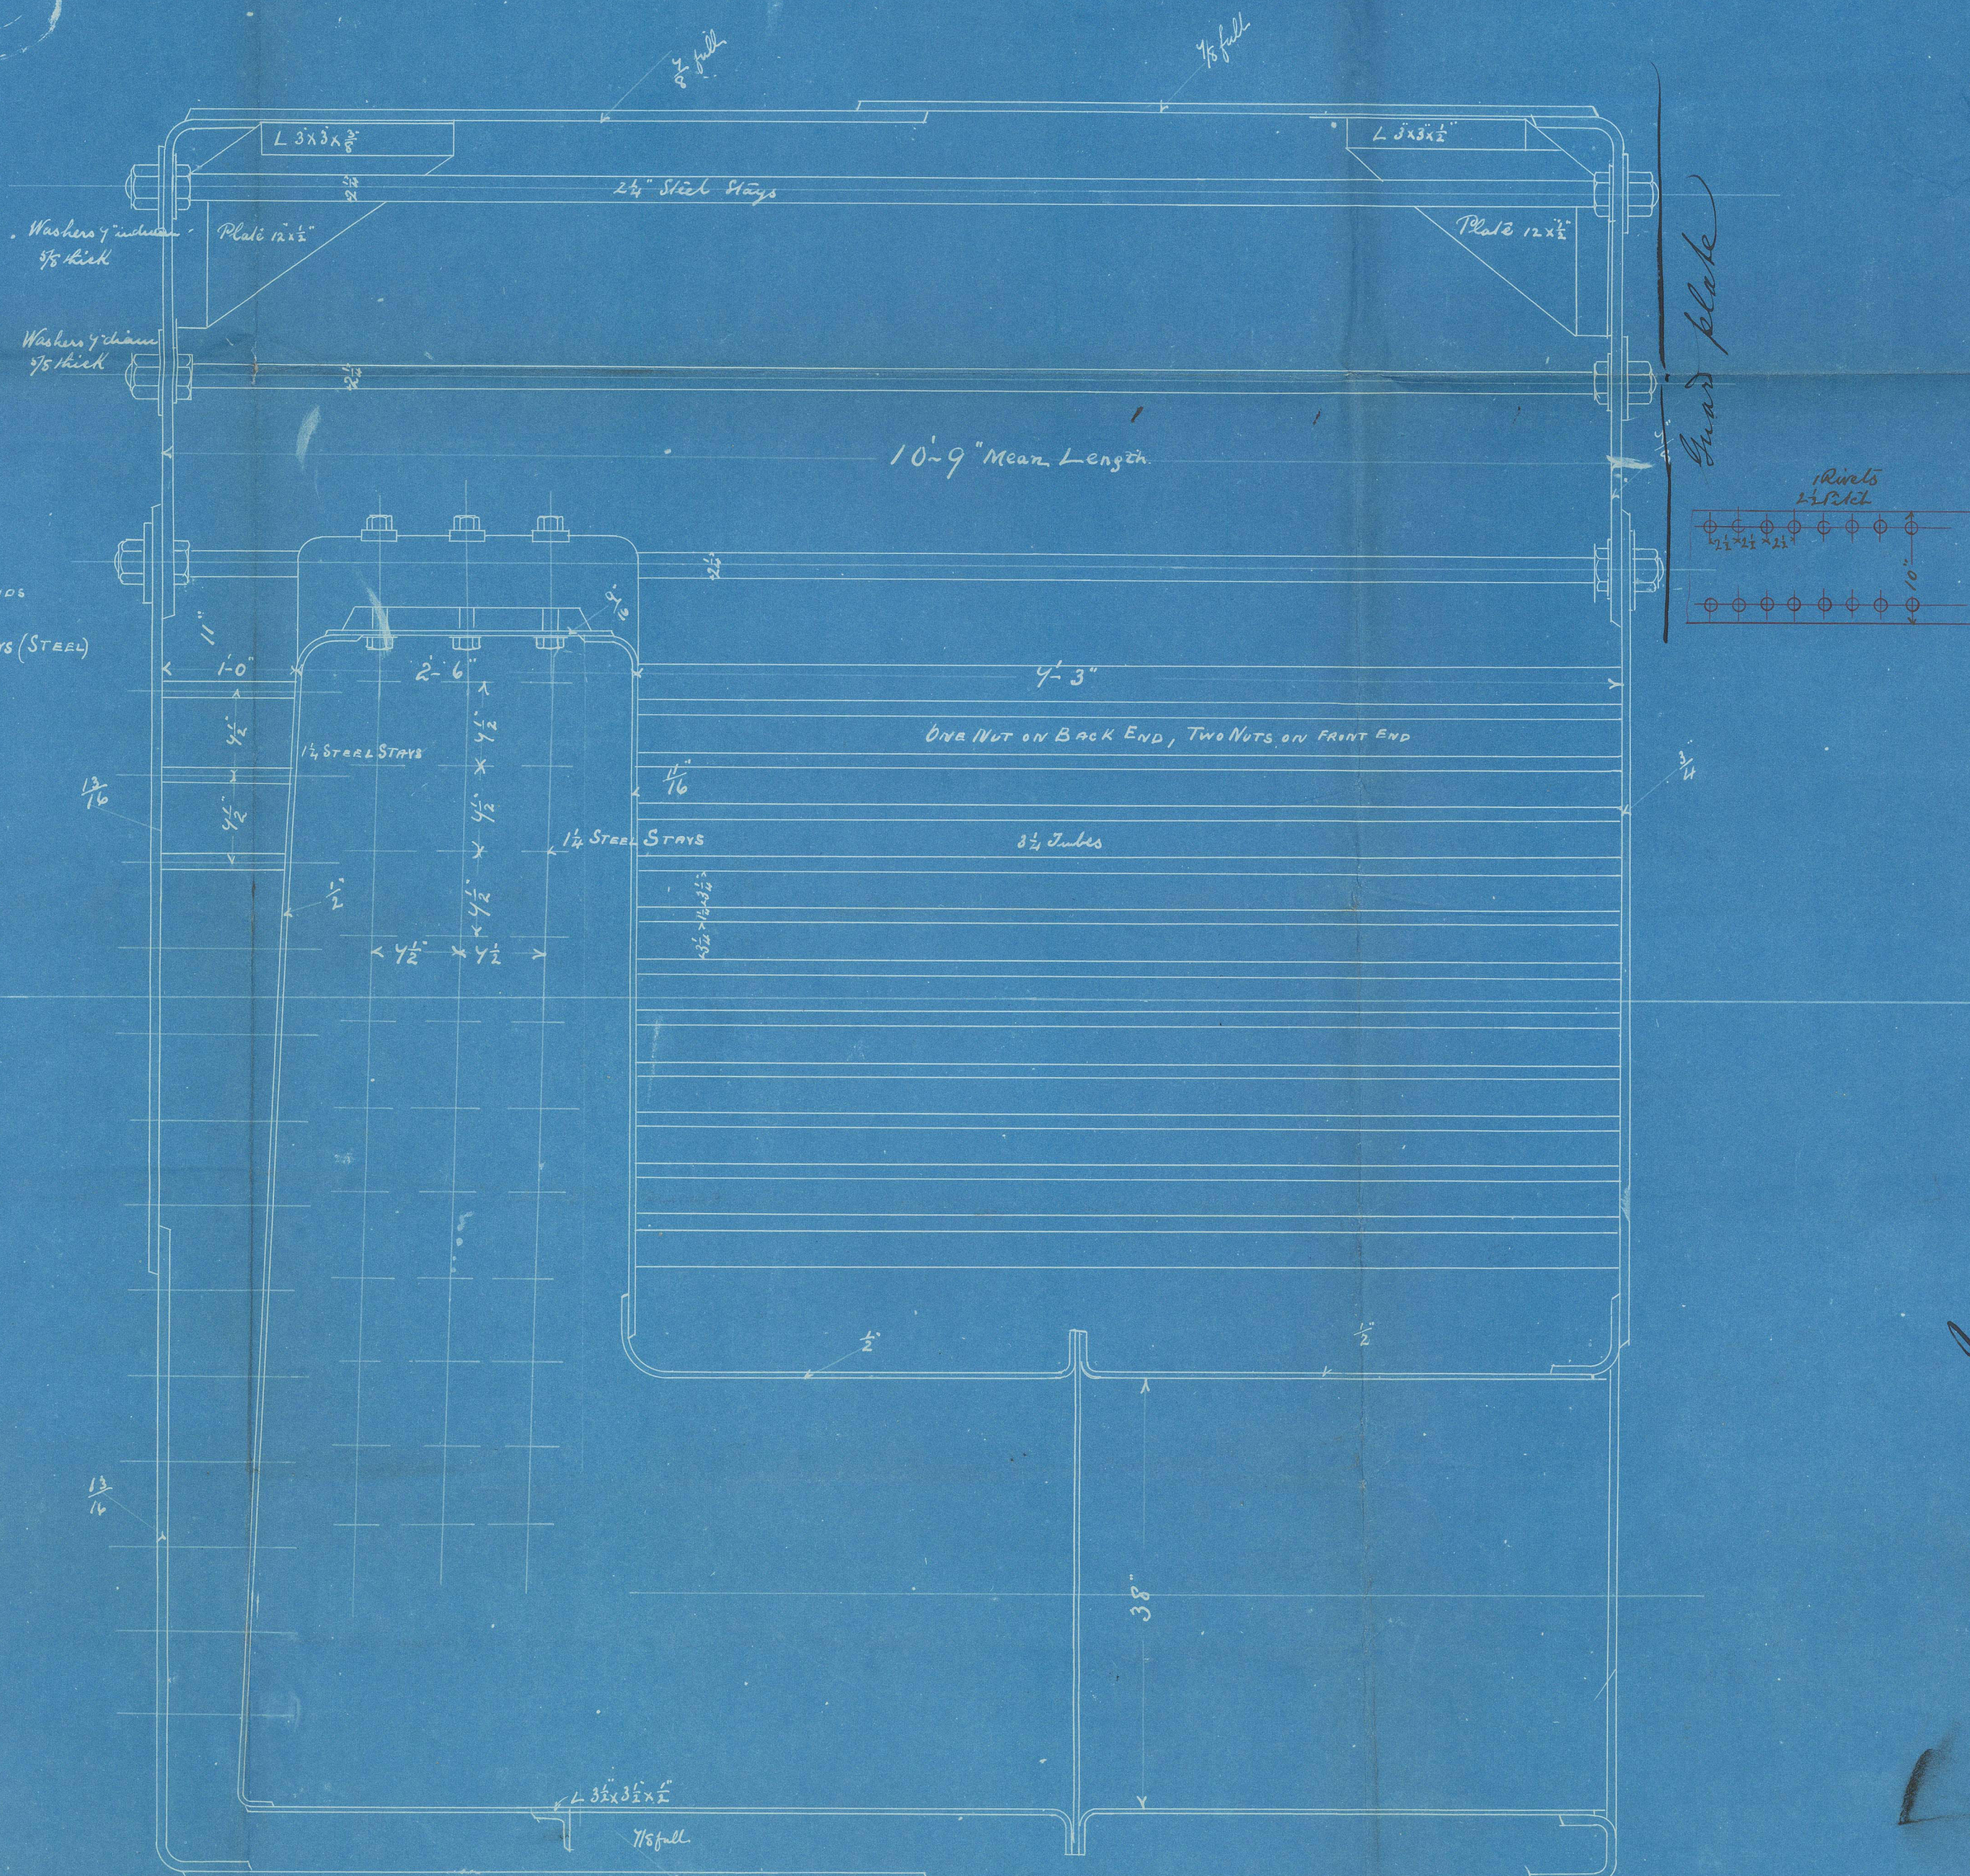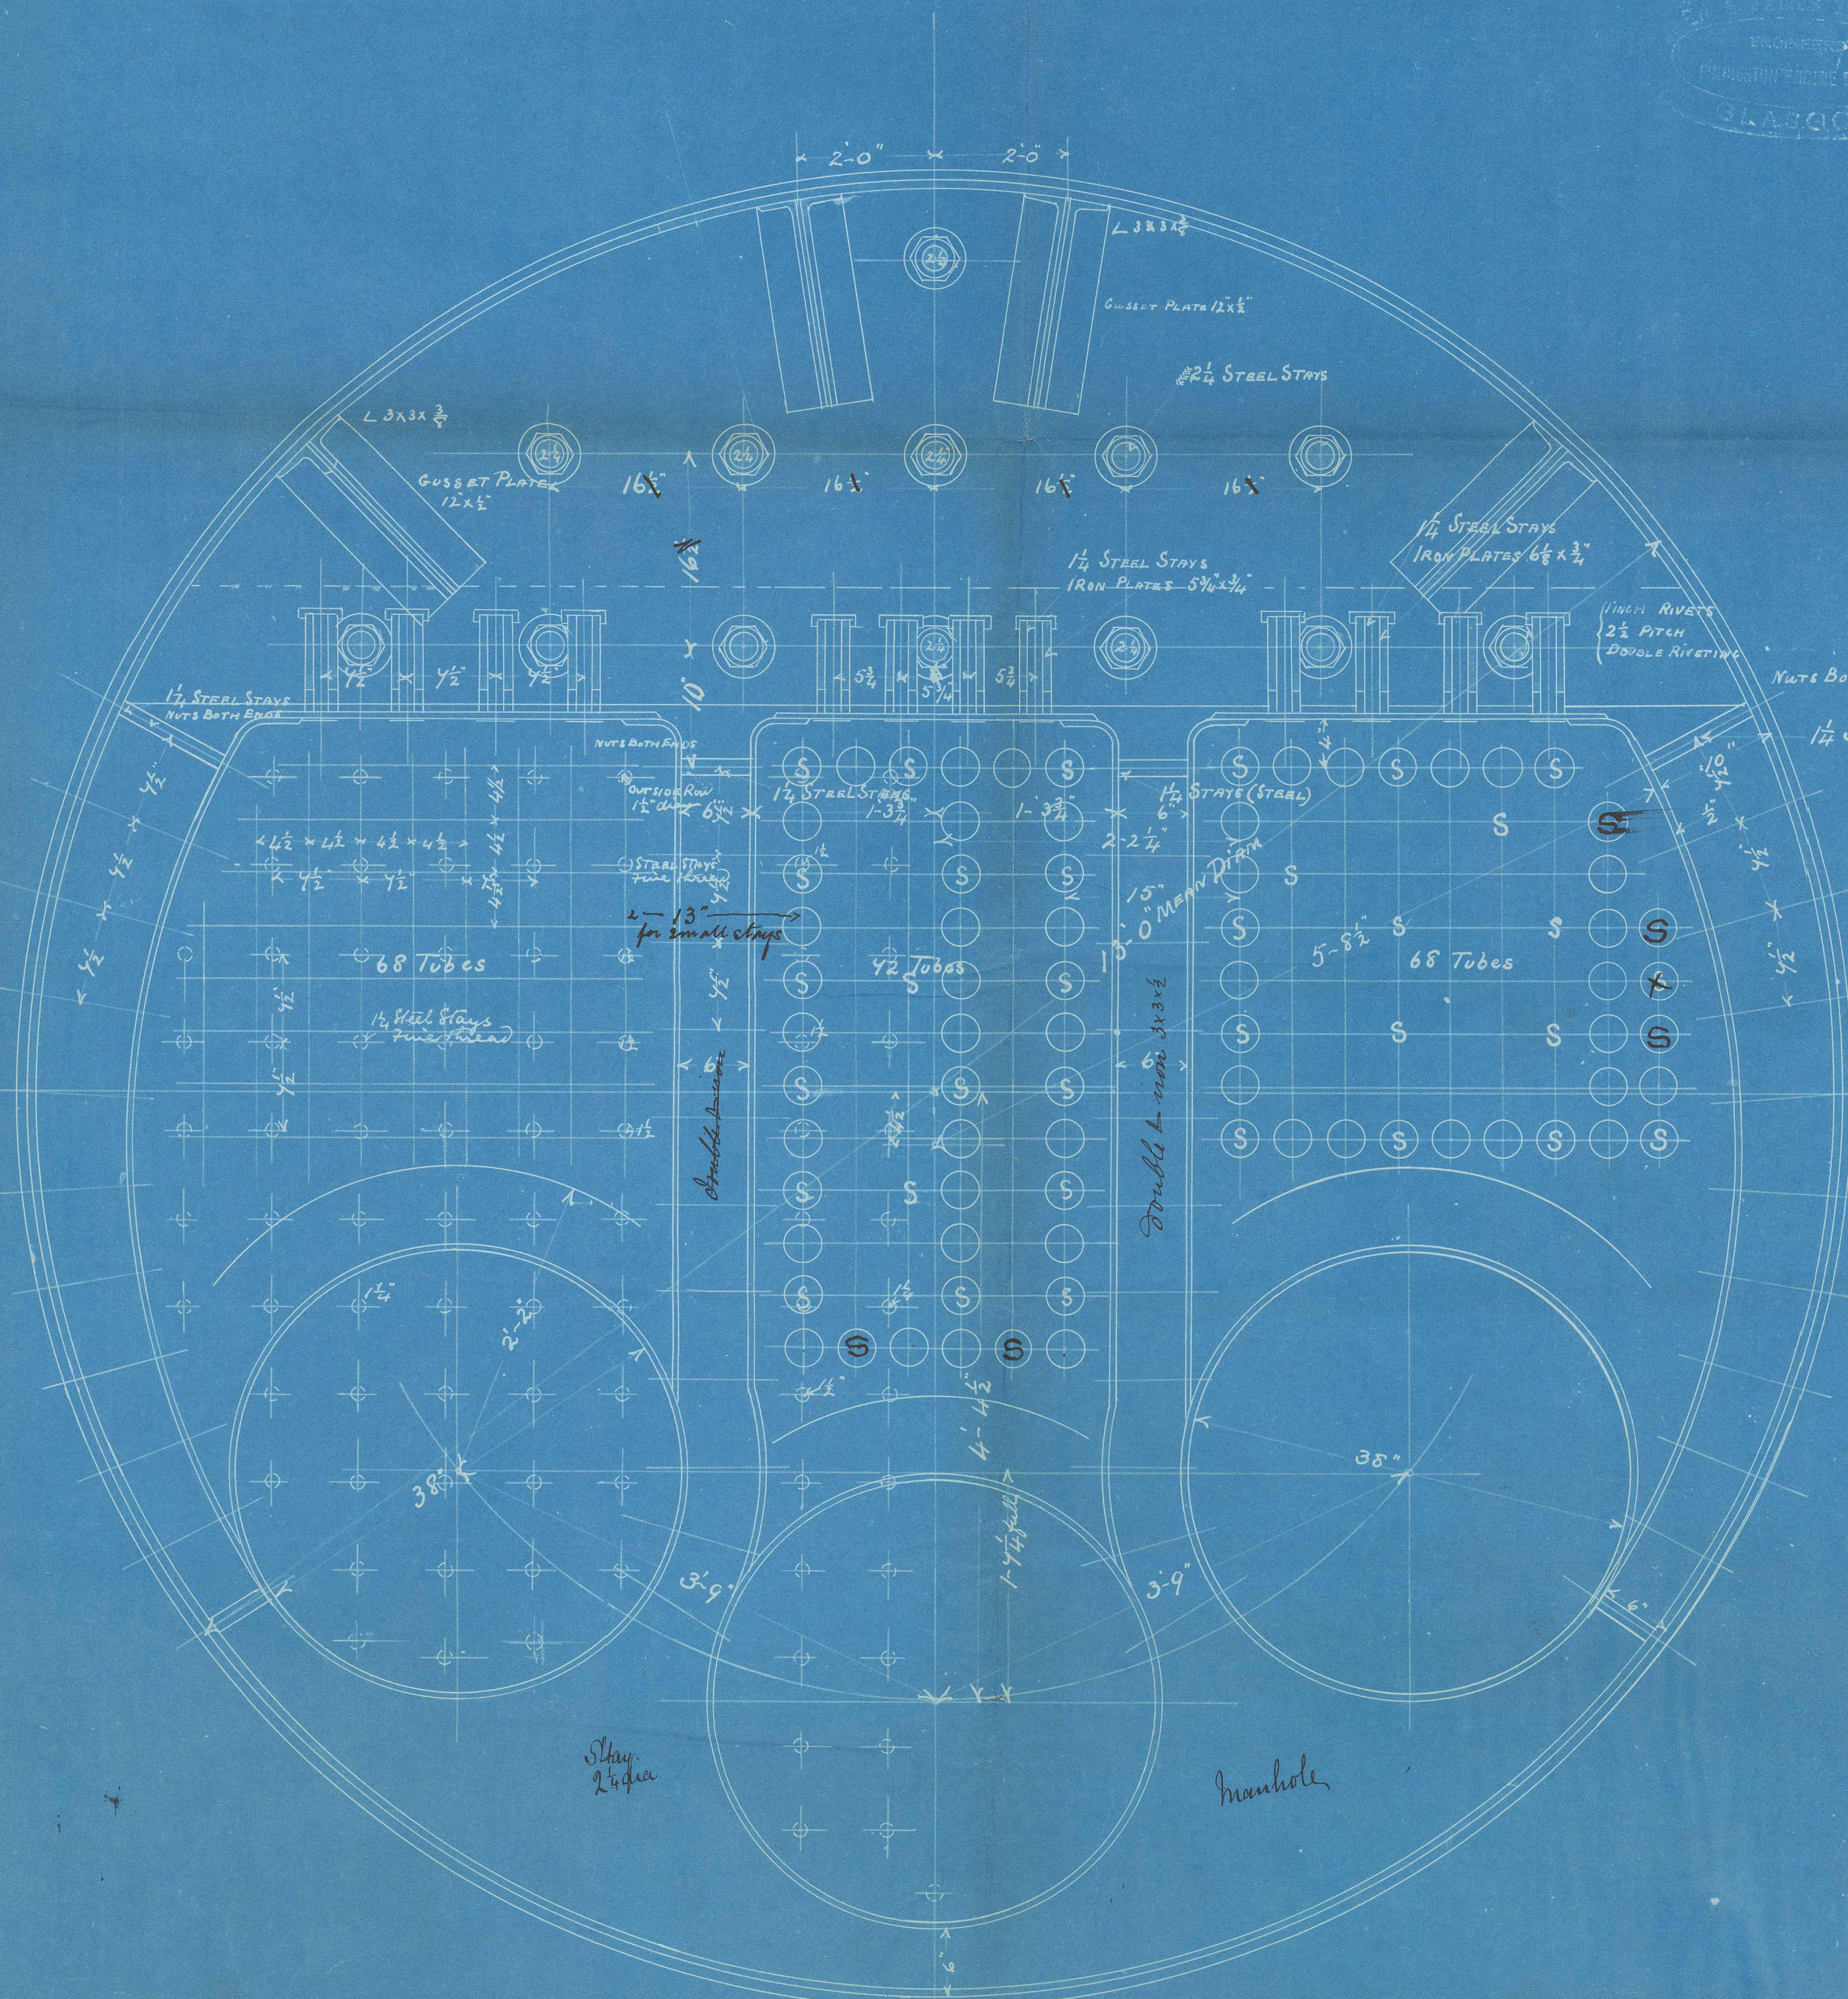

SM
31/12/85

J. J. Thomson
117

GLS204-0171



© 2021

Lloyd's Register
Foundation