


*See also: 9/100/85*


ARRANGEMENT OF PANTING BEAMS & SIDE STRINGERS

AT FORE END OF SHIP N<sup>OS</sup> 342 & 341.

SCALE 1/4 INCH TO A FOOT

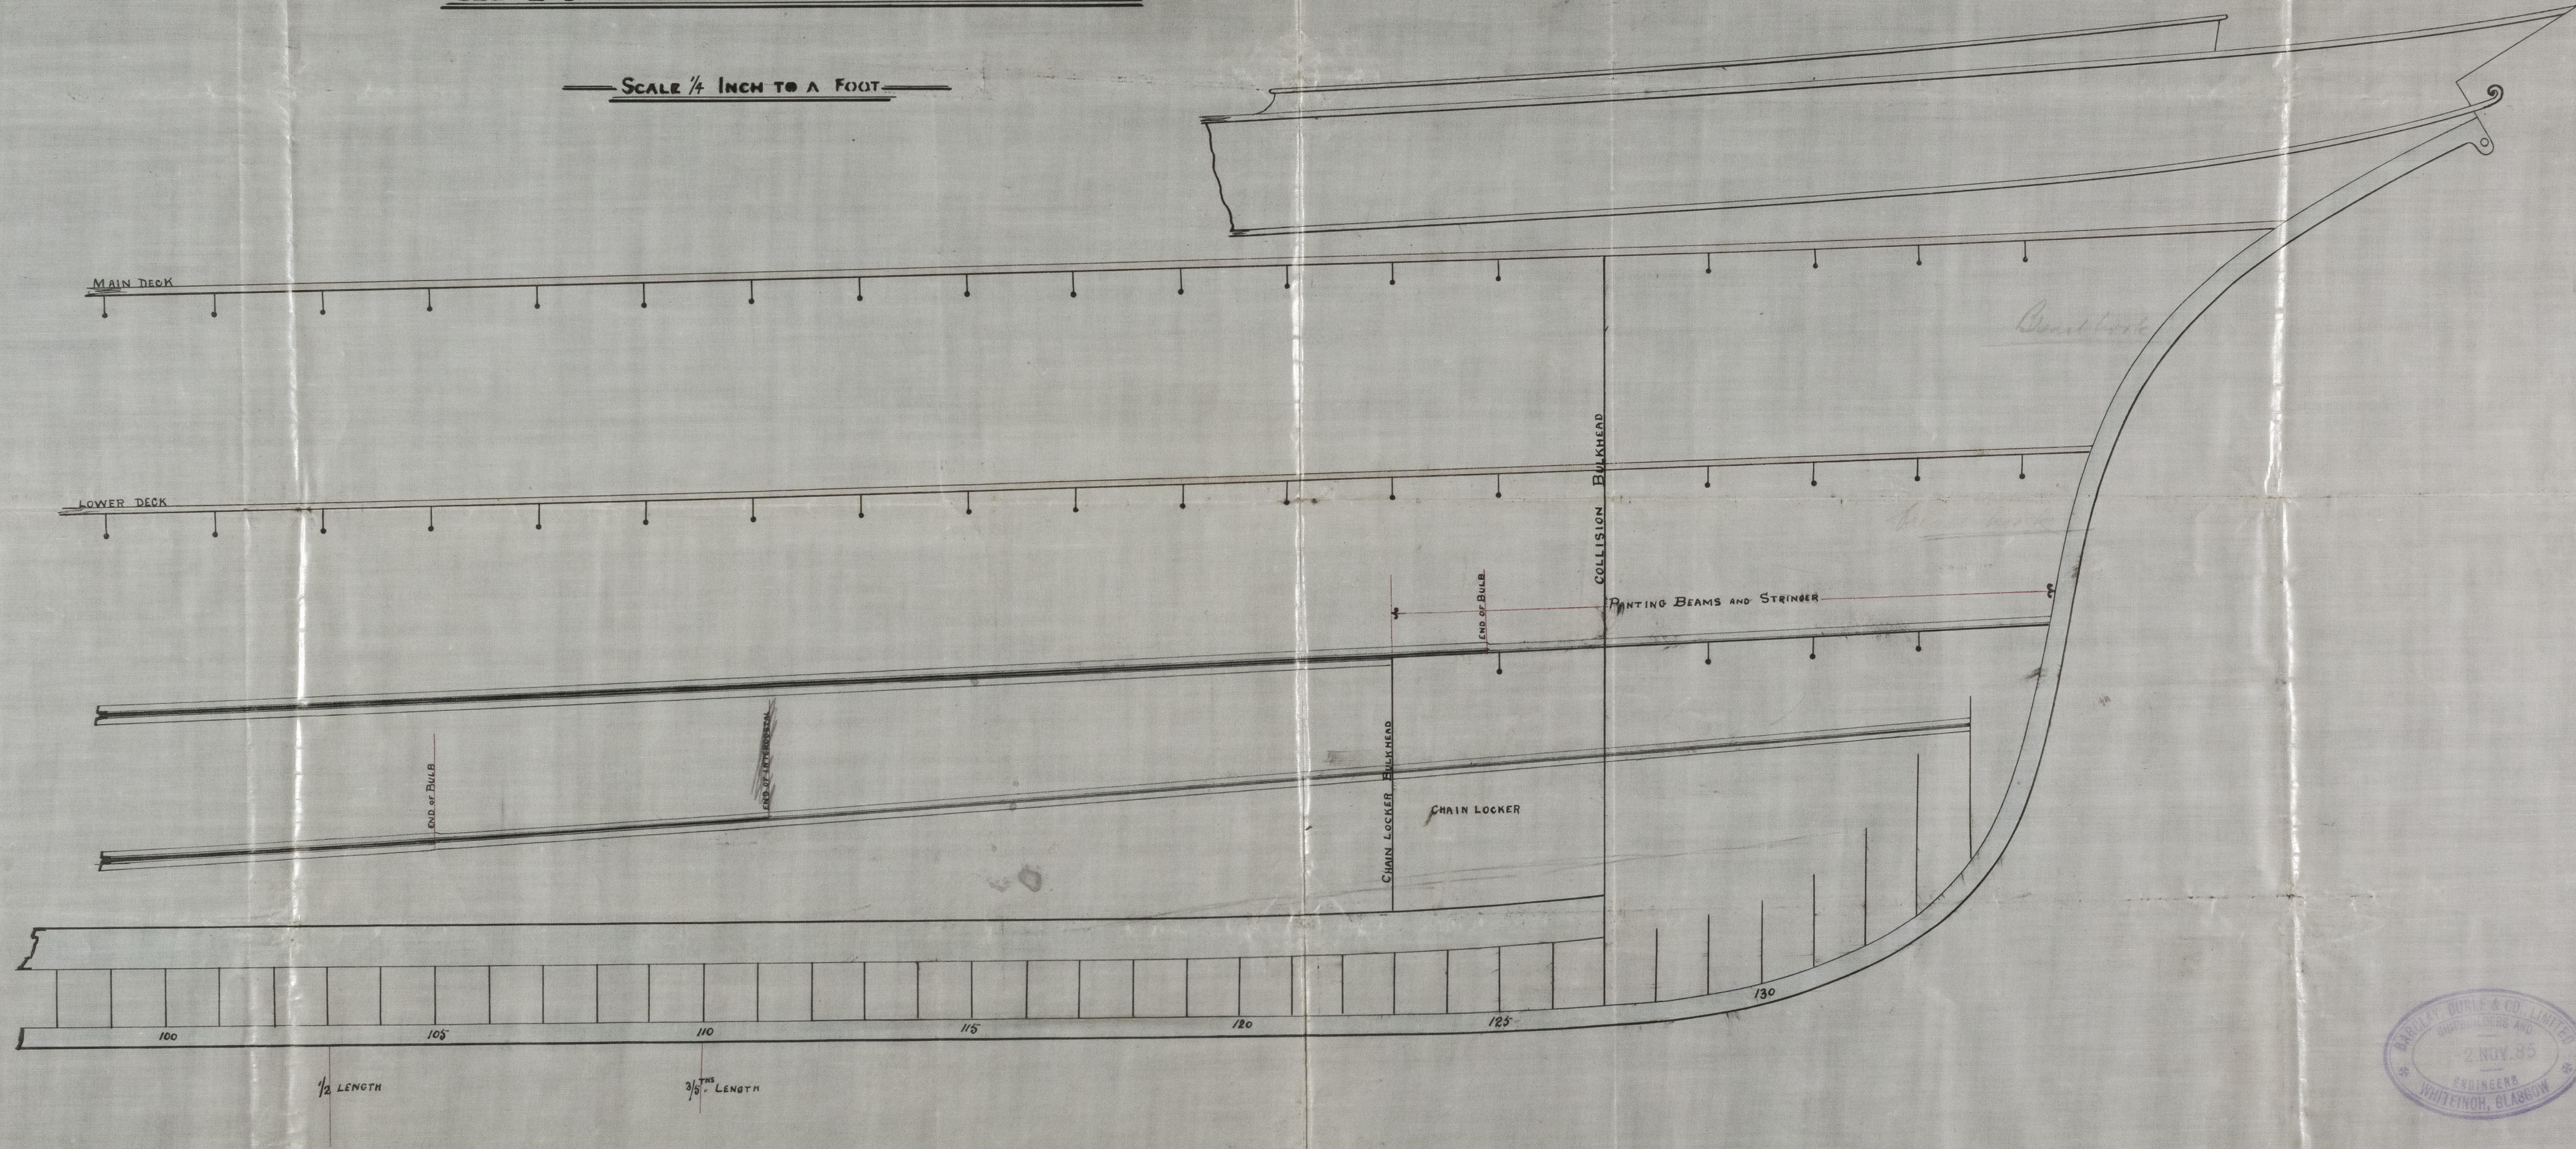

N<sup>o</sup> 341. Ship "Hannockburn" Glasgow Report N<sup>o</sup> 7481.  
342. Ship "Amarjon" do " 4554.

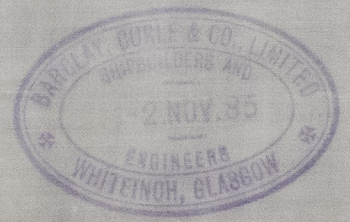

*glass for 3/11/85 C.F.*



© 2021 Lloyd's Register Foundation

GLS204-0173