

DONKEY BOILER, No. 510-1





Model Steamer "Venus" Glasgow Report 144348

No COMMON TUBES 40
D^o STAY D^o 14 = 54
TOTAL TUBE SURFACE 212.07
D^o FLUE D^o 64.37
D^o HEATING D^o 276.34 sq. ft.
D^o FIREGRATE D^o 13.75

HEATING SURF TO FIREGRATE 20.
FIREGRATE TO FLUE AREA 7.8
D^o TUBE D^o 6.2
FLUE TO D^o 7.8

PRESSURE 90 LBS.

WEIGHT OF WATER IN BOILER 3 TONS.
D^o OF D^o

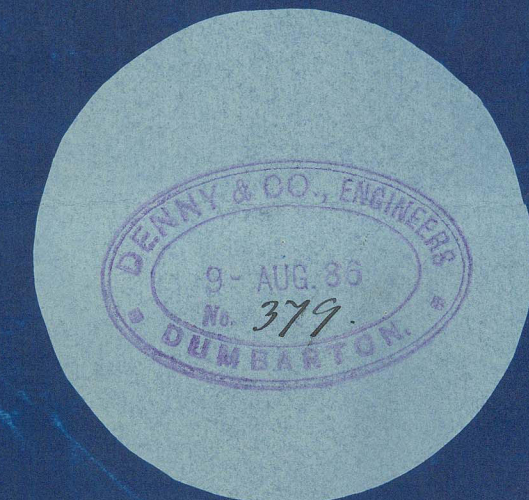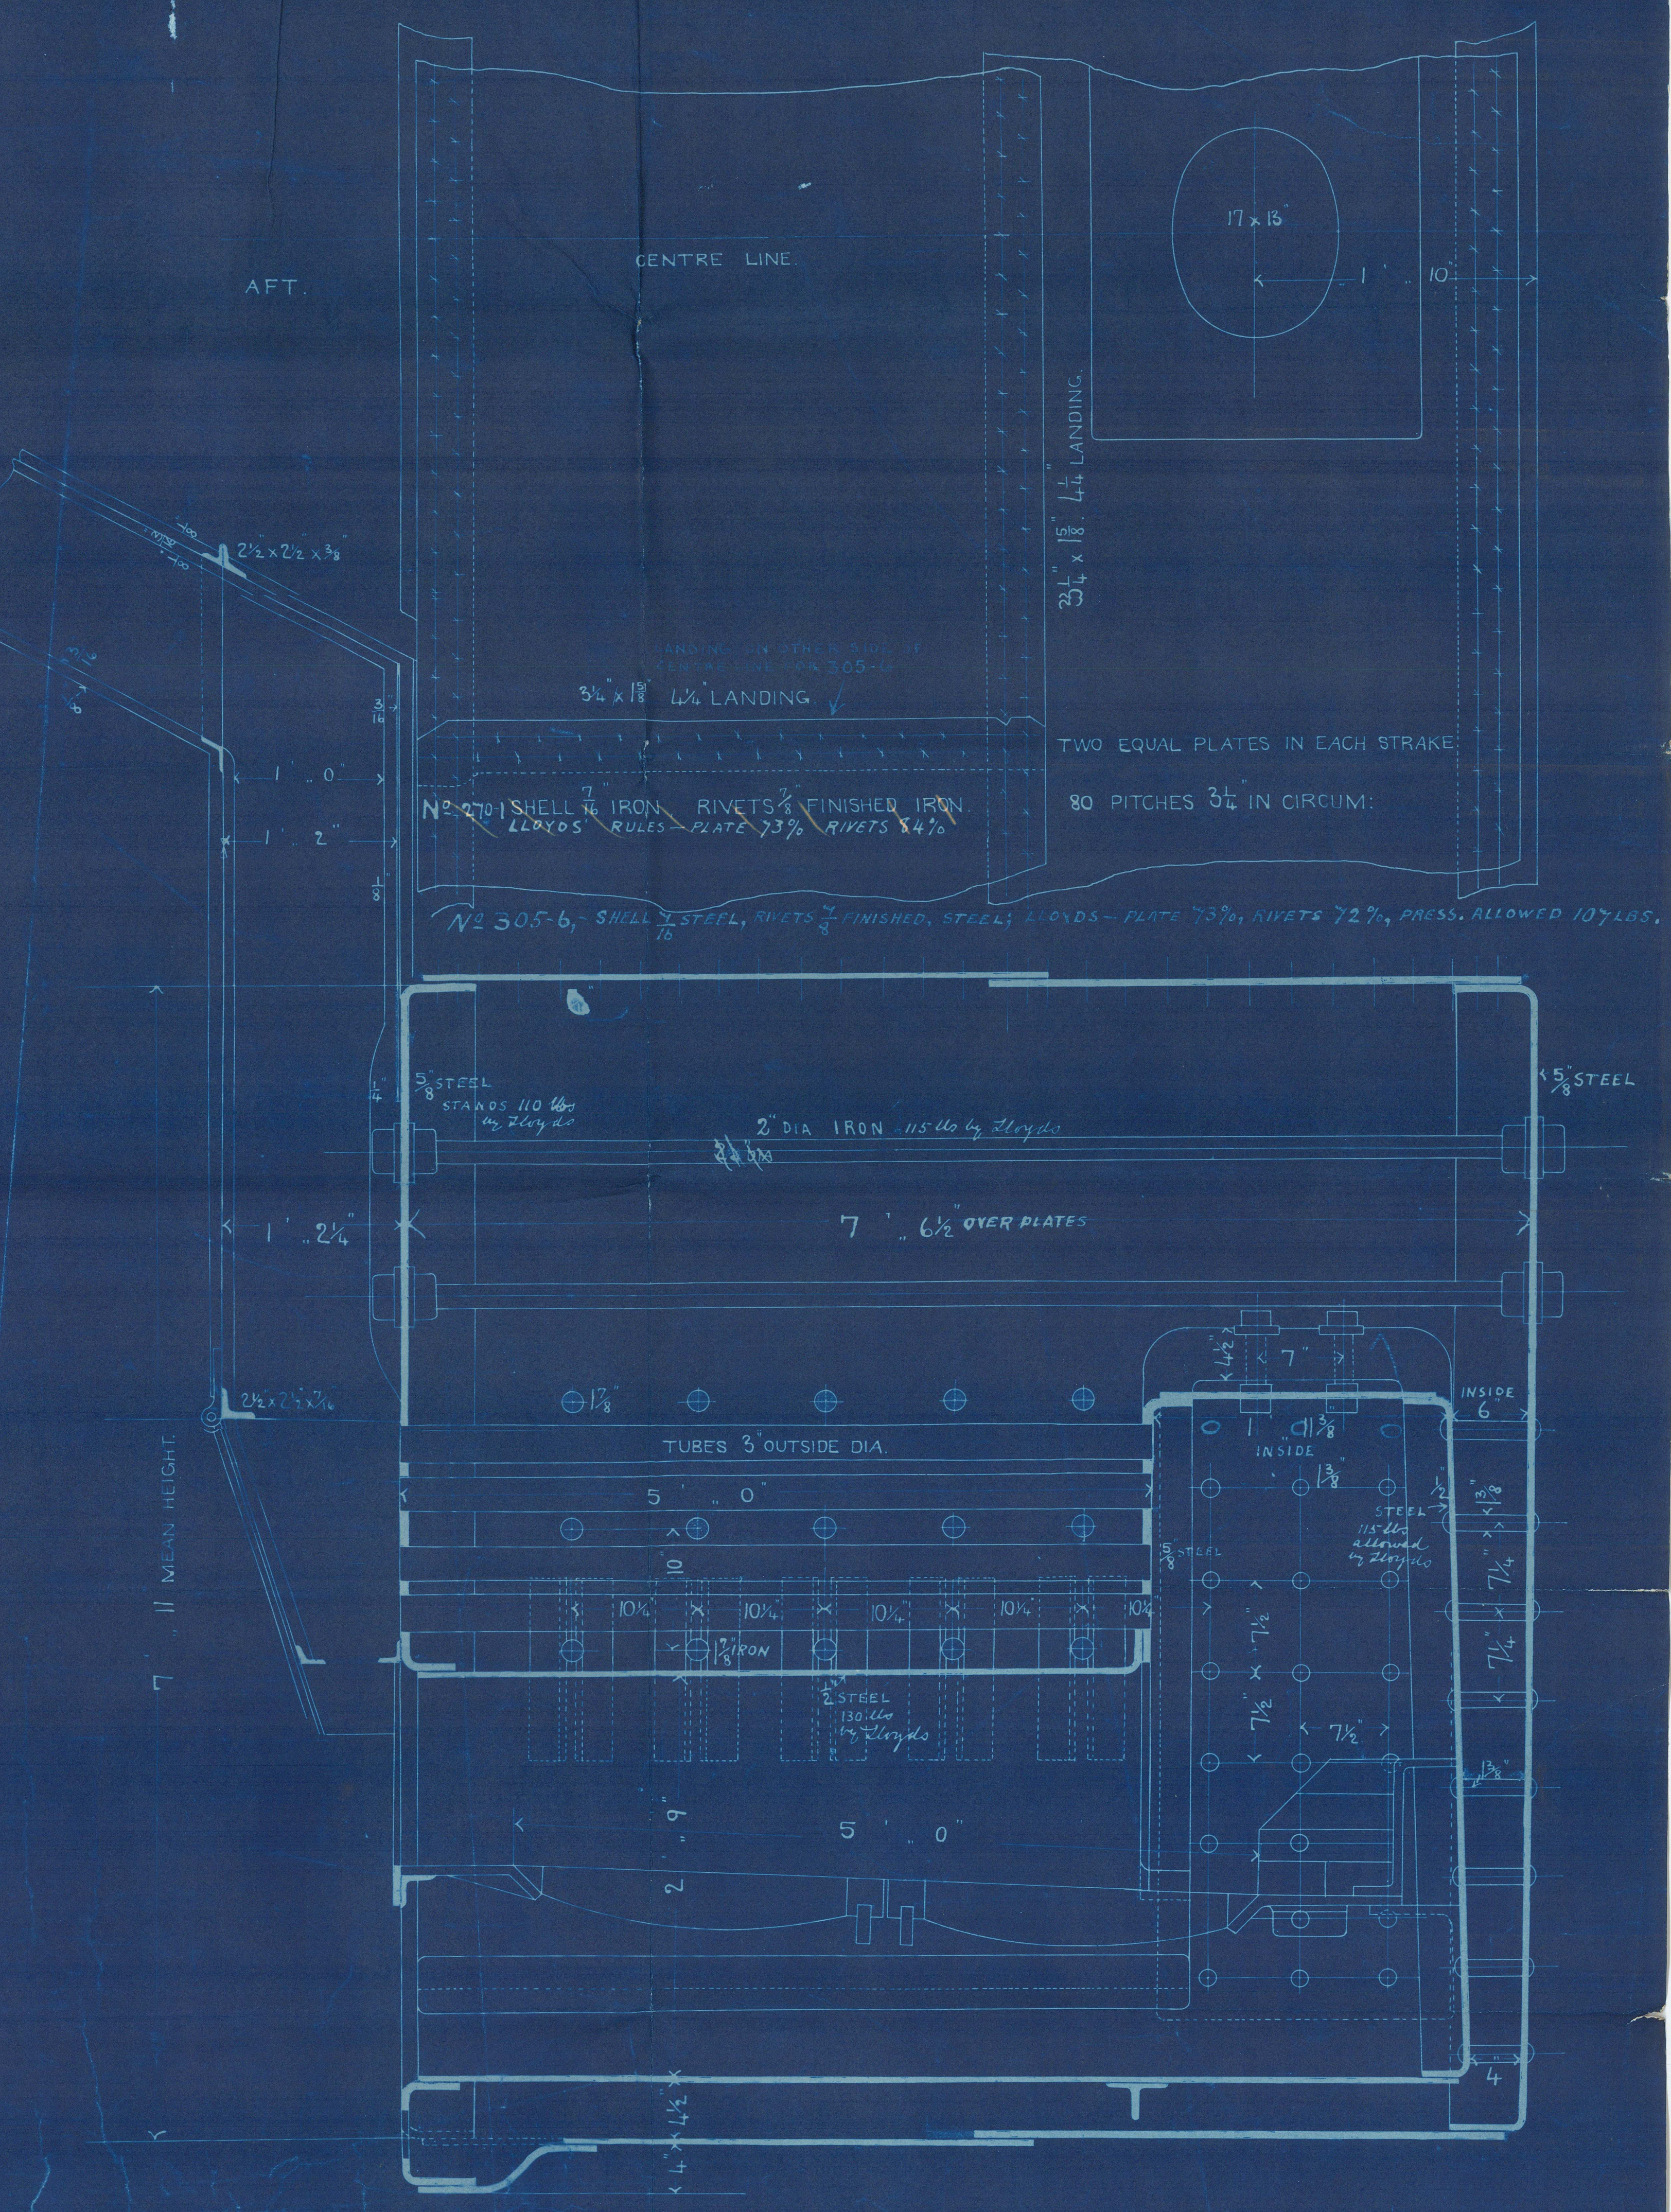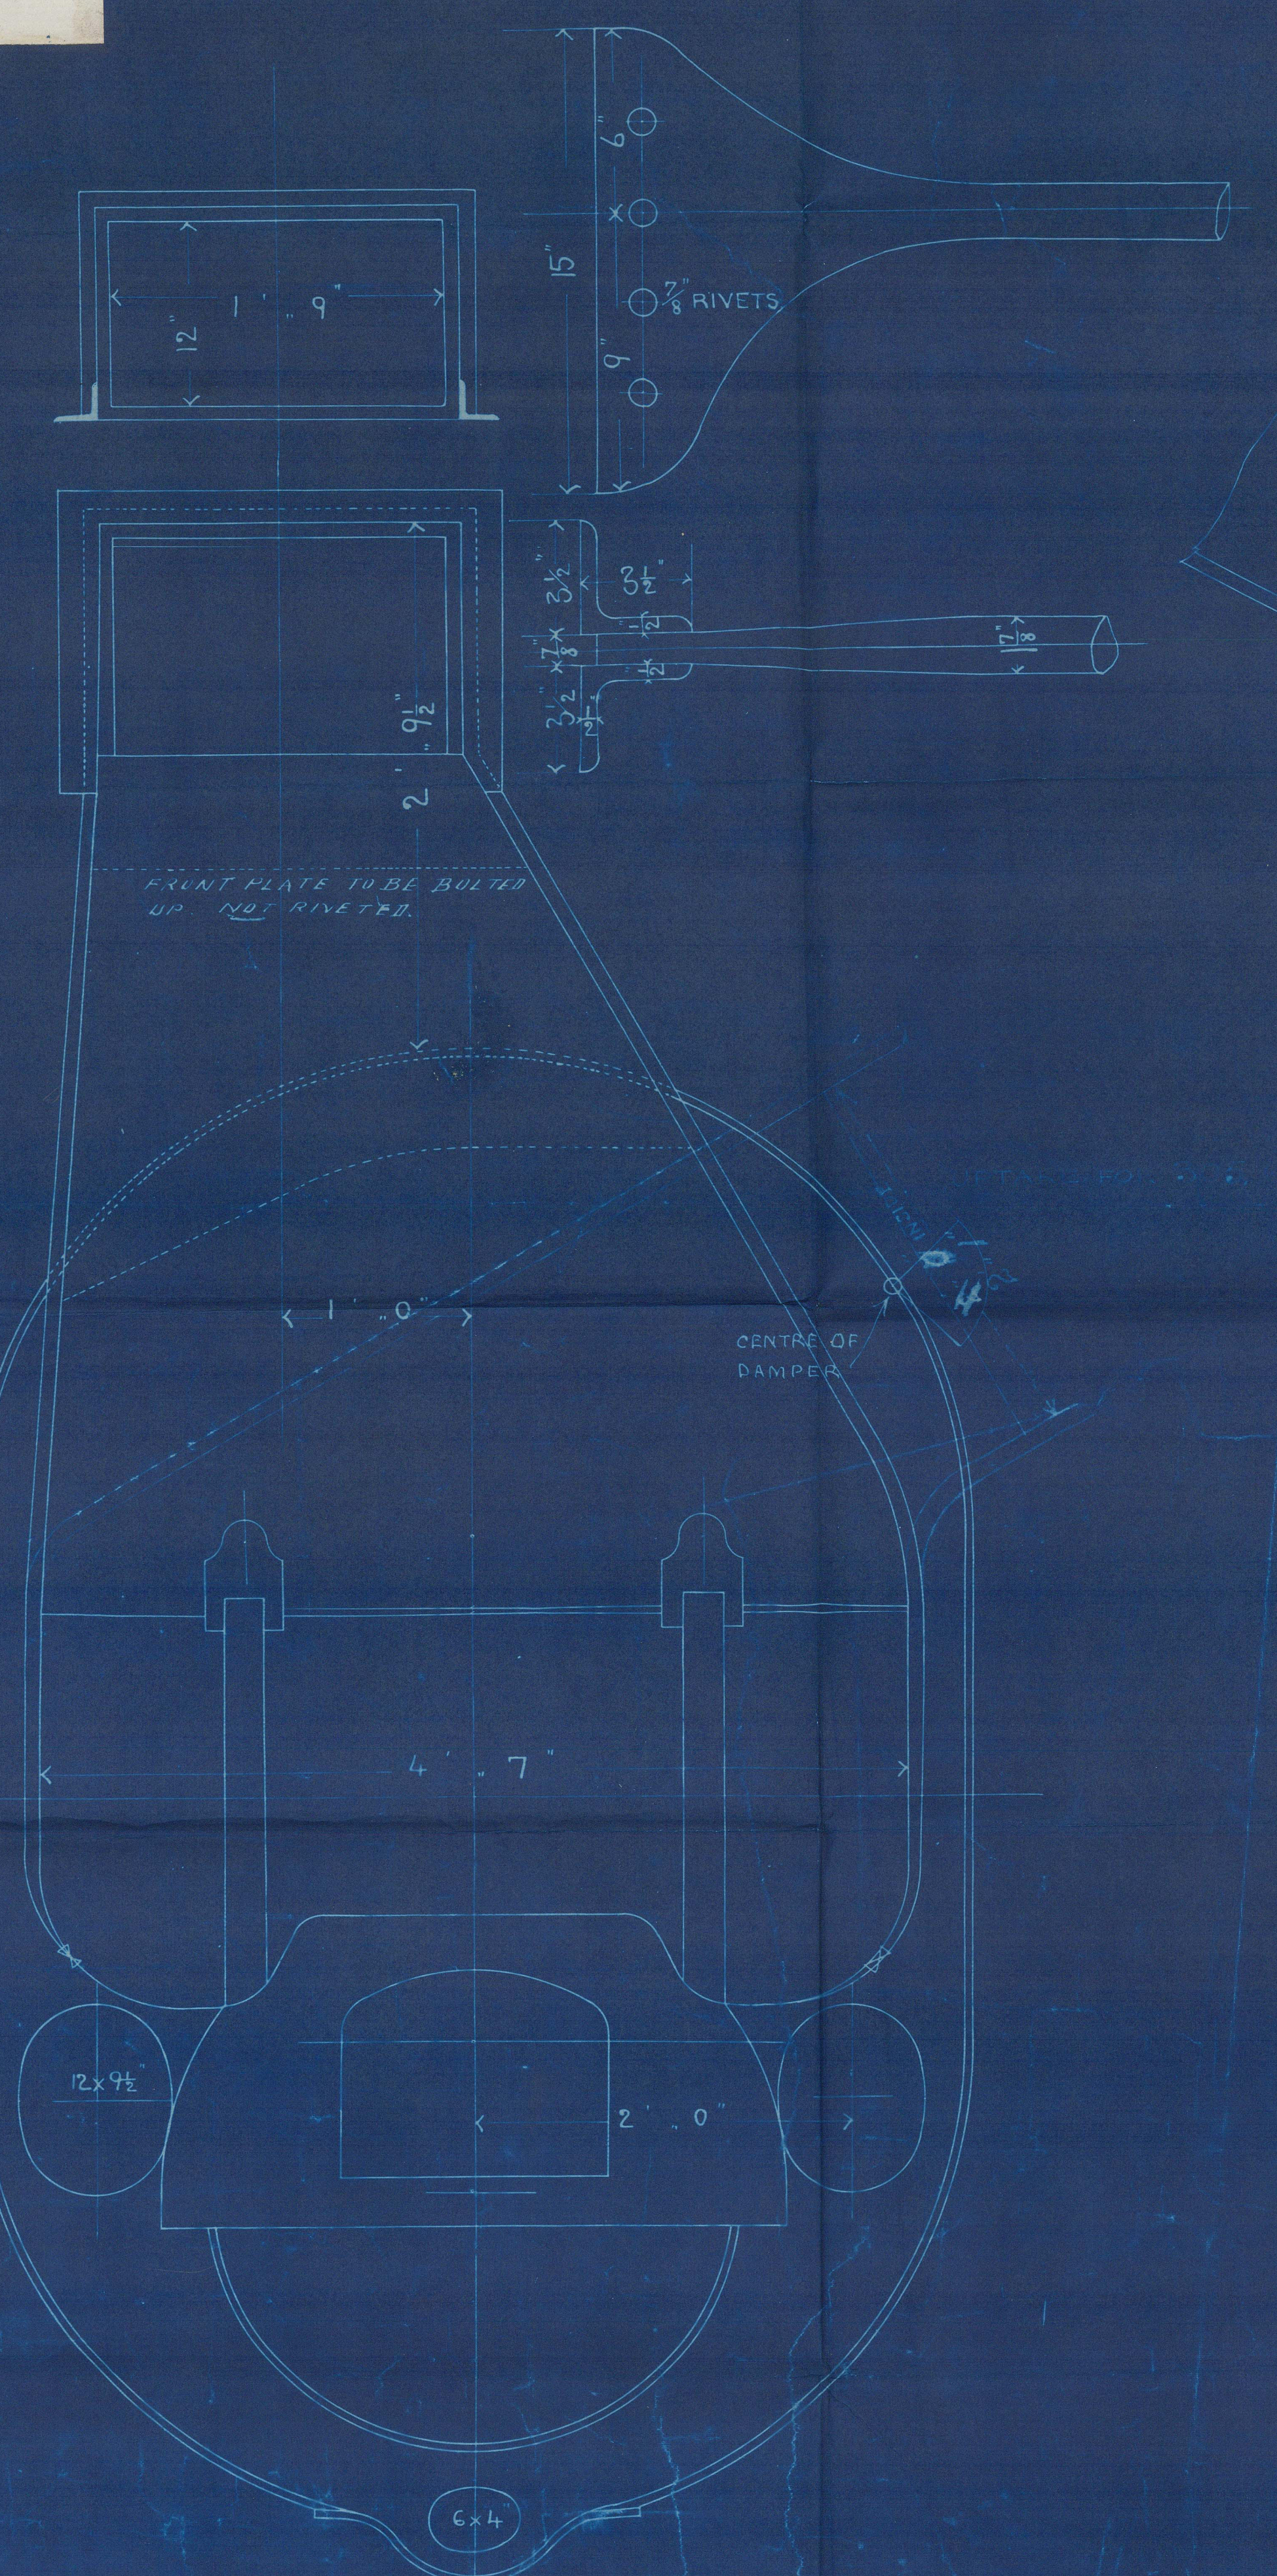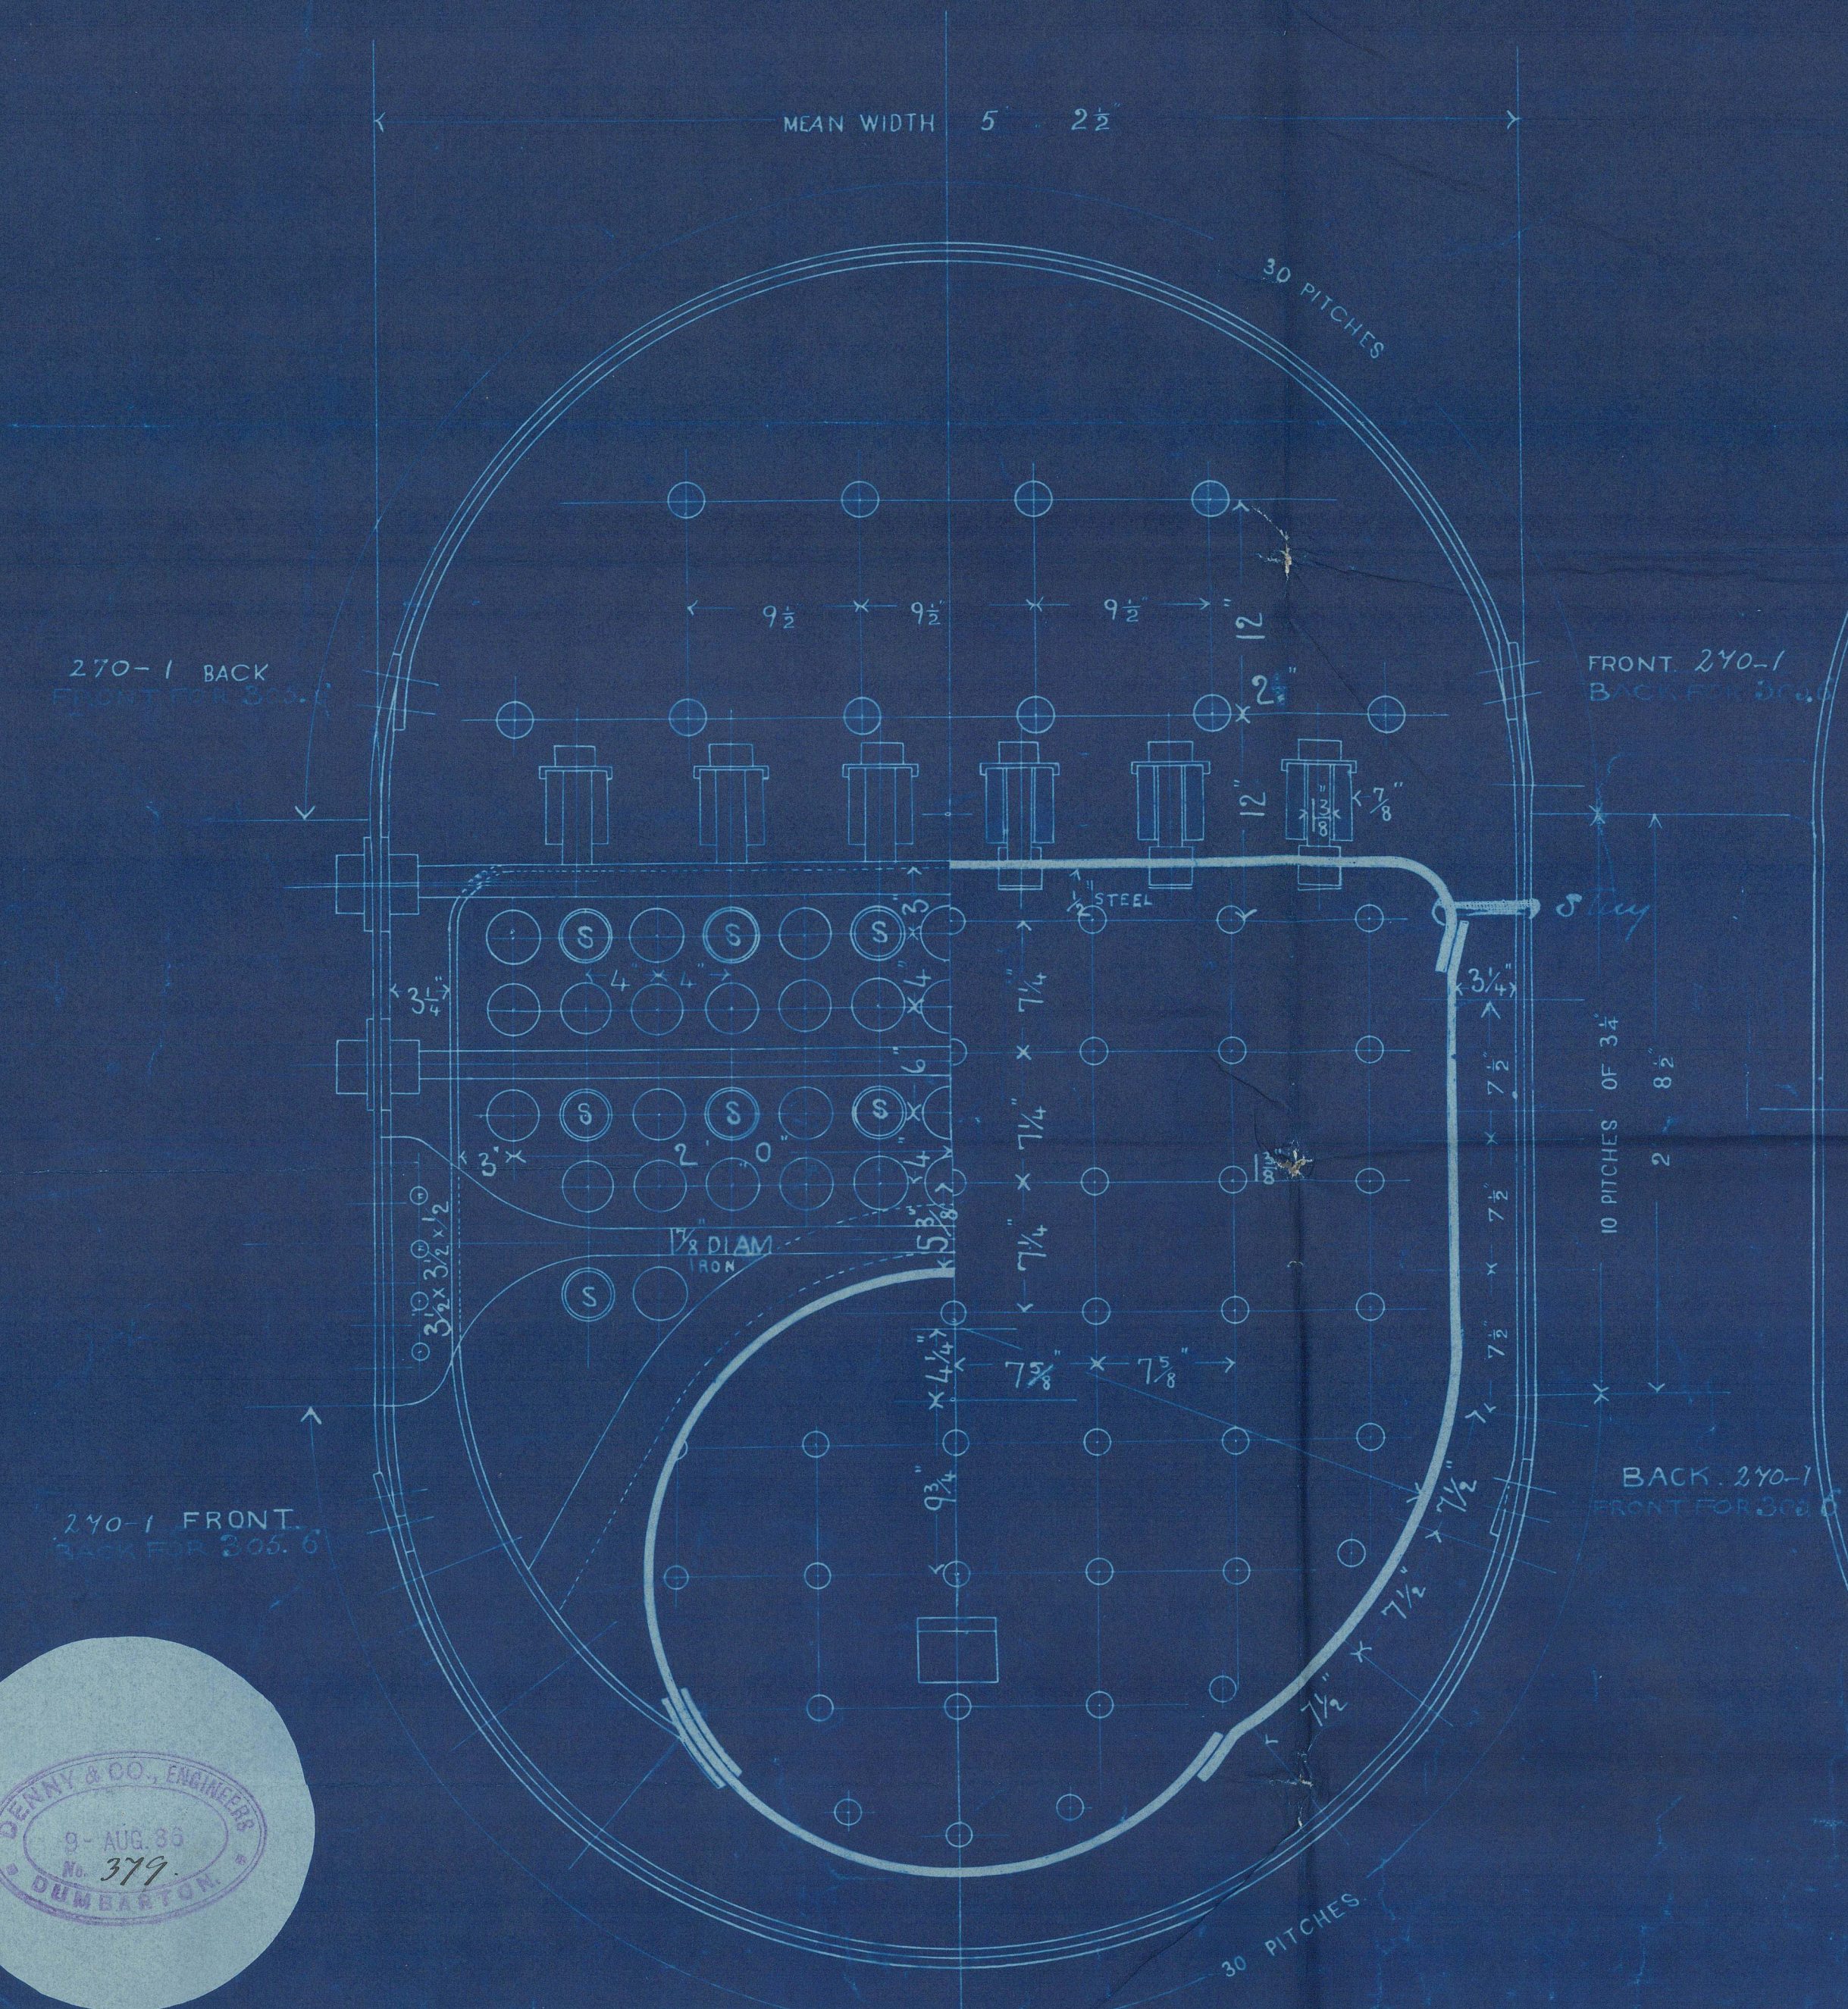

DONKEY BOILER,
Nos 270-1. Venus.
Nos 305.6

1/2" SCALE.