

Lloyd's Register of British and Foreign Shipping.

(Report on Vessel No. 4588 Port Glasgow)

S.S. "Finland"

No. 1176

SHIP FORGINGS OR CASTINGS.

I have to report that the undermentioned Iron or Steel Forgings or Castings, manufactured by

The Portland Forge Co. of Kilmarnock

for the Vessel No. 242, being built by Messrs A. Mc Millan & Son,

of Dumbarton have been inspected by me as set forth below, and found

to be, so far as can be seen, sound and efficient.

The words FORGINGS or CASTINGS, IRON or STEEL, should be struck out as may be required.

Mark on Forgings.

Lloyd's
No. 1176
G. N.


George Newcomb.

Glasgow.

28/5/86.

	STERN FRAME.	RUDDER FRAME.	STEM.
Material*	/	Scrap iron	/
How made	/	Forged	/
Dimensions	/	5 1/2 and 3"	/
Progress on Inspection	/	Forging and smithing	/
Dates when Inspected	/	18.26/3/86. 20.24.30/4/86. 4.10.17.24/5/86.	/

SKETCHES OF FRAMES SHEWING POSITION AND DESCRIPTION OF WELDS OF FORGINGS, OR PARTICULARS OF TESTS APPLIED TO CASTINGS.

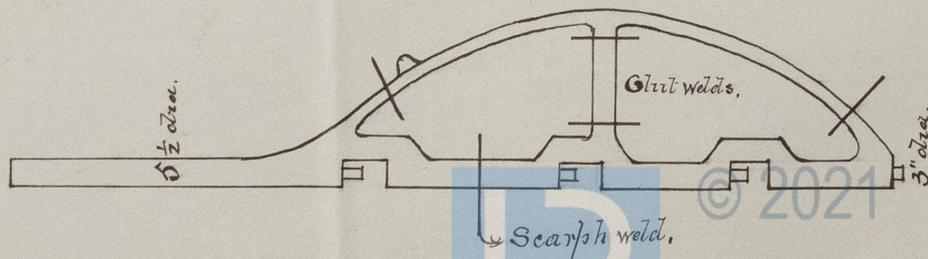

* If of Iron, state whether scrap or puddled iron.

✓











© 2021

Lloyd's Register
Foundation