

Lloyd's Register of British and Foreign Shipping.

(Report on Vessel No. 4588 Port Glasgow)

S. S. Finland

No. 1146

SHIP FORGINGS OR CASTINGS.

The words FORGINGS or CASTINGS, IRON or STEEL, should be struck out as may be required.

We have to report that the undermentioned Iron ~~or Steel~~ Forgings ~~or Castings~~, manufactured by The Portland Forge Co of Kilmarnock for the Vessel No. 242, being built by Messrs A. McMillan & Son of Dumbarton have been inspected by us as set forth below, and found to be, so far as can be seen, sound & efficient.


Mark on Forgings.

Lloyd's
No. 1146

George Newcomb.
W. J. Mumford
Glasgow 19/3/86.

	STERN FRAME.	RUDDER FRAME.	STEM & Keel
Material*	Scrap iron	/	Scrap iron
How made	Forged		Forged
Dimensions	$4\frac{1}{2} \times 4\frac{3}{4}$		$4\frac{1}{2} \times 2\frac{3}{8}$
Progress on Inspection	Forging & smithing		Forging
Dates when Inspected	{ 14.20.25/1/86. 2.9.15.19/2/86. 4.9/3/86.		18.23.25.30/12/85.

SKETCHES OF FRAMES SHEWING POSITION AND DESCRIPTION OF WELDS OF FORGINGS, OR PARTICULARS OF TESTS APPLIED TO CASTINGS.

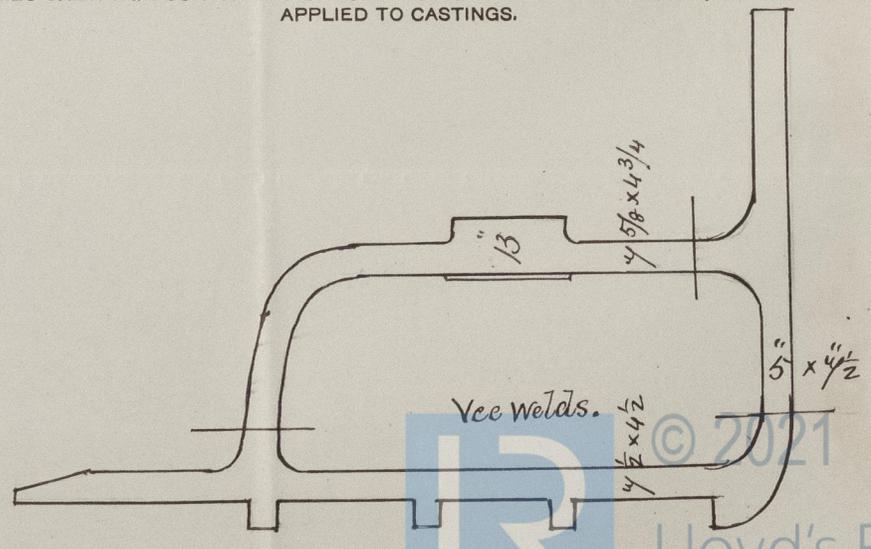

* If of Iron, state whether scrap or puddled iron.