




9.3.86.

STEEL SPARS OF SAILING BARQUE N<sup>o</sup> 301. Bk "Kinfauns" Glasgow Report N<sup>o</sup> 4648.

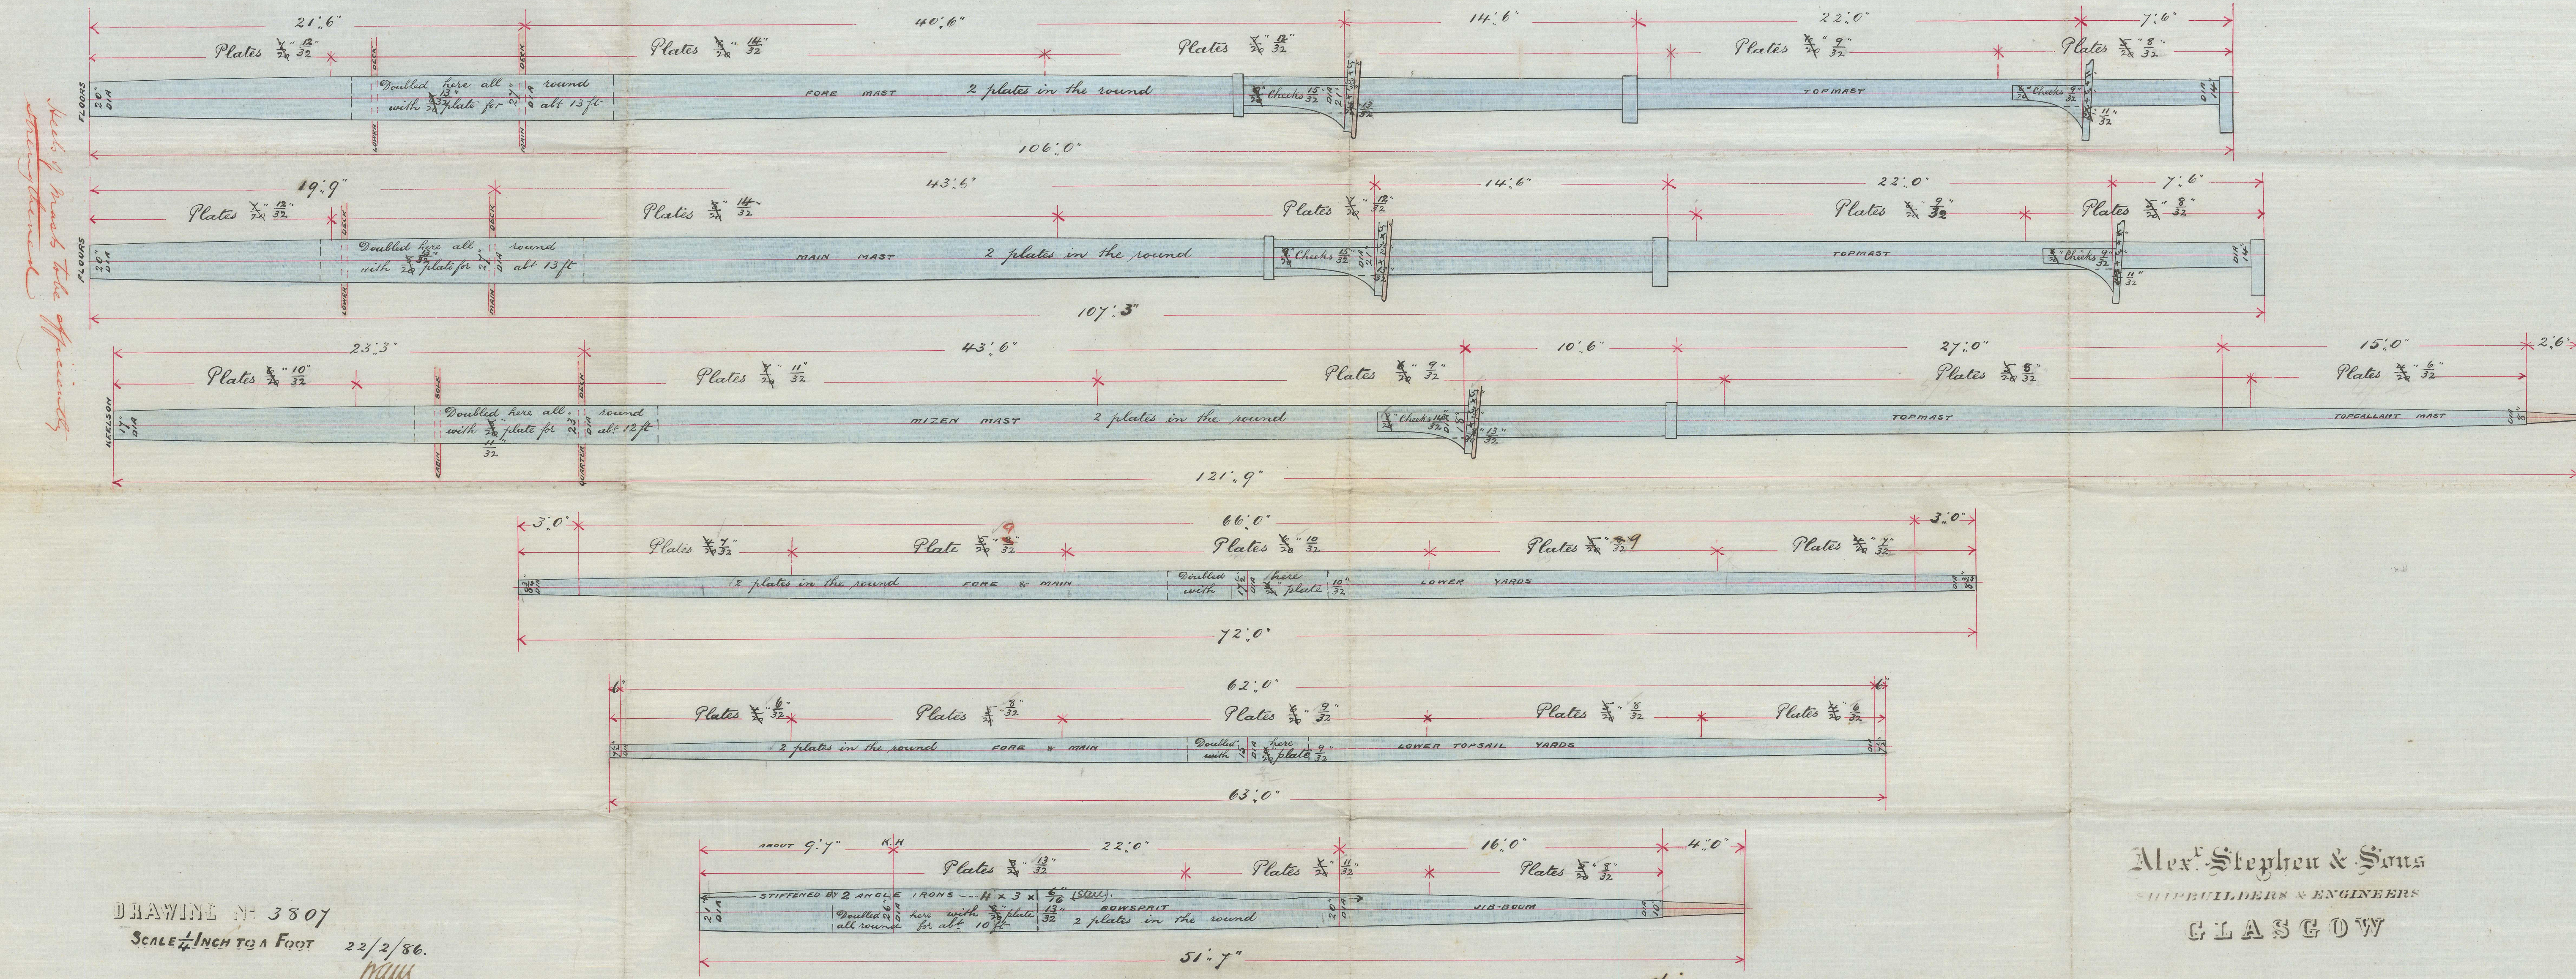

DRAWING N<sup>o</sup> 3807  
SCALE  $\frac{1}{4}$  INCH TO A FOOT

22/2/86.  
MAM

J.L. lds. 6/3/86

J.H. 9/3/86

Note:- All the butts to be  $\frac{1}{2}$ " thicker than the plates they connect and well riveted with last row of rivets complete. The landing edges double riveted (zigzag)

Alex. Stephen & Sons  
SHIPBUILDERS & ENGINEERS  
GLASGOW