

The words FORGINGS or CASTINGS, IRON or STEEL, should be struck out as may be required.

Received at

Office,

18

Lloyd's Register of British and Foreign Shipping.

(Report on Vessel No. 4648 Port Glasgow)

BK "Kinfauns."

No. 1201

SHIP FORGINGS OR CASTINGS.

I have to report that the undermentioned Iron ~~or Steel~~ Forgings ~~or Castings~~, manufactured by Messrs Stephens & Sons of Glasgow, for the Vessel No. 301, being built by them of — have been inspected by me as set forth below, and found to be, so far as can be seen, sound and efficient

Mark on Forgings.

Lloyd's

No. 1201

G.N.


George Newcomb.

Glasgow.

8/5/86.

	STERN FRAME.	RUDDER FRAME.	STEM.
Material* - - - -		Scrap iron	
How made - - - -		Forged	
Dimensions - - - -		5" dia	
Progress on Inspection -		Forging & smithing	
Dates when Inspected		17.24/3/86. 15.22.27/4/86 6/4/86.	

SKETCHES OF FRAMES SHEWING POSITION AND DESCRIPTION OF WELDS OF FORGINGS, OR PARTICULARS OF TESTS APPLIED TO CASTINGS.

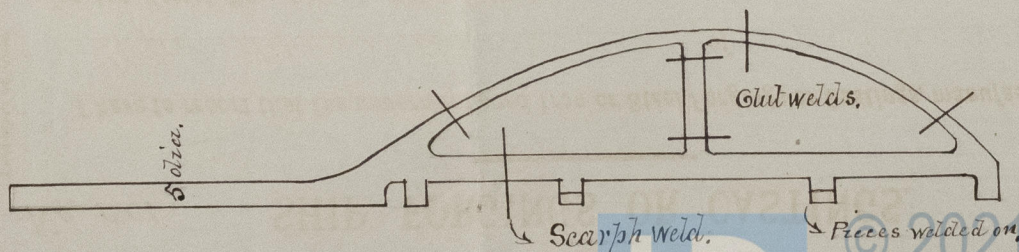

* If of Iron, state whether scrap or puddled iron.