

Lloyd's Register of British and Foreign Shipping.

(Report on Vessel No. 4648 Port Glasgow)

BK "Kinfauns"

No. 1201

SHIP FORGINGS OR CASTINGS.

I have to report that the undermentioned Iron ~~or Steel~~ Forgings ~~or Castings~~, manufactured by

Messrs. A. Stephens & Sons of Glasgow

for the Vessel No. 301, being built by them

of _____ have been inspected by me as set forth below, and found

to be, so far as can be seen, sound and efficient.

The words FORGINGS or CASTINGS, IRON or STEEL, should be struck out as may be required.

Mark on Forgings.

Lloyd's
No. 1201
G.N.


George Newcomb
Glasgow.

Post

19/3/86.

	STERN FRAME.	RUDDER FRAME.	STEM & Keel
Material*	<u>Scrap iron</u>	/	<u>Scrap iron</u>
How made	<u>Forged</u>		<u>Forged</u>
Dimensions	<u>4 1/4 x 2 3/8</u>		<u>Stem 4 1/4 x 2 3/8 Keel 8 x 2 3/8</u>
Progress on Inspection	<u>Forging & smithing</u>		<u>Forging</u>
Dates when Inspected	<u>22/2/86. 2.17/3/86.</u>		<u>8.16.22/2/86. 2.17/3/86.</u>

SKETCHES OF FRAMES SHEWING POSITION AND DESCRIPTION OF WELDS OF FORGINGS, OR PARTICULARS OF TESTS APPLIED TO CASTINGS.

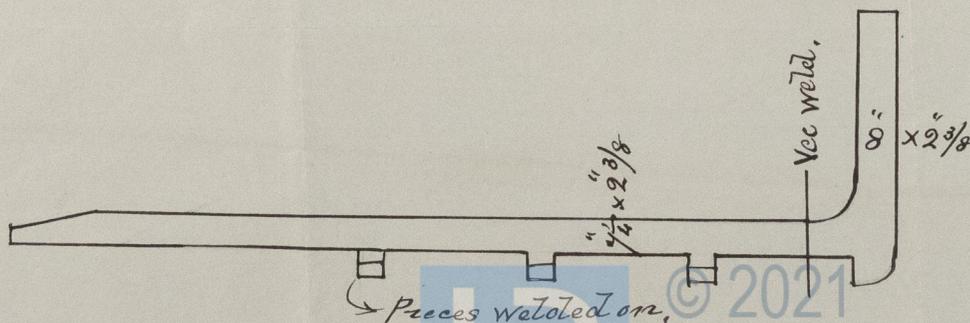

* If of Iron, state whether scrap or puddled iron.