




7/1/86.
5.3.86.

STEEL SAILING BARQUE
Nº 301

Bk. "Winfauns" Glasgow Report Nº 4648. —

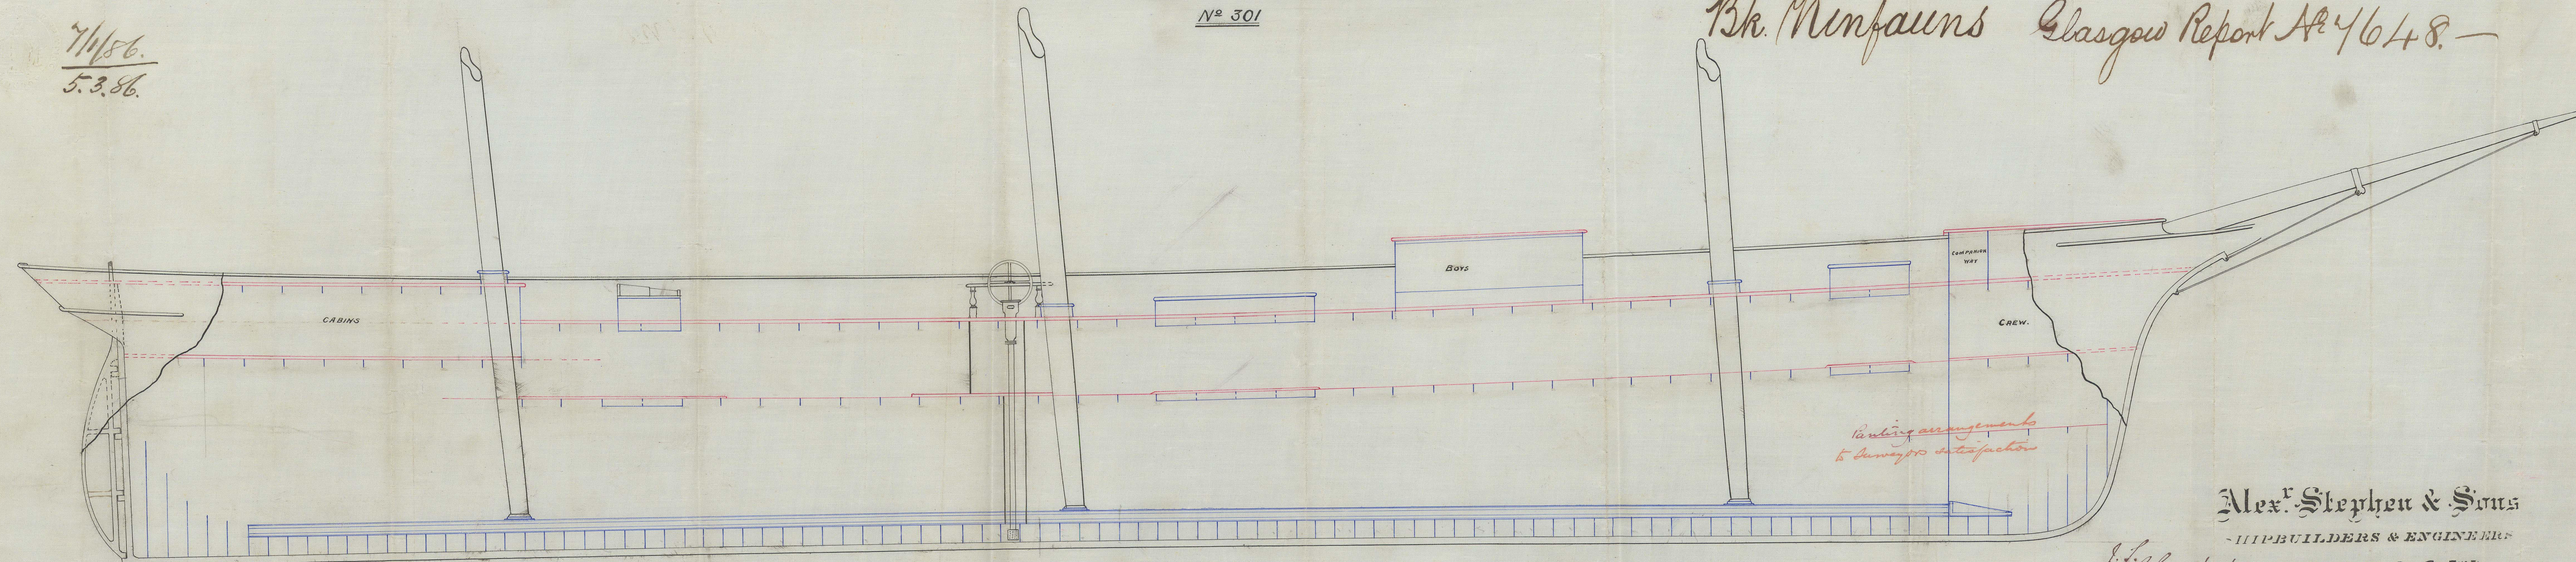

SCALE 1/8 INCH TO A FOOT

Alex^r. Stephen & Sons
SHIPBUILDERS & ENGINEERS
GLASGOW
DRAWING Nº 3753

J. L. 31/12/85



© 2021
Lloyd's Register
Foundation