


15.4.86.

9th April 1886

S. S. "Wainui" Glasgow Report No. 4664.—

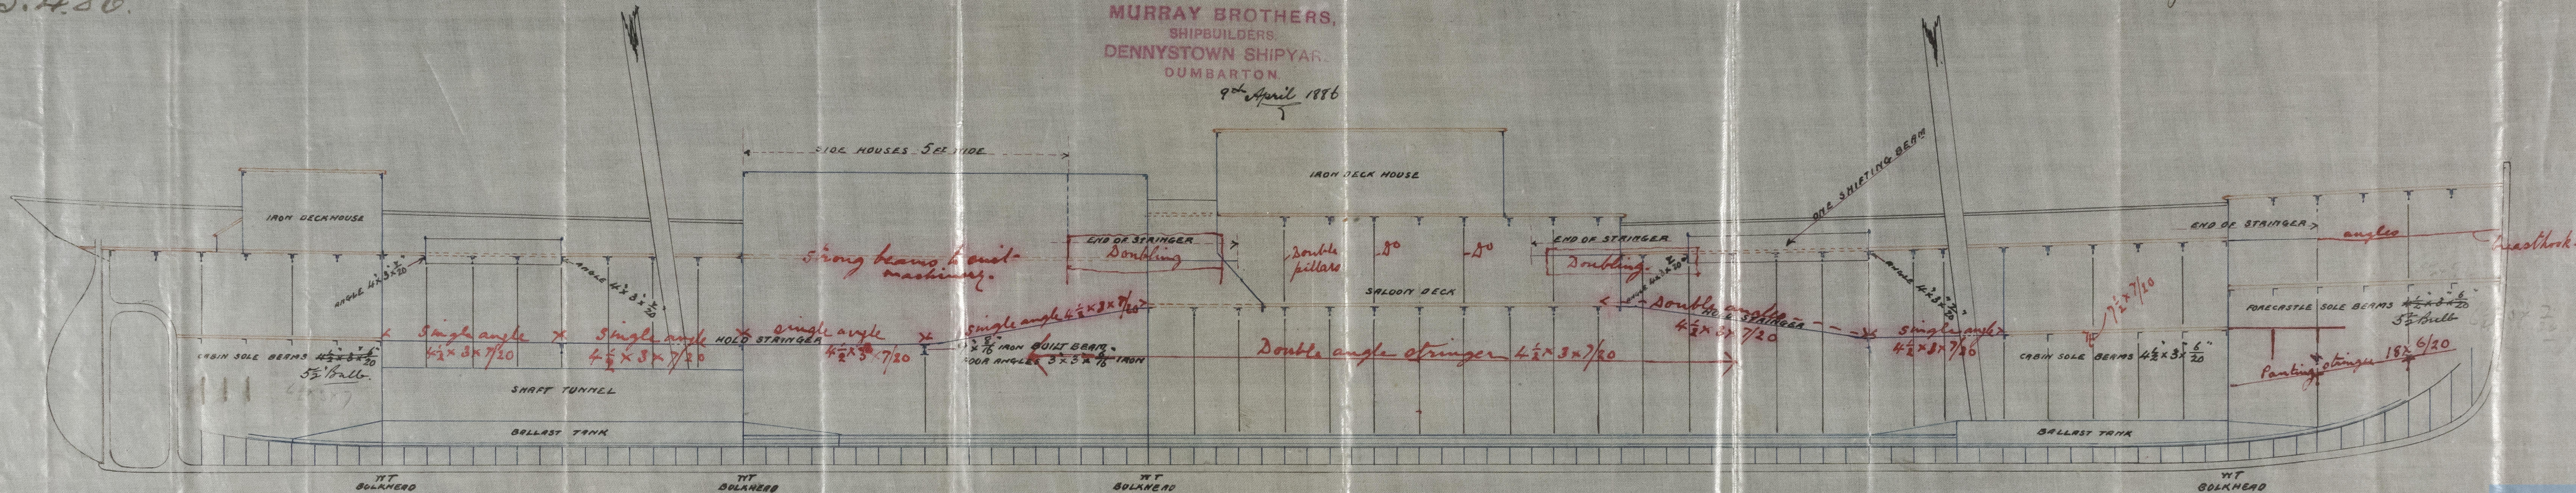

J. H. L.
14/4/86