




4/8/86

Plan showing pumping arrangement
of S.S. 408

M. 3/8/86

S.S. "Wainui" Glasgow Report No. 4664.

MURRAY BROTHERS
SHIPBUILDERS
DUNDEE
DUNDEE SHIPYARD
DUNDEE

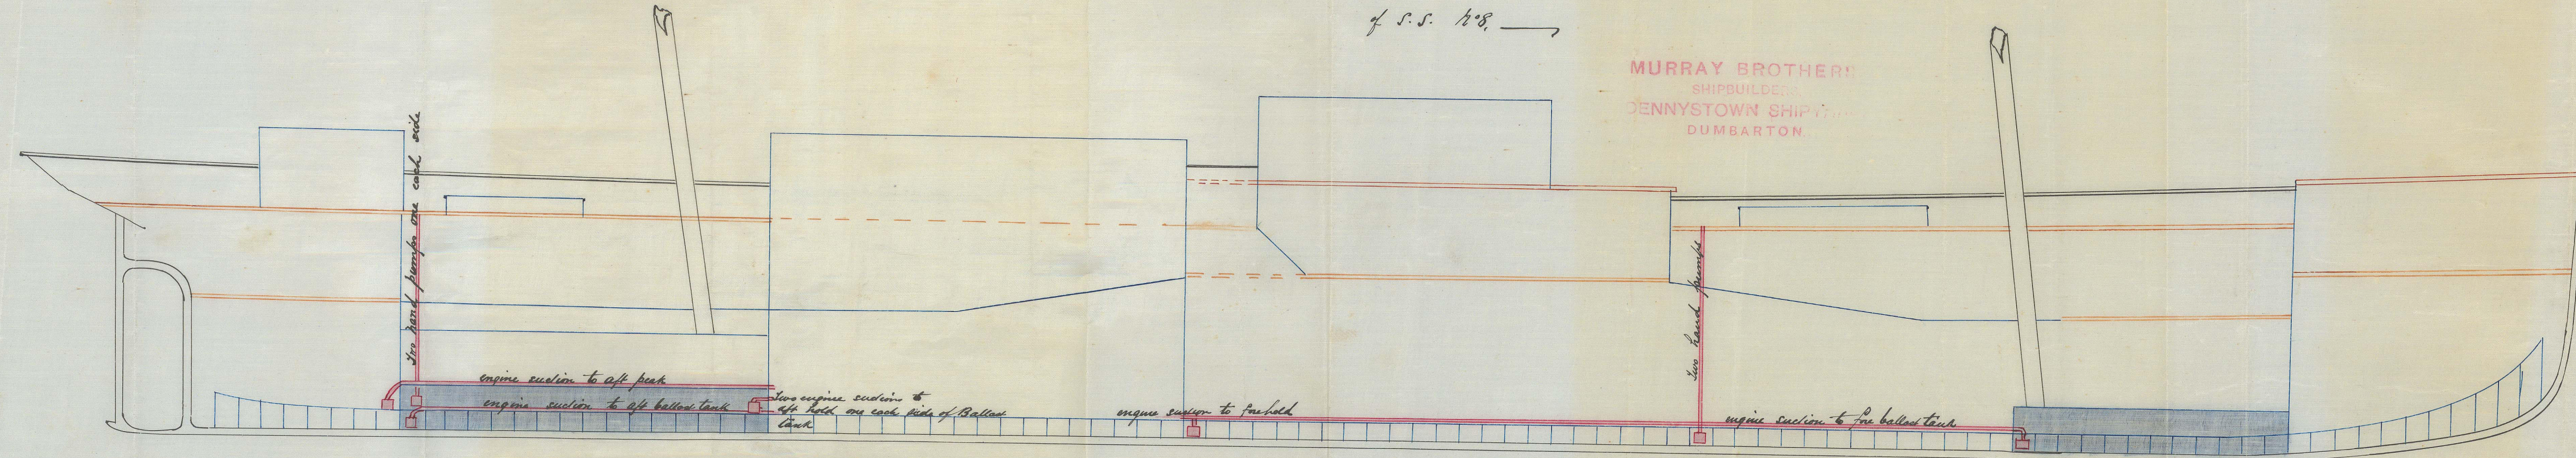

Shut valves to each bulkhead
Sounding pipes to each compartment.