



h<sup>o</sup> 8.

4/8/86


STEEL SCREW STEAMER

194'-0" x 28'-0" x 16'-4 1/2" TOP OF KEEL TO TOP OF BEAM

SCALE  $\frac{1}{2}$  INCH = ONE FOOT

S. S. "Wainui"

Glasgow Report No. 4664.

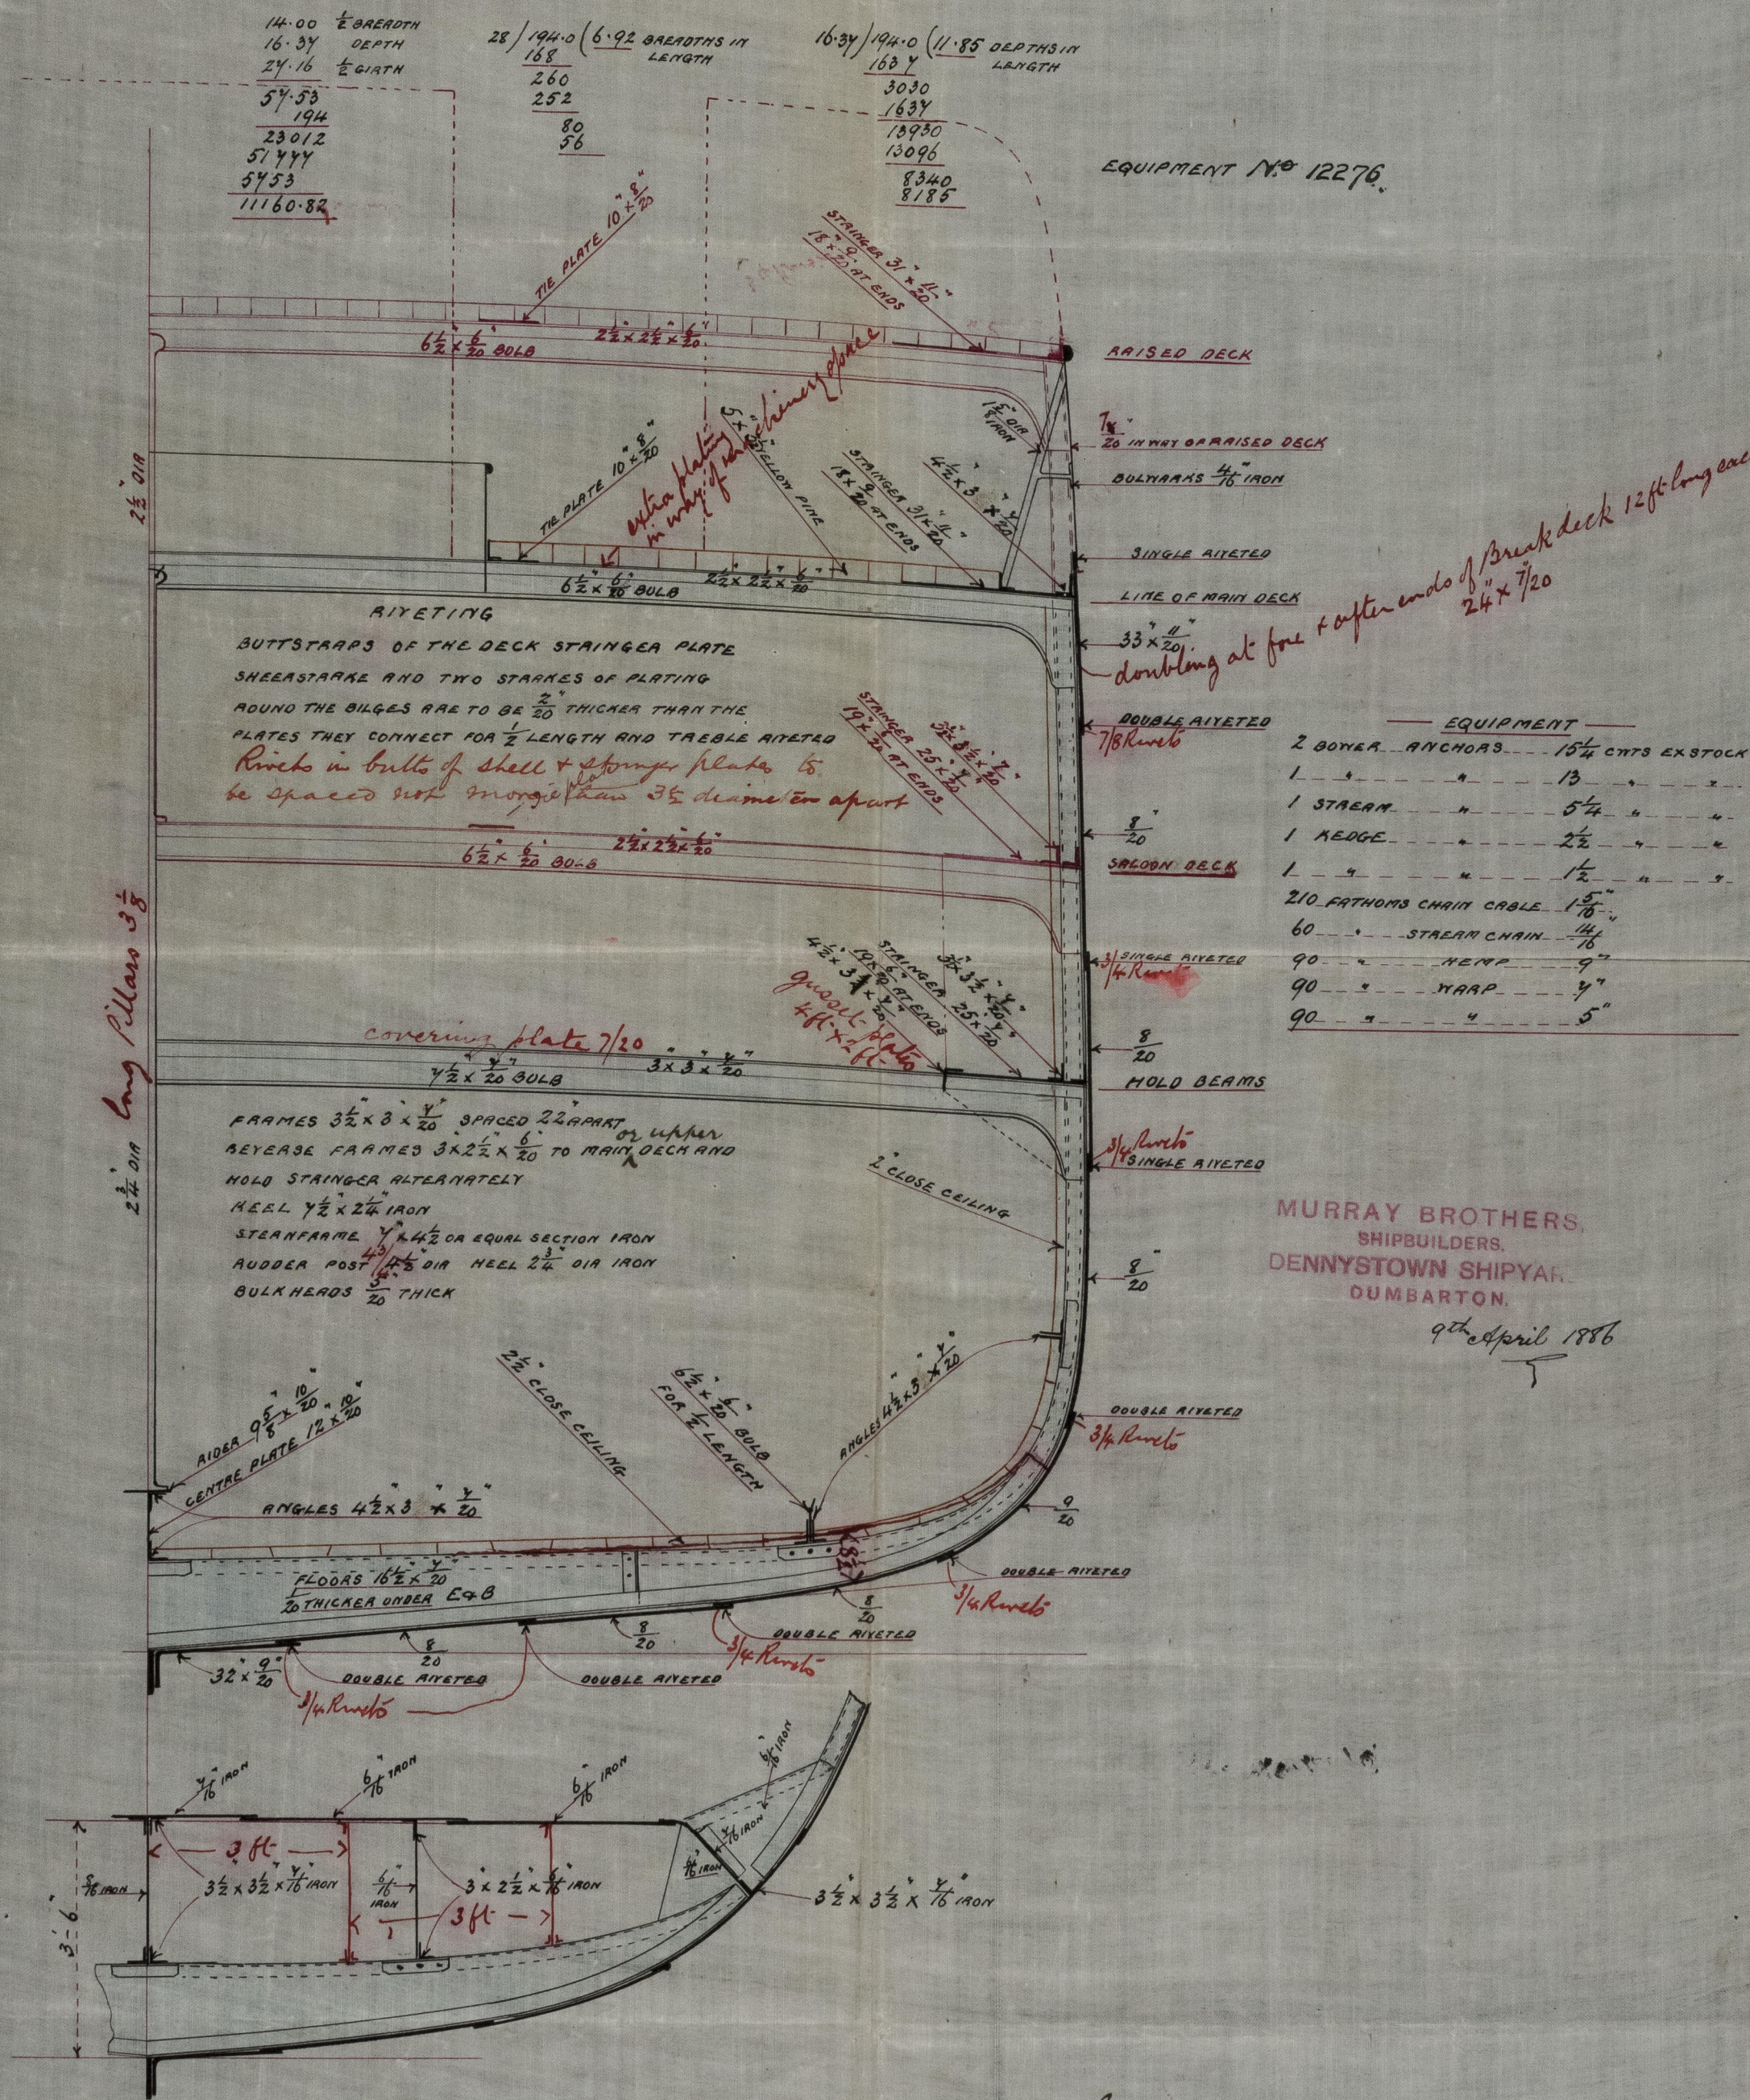

MURRAY BROTHERS  
SHIPBUILDERS.  
DENNYSTOWN SHIPYARD.  
DUMBARTON.

9<sup>th</sup> April 1886

J. V. L.  
14/4/86