

PAID FOR BY  
RECEIVED  
21 APR 86  
LONDON


22/4/86

— Profile of S.S. N<sup>o</sup> 64 —

— Scale 4 inch = One Foot. —

S.S. Marmion


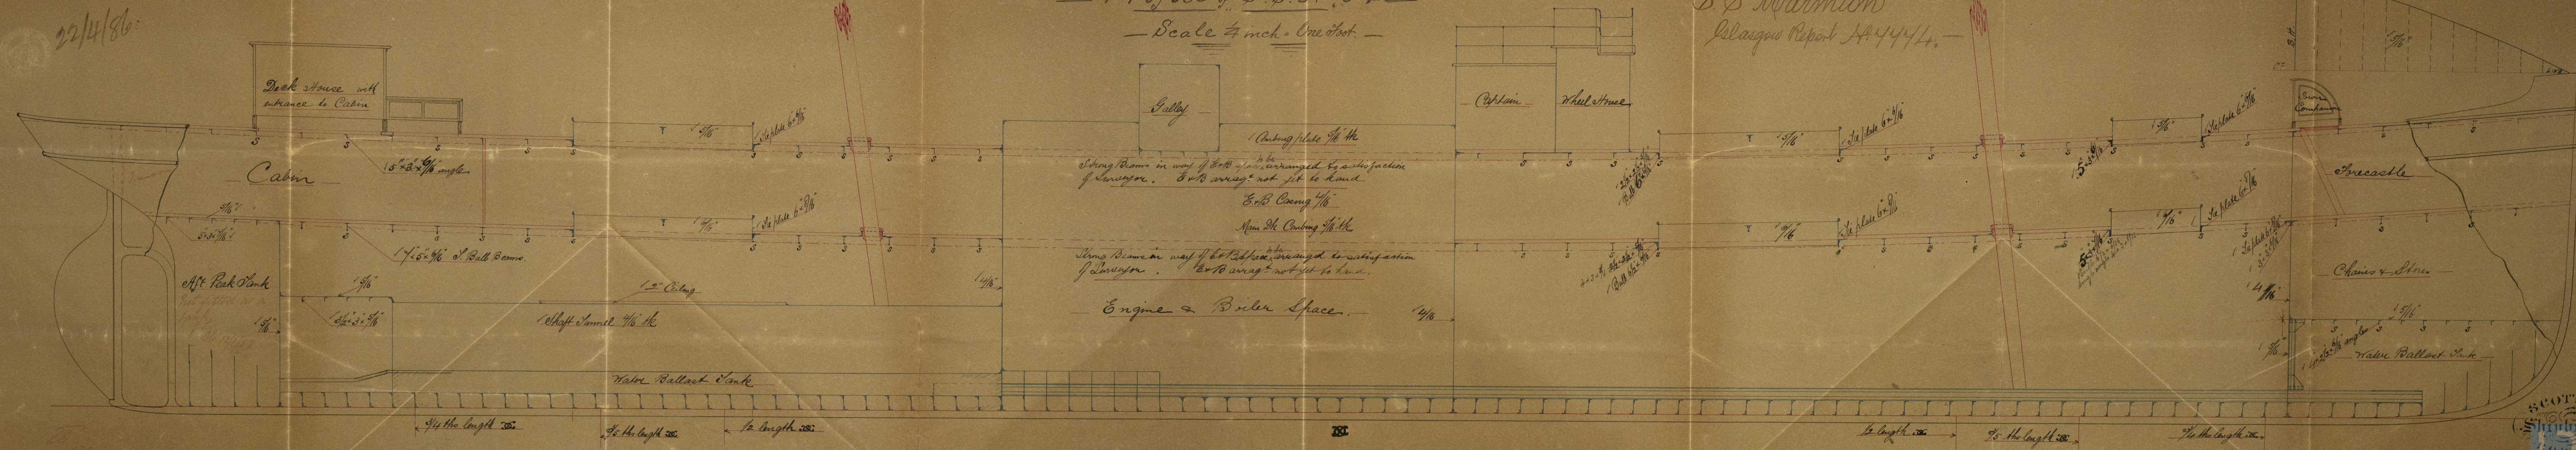

SCOTT & CO.  
SHIPBUILDERS  
18/4/86. Register  
Foundation