
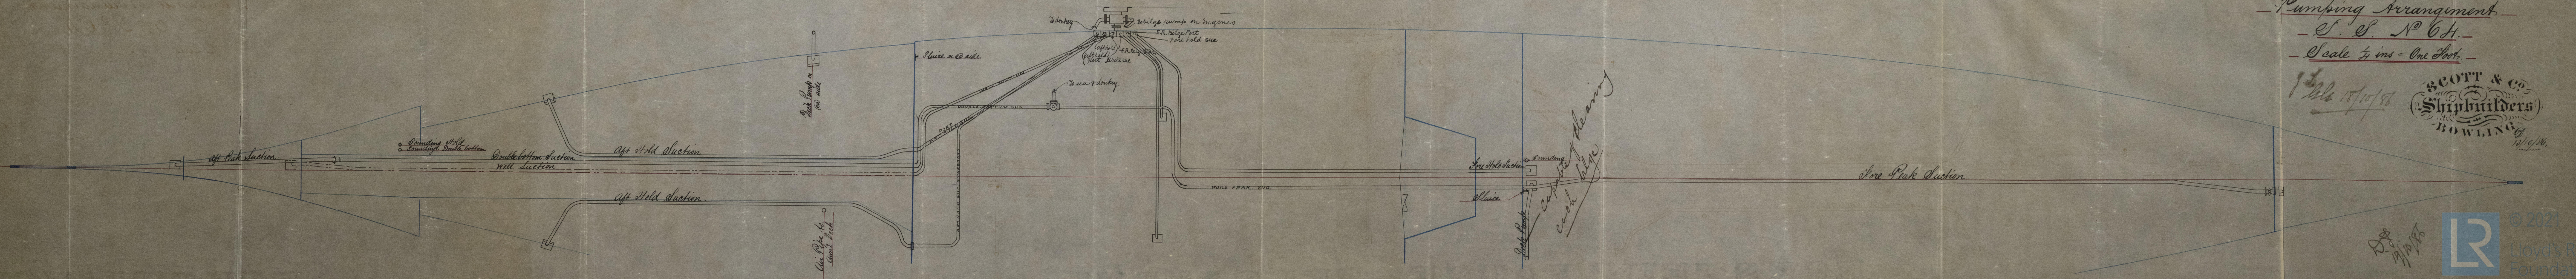


RECEIVED  
19 OCT. 88  
LONDON

Dr: 19/10/88

S.S. "Marmion"  
Glasgow Report No 44/4.

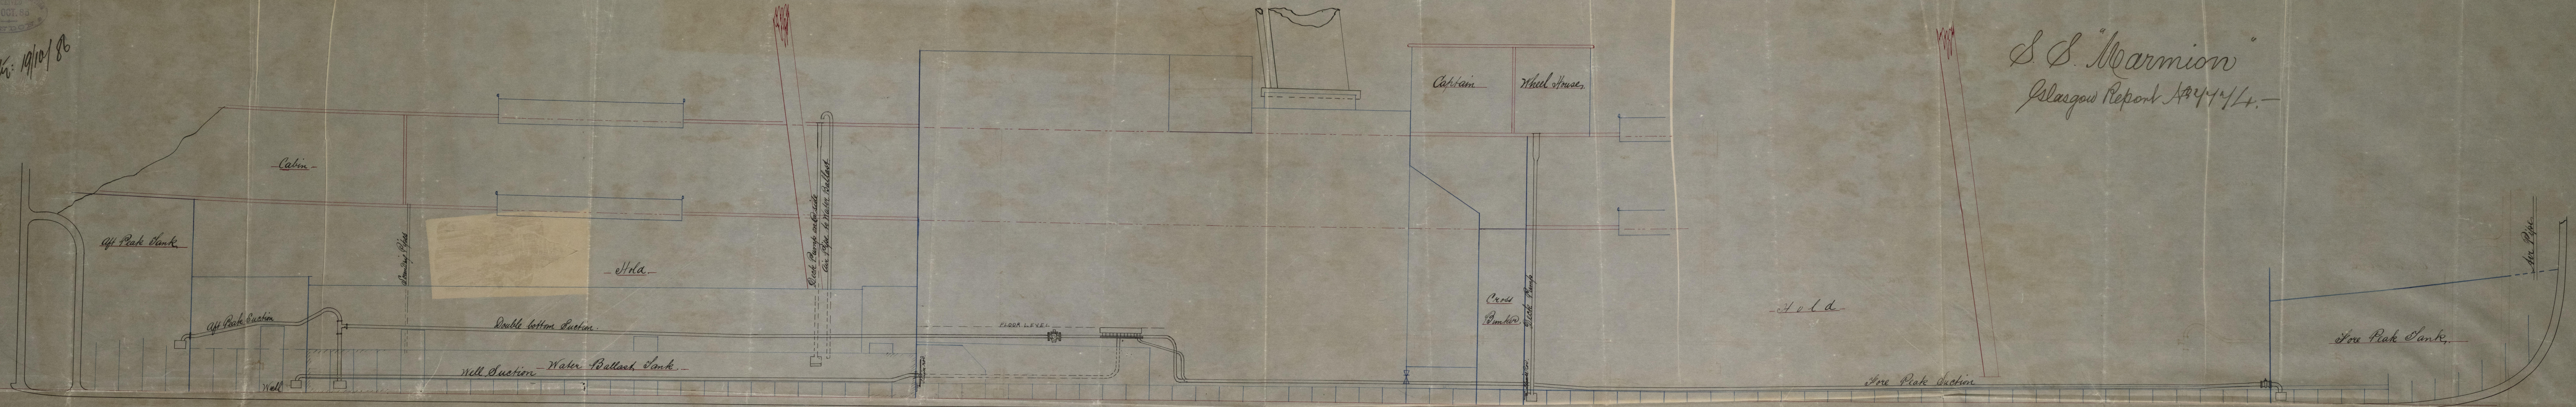

Pumping Arrangement  
S.S. No 64.  
Scale 1/4 ins = One Foot.

15/10/88  
SCOTT & CO  
Shipbuilders  
BOWLING  
13/10/88

Dr: 19/10/88