




22/4/86.

# Midship Section S.S. N<sup>o</sup> 64 — S.S. "Marmion" Glasgow Report A. 4/4/86.

Scale  $\frac{1}{2}$  inch = One Foot

Dimensions 200' 2" x 27' 13" 3" D. M.L. to Main Dk & 20' 6" to Awn<sup>d</sup> Dk

Classed 100. A. 1. Wood Decks.

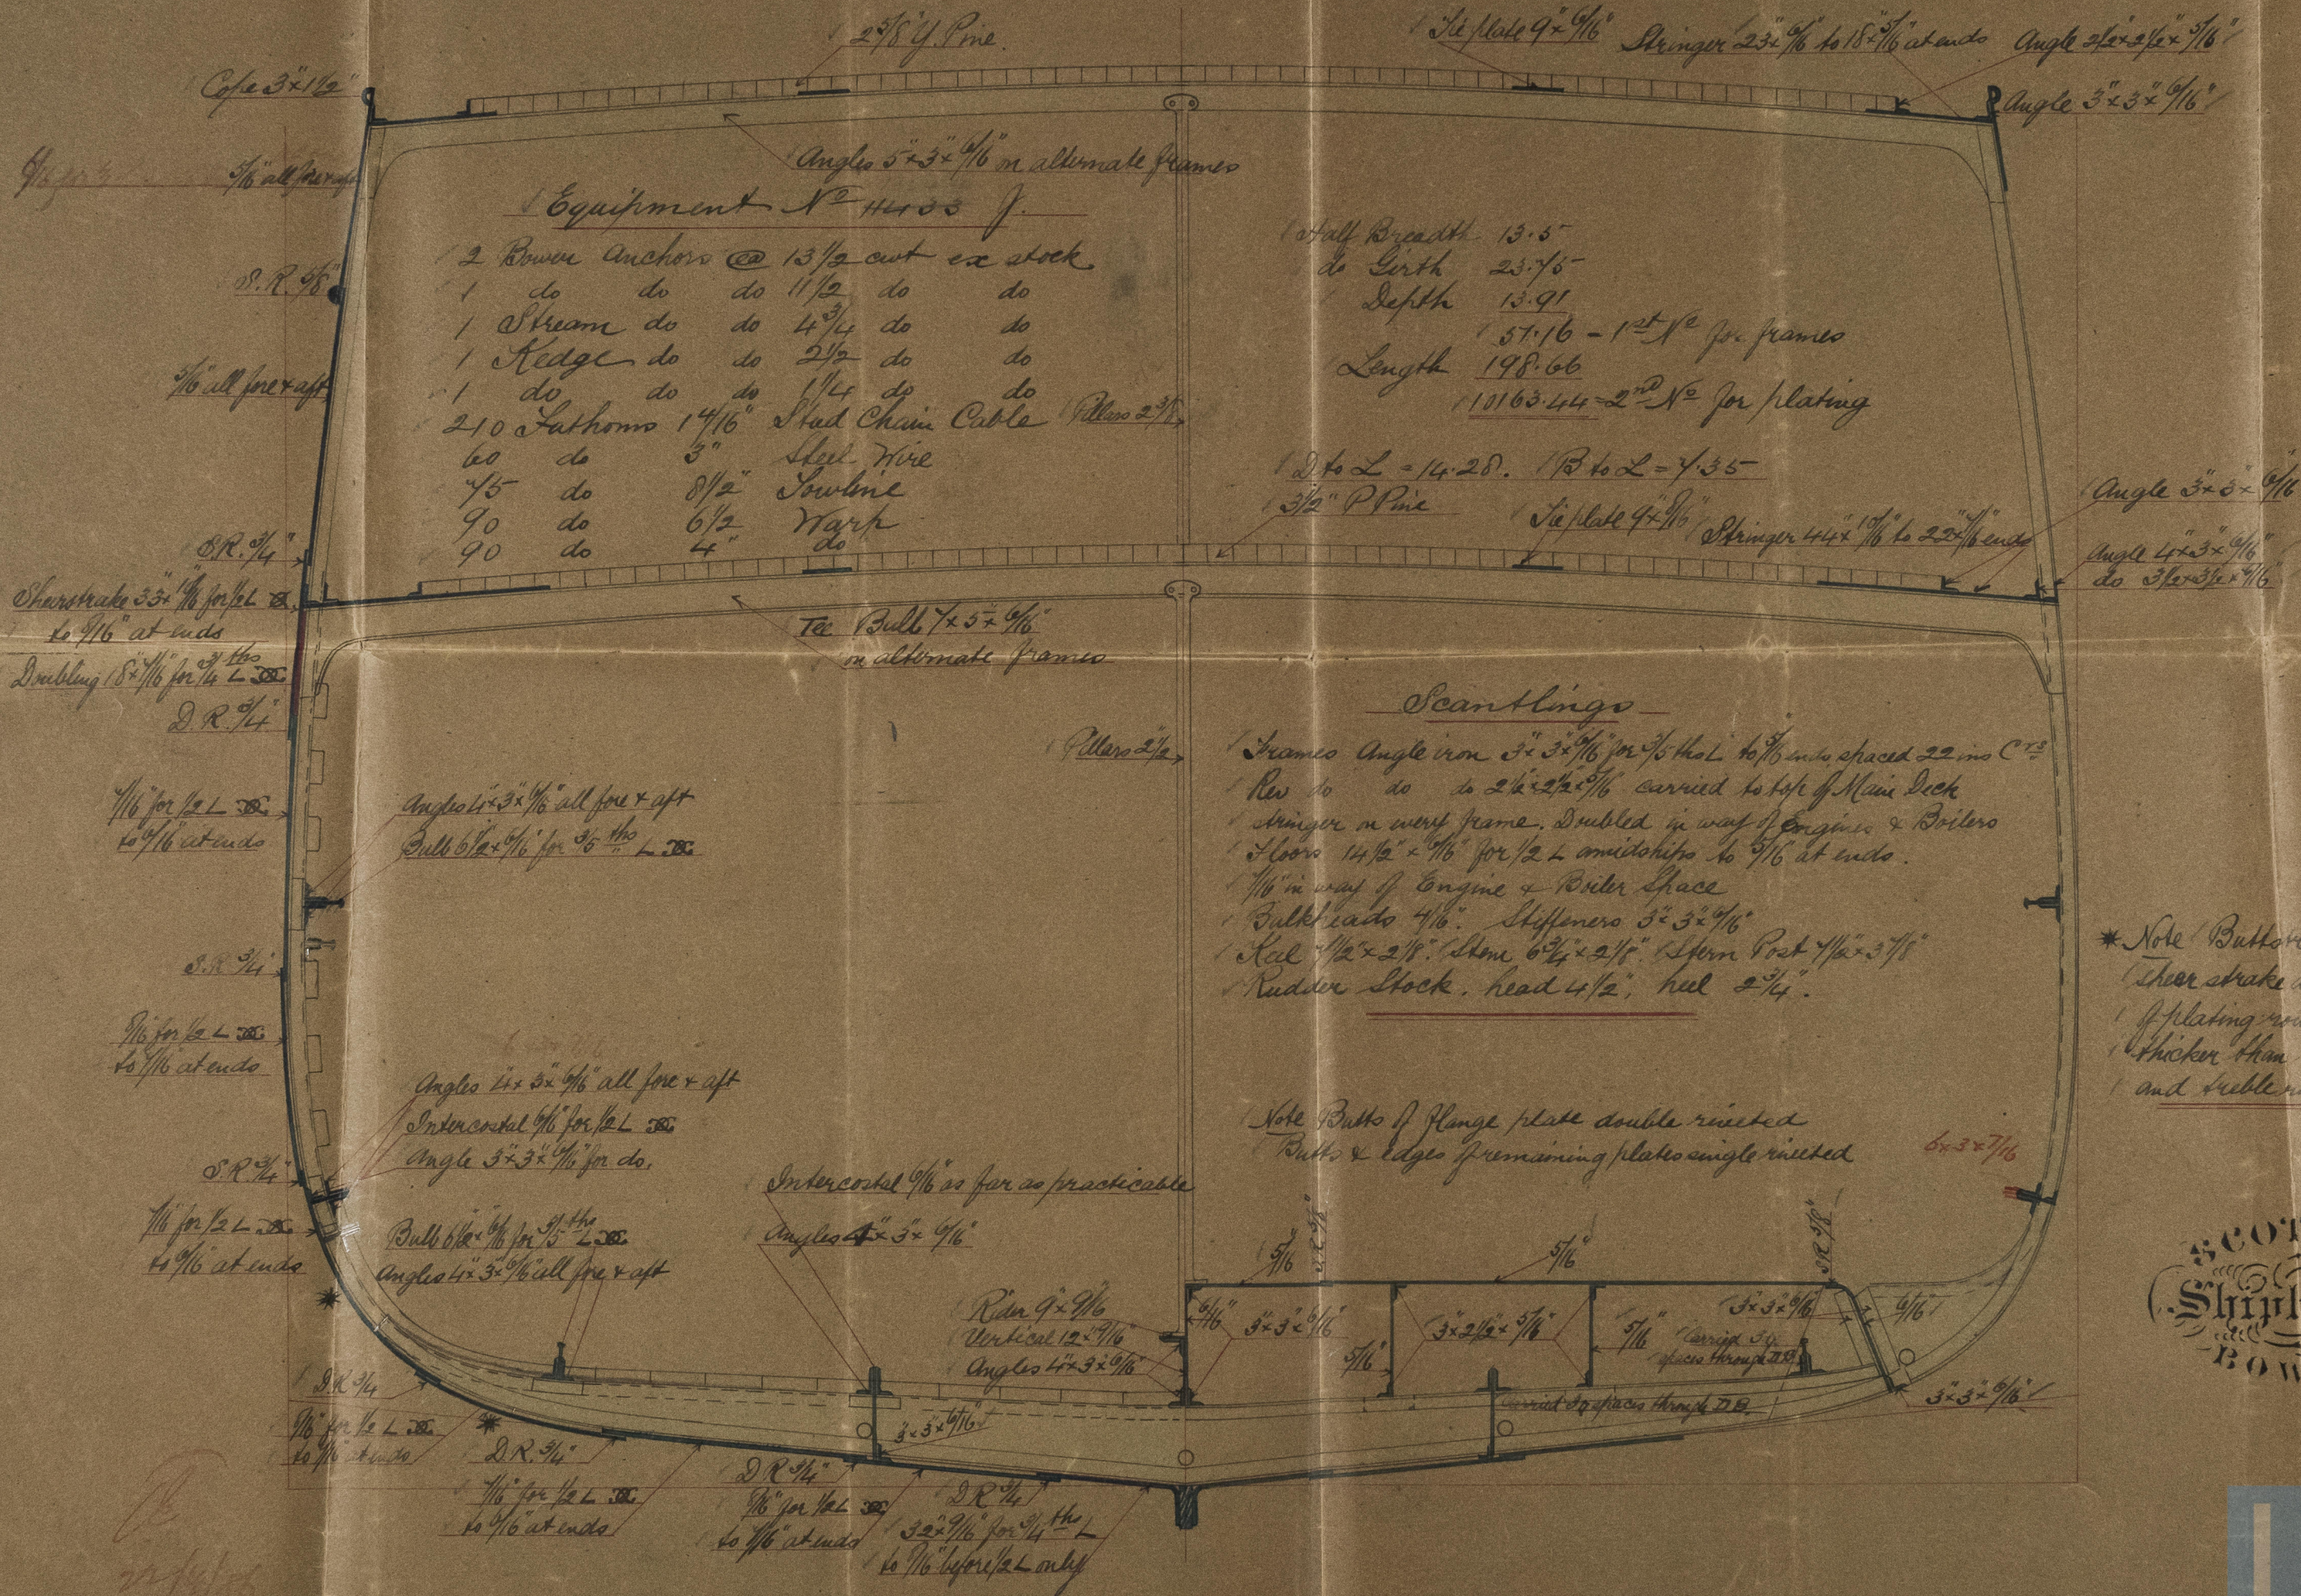

SCOTT & CO  
(Shipbuilders)  
BOWLING

19/4/86  
D.



© 2021

Lloyd's Register  
Foundation