




30/1/86

STEEL MASTS OF SCREW STEAMER N° 299.

S.S. "Queen Victoria" Glasgow Report N° 4484.

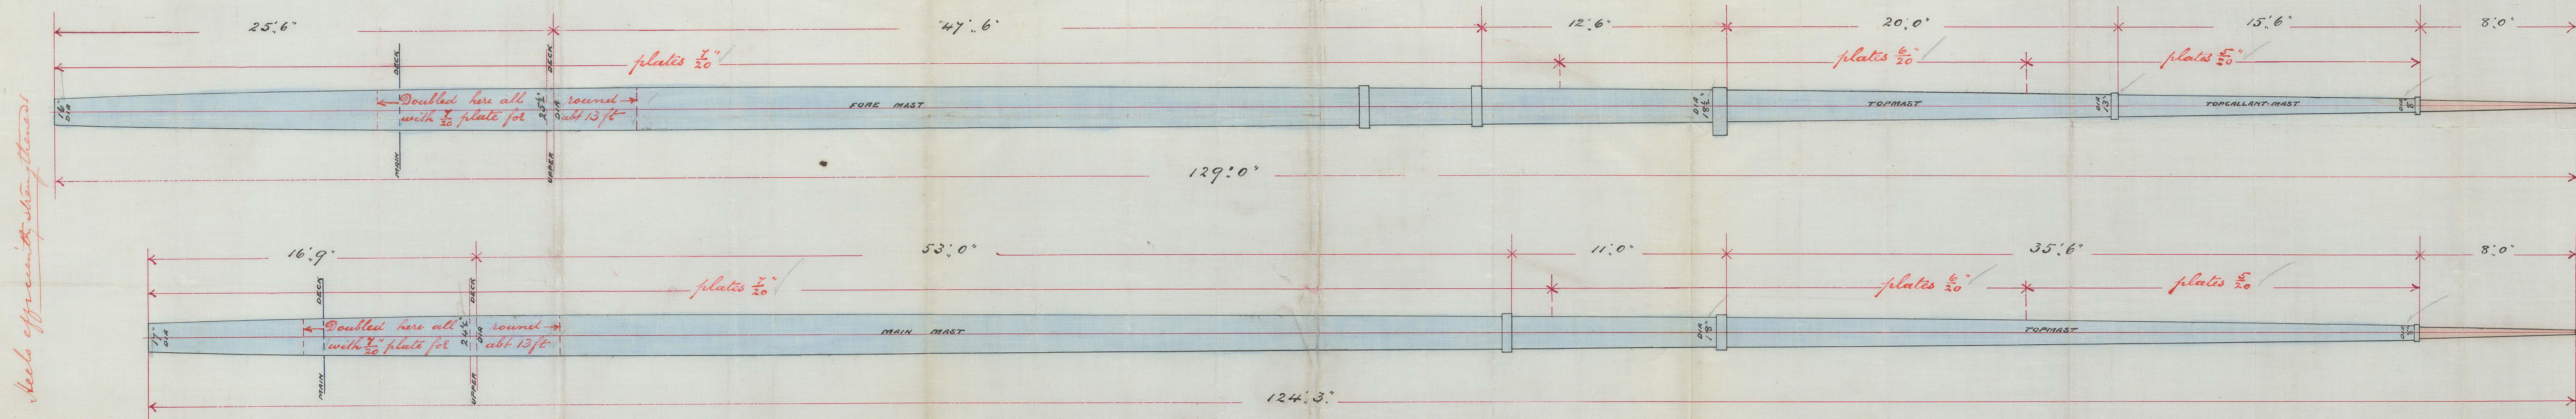

DRAWING N° 3786.

SCALE $\frac{1}{4}$ INCH TO A FOOT

26/1/86

WALL

J.H.
29/1/86

Note.— To have 2 plates in the round, the landings double riveted (zigzag).
All the butt straps to be $\frac{1}{20}$ " thicker than the plates they connect and treble riveted.

Alex. Stephen & Sons
SHIPBUILDERS & ENGINEERS
GLASGOW

J.S.
27/1/86

© 2021

Lloyd's Register
Foundation