




19.11.85

—PROFILE S. S. N^o 299—

S.S. "Queen Victoria" Glasgow Report No. 4484—

24.3.86.

M
23.5.86

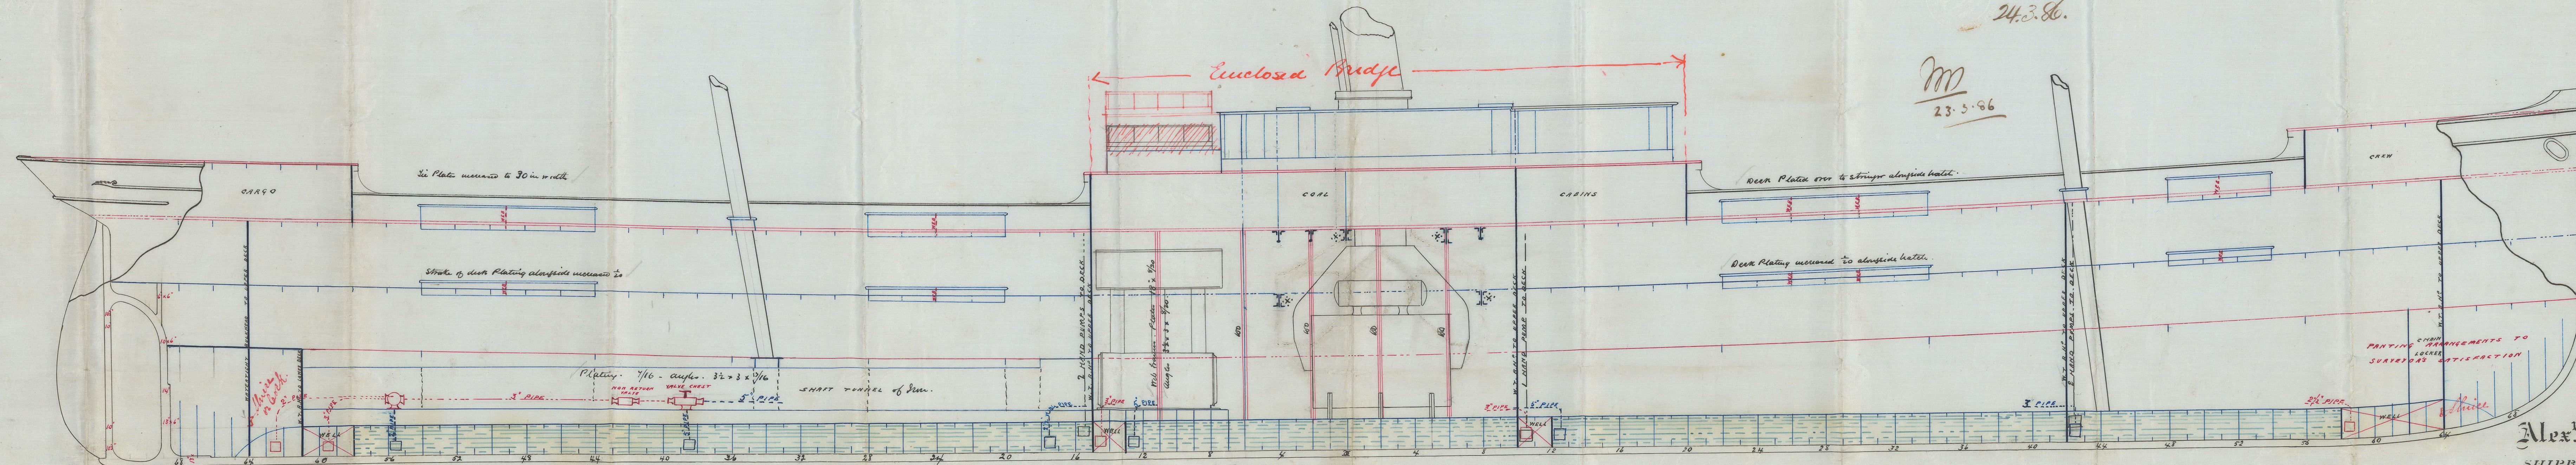

—PUMPING ARRANGEMENT—

HAND PUMPHOLD AS SHOWN IN BLACK 6" CHAMBERS 3" SUCTIONS
BALLAST PUMPS AS SHOWN IN BLUE 5" PIPES AND 2 1/2" WING SUCTIONS
ENGINE HOLD SUCTIONS AS SHOWN IN RED 3" AND 2 1/2" SUCTIONS

SCALE 1/4 INCH TO A FOOT

* Strong Beams of Plate 10 x 80 on Upper deck. angle 3 1/2 x 3 1/2 x 7/16. 4 in no.
60 - - - - - 10 x 20 - Main 60 - - - - - 60 - - - - - 60 - - - - -

Alex. Stephen & Sons
SHIPBUILDERS & ENGINEERS
GLASGOW

Wm
13/11/85

DRAWING NO 3709.

13/11/85 Wm