

The words FORGINGS or CASTINGS, IRON or STEEL, should be struck out as may be required.

Lloyd's Register of British and Foreign Shipping.

(Report on Vessel No. 4484 Port Glasgow)
"Queen Victoria"

No. 1154

SHIP FORGINGS OR CASTINGS.

I have to report that the undermentioned Iron ~~or Steel~~ Forgings ~~or Castings~~, manufactured by
Messrs A. Stephens & Sons of Glasgow.
for the Vessel No. 299, being built by them,
of _____ have been inspected by me as set forth below, and found
to be, so far as can be seen, sound and efficient.

Mark on Forgings.

Lloyd's

No. 1154

G. N.


George Newcomb.

Glasgow.

28/5/86.

	STERN FRAME.	RUDDER FRAME.	STEM.
Material* - - - -		Scrap iron	
How made - - - -		Forged	
Dimensions - - - -		7 3/4 dia	
Progress on Inspection -		Forging & smithing.	
Dates when Inspected		22. 29/1/86. 8. 16/2/86. 1. 15/4/86. 25/5/86.	

SKETCHES OF FRAMES SHEWING POSITION AND DESCRIPTION OF WELDS OF FORGINGS, OR PARTICULARS OF TESTS APPLIED TO CASTINGS.

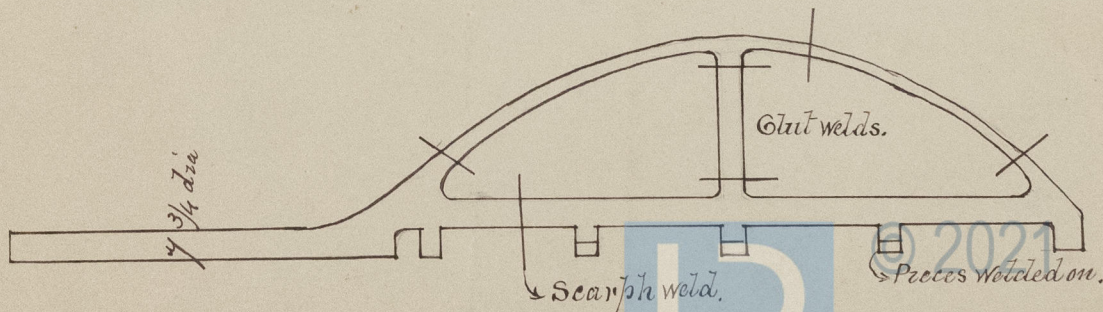

* If of Iron, state whether scrap or puddled iron.

4



© 2021

Lloyd's Register
Foundation