

Lloyd's Register of British and Foreign Shipping.

(Report on Vessel No. 4484 Port Glasgow)
Queen Victoria

No. 1154 SHIP FORGINGS OR CASTINGS.

I have to report that the undermentioned Iron or ~~Steel~~ Forgings or Castings, manufactured by Messrs. A. Stephens & Sons of Glasgow for the Vessel No. 299, being built by them of _____ have been inspected by me as set forth below, and found to be, so far as can be seen, sound and efficient.

The words FORGINGS or CASTINGS, IRON or STEEL, should be struck out as may be required.

Mark on Forgings.


Lloyd's
 No. 1154
G. N.

George Newcomb.
Glasgow.

30/4/86.

	STERN FRAME.	RUDDER FRAME.	STEM.
Material*	<u>Scrap iron</u>	/	<u>Scrap iron</u>
How made	<u>Forged</u>		<u>Forged</u>
Dimensions	<u>10 x 6</u>		<u>10 x 2 3/4</u>
Progress on Inspection	<u>Forging & smithing</u>		<u>Forging</u>
Dates when Inspected	<u>23.30/11/85. 10.15.22.28/12/85</u> <u>11.16.22.29/1/86.</u>		<u>15.22/12/85.</u>

SKETCHES OF FRAMES SHEWING POSITION AND DESCRIPTION OF WELDS OF FORGINGS, OR PARTICULARS OF TESTS APPLIED TO CASTINGS.

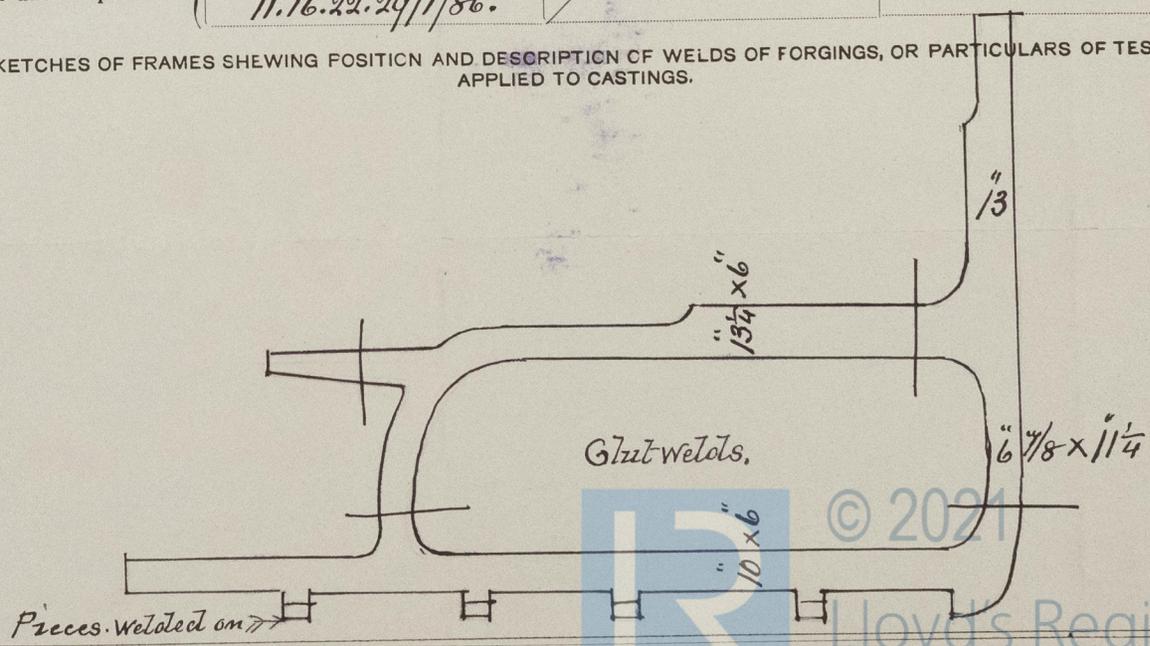

* If of Iron, state whether scrap or puddled iron.