

Lloyd's Register of British and Foreign Shipping.

(Report on Vessel No. 4493 Port Glasgow)

S. S. Landawra

No. 1034

SHIP FORGINGS OR CASTINGS.

The words FORGINGS or CASTINGS, IRON or STEEL, should be struck out as may be required.

I have to report that the undermentioned ~~Iron or~~ Steel Forgings ~~or Castings~~, manufactured by The Dennytown Forge Co of Dumbarton, for the Vessel No. 307, being built by Messrs Wm Denny Bros. of Dumbarton have been inspected by me as set forth below, and found to be, so far as can be seen, sound and efficient.

Mark on Forgings.



Lloyd's
No. 1034
G. X.

George Newcomb
Glasgow

1/4/85.

	STERN FRAME.	RUDDER FRAME.	STEM.
Material* - - - -	/	Siemens, Martin, scrap steel	/
How made - - - -		Forged	
Dimensions - - - -		Stock 8 1/2 dia	
Progress on Inspection -		Forging & smithing	
Dates when Inspected		24/4/85. 1.14.21/5/85. 4.12.18.25/6/85.	

SKETCHES OF FRAMES SHEWING POSITION AND DESCRIPTION OF WELDS OF FORGINGS, OR PARTICULARS OF TESTS APPLIED TO CASTINGS.

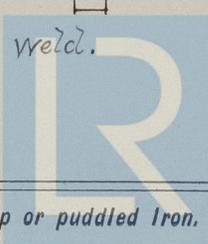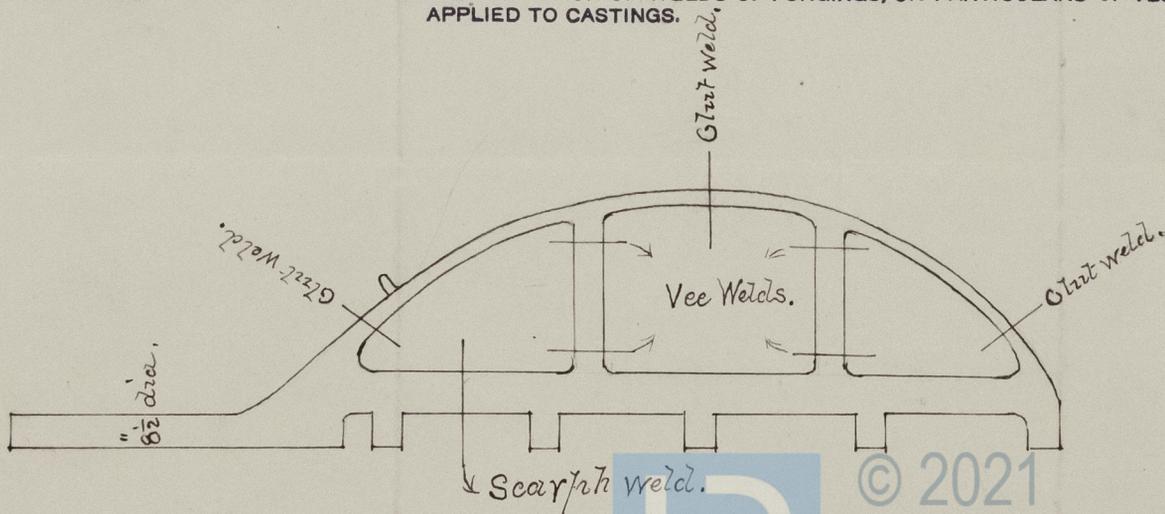

© 2021
Lloyd's Register
Foundation

* If of Iron, state whether scrap or puddled Iron.