


Circumferential Seams, double riveted, Lap joints,
 $\frac{1}{2}$ " rivets - $3\frac{1}{2}$ " pitch.
 Butt Straps $\frac{5}{8}$ " thick.
 Shell plates $1\frac{1}{2}$ " thick.
 Steel plates and rivets.
 All holes bored.
 Tubes and Stays iron.

S S "Harold"
 Glasgow Report No. 4853
 Boiler No. 206.

Pressure 160 lbs. per sq. in.
 Scale 1" = 1 foot.

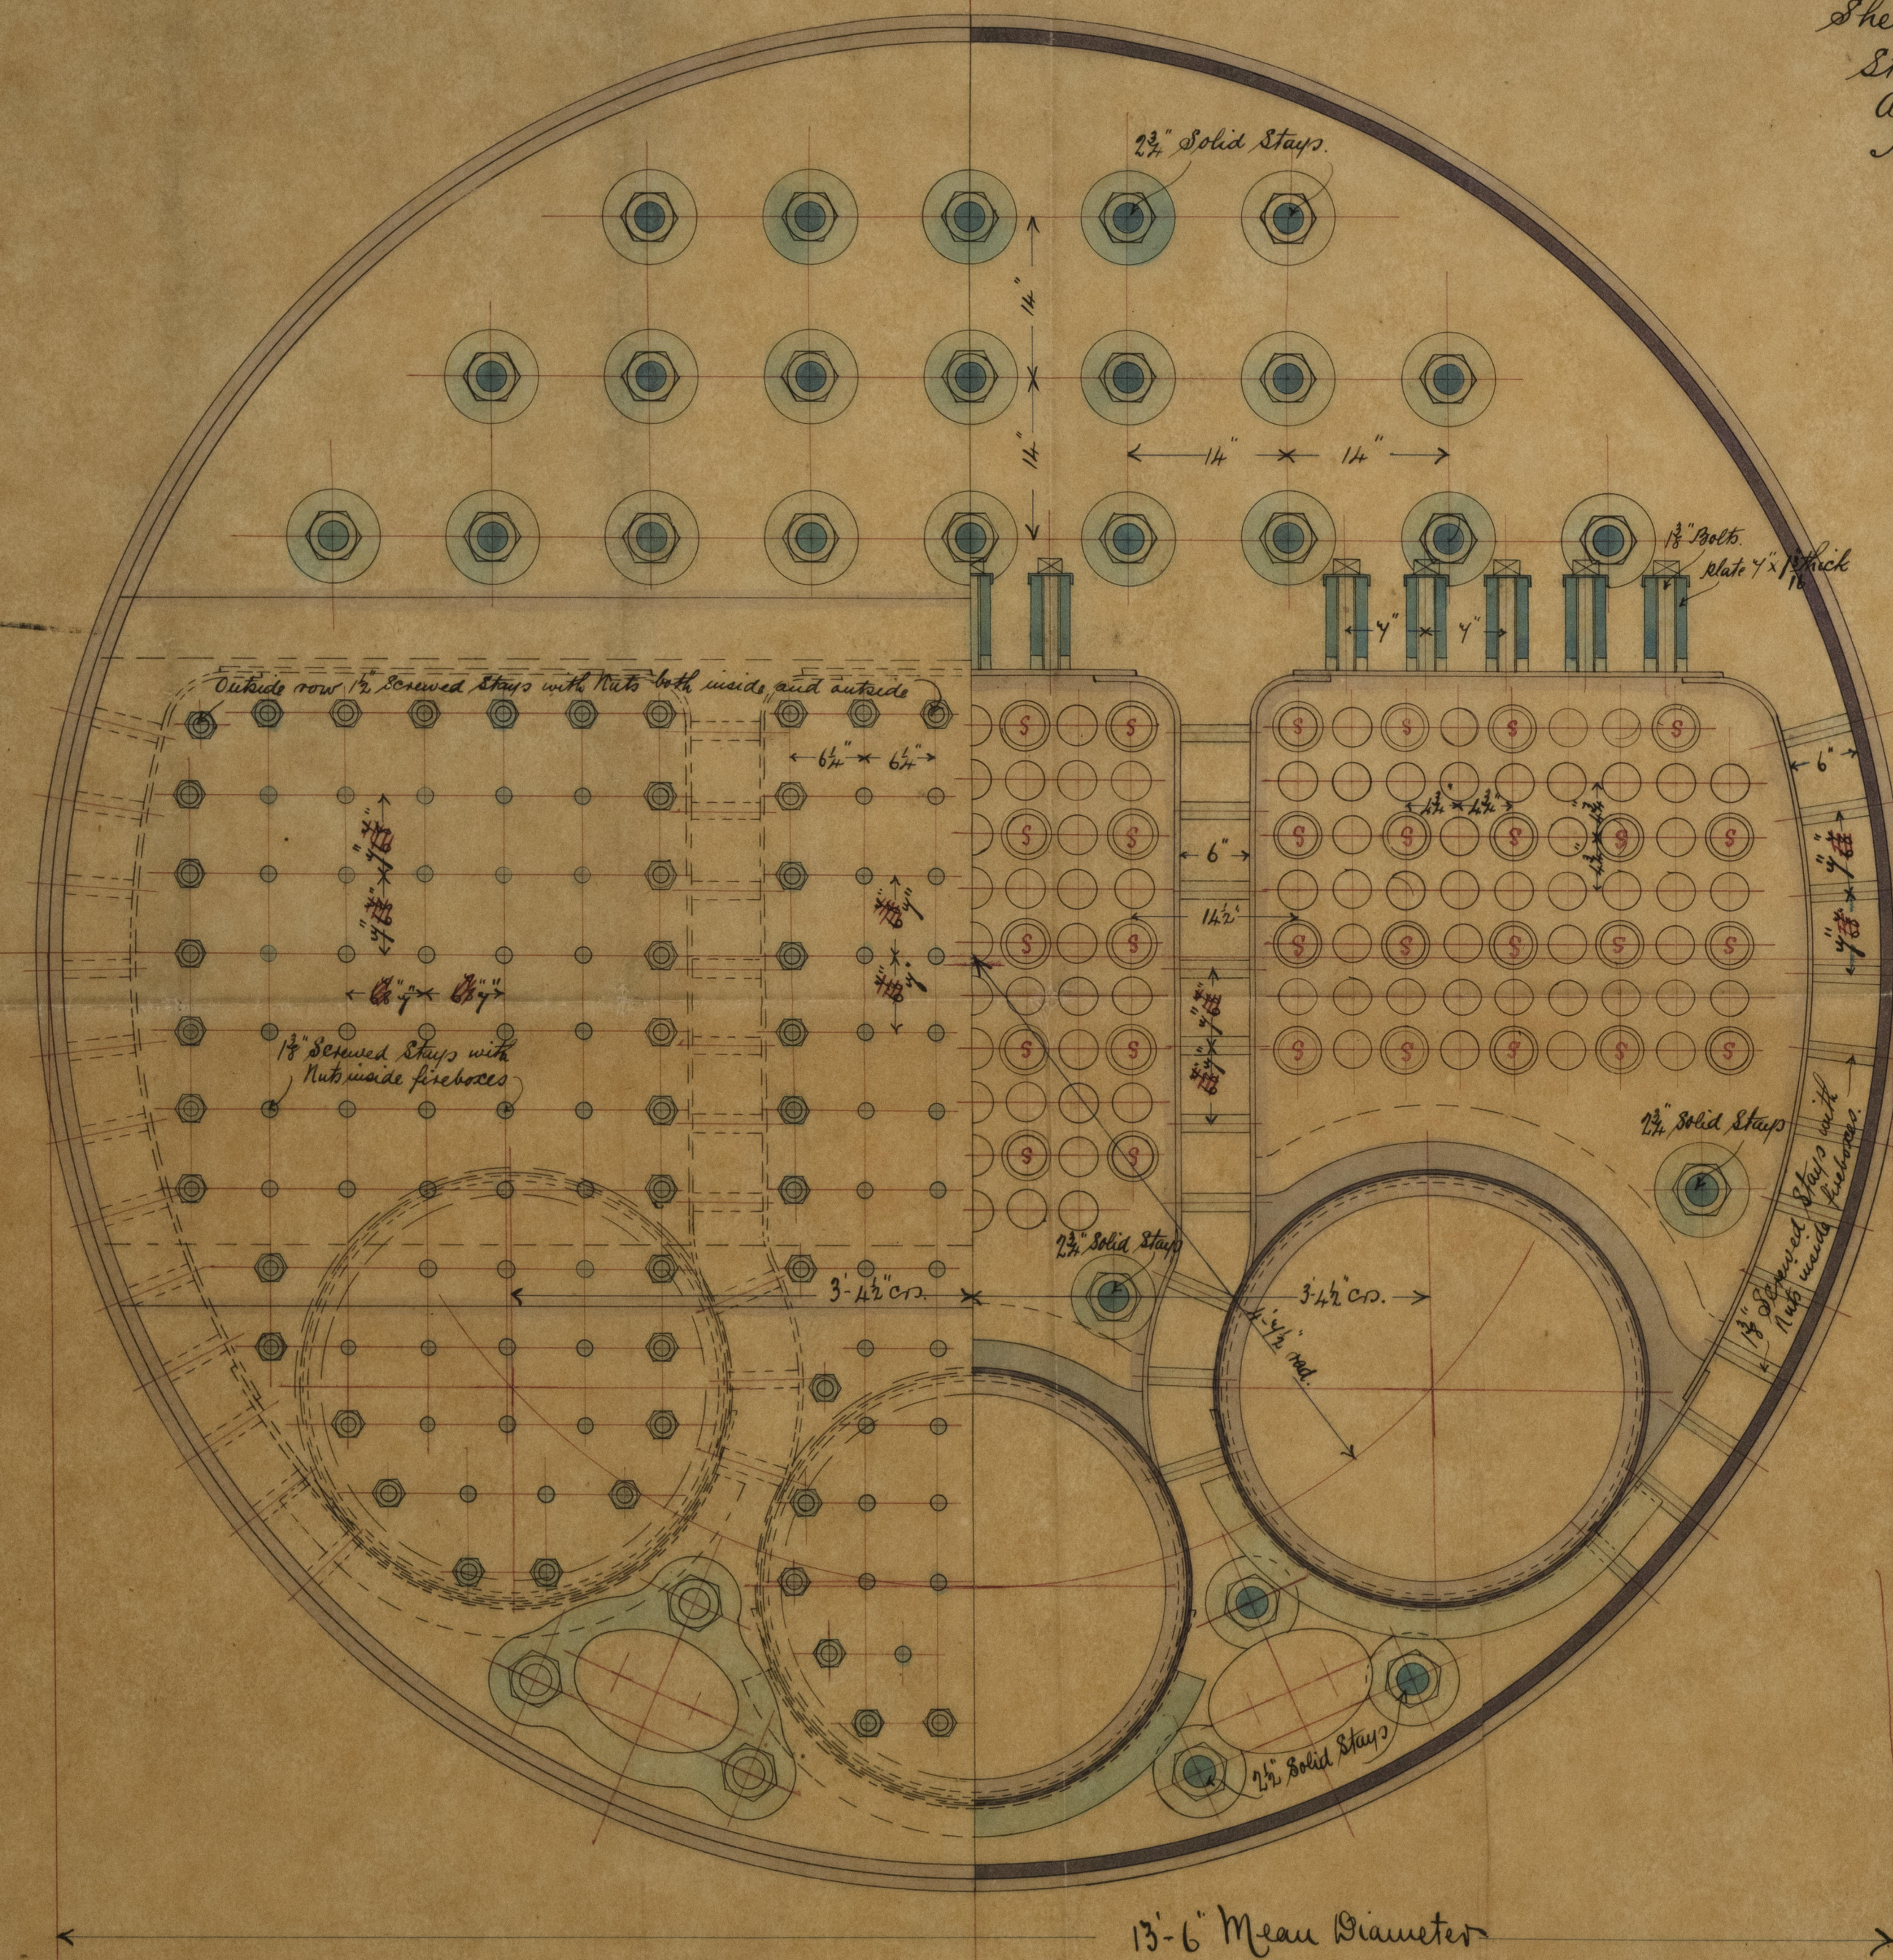


Stay tubes marked thus.



Longitudinal, triple riveted $1\frac{1}{2}$ " rivets $8\frac{1}{2}$ " pitch.
 Double Butt Straps
 Original Tracing Submitted
 18/9/86

Amended Tracing
 22/9/86
 M

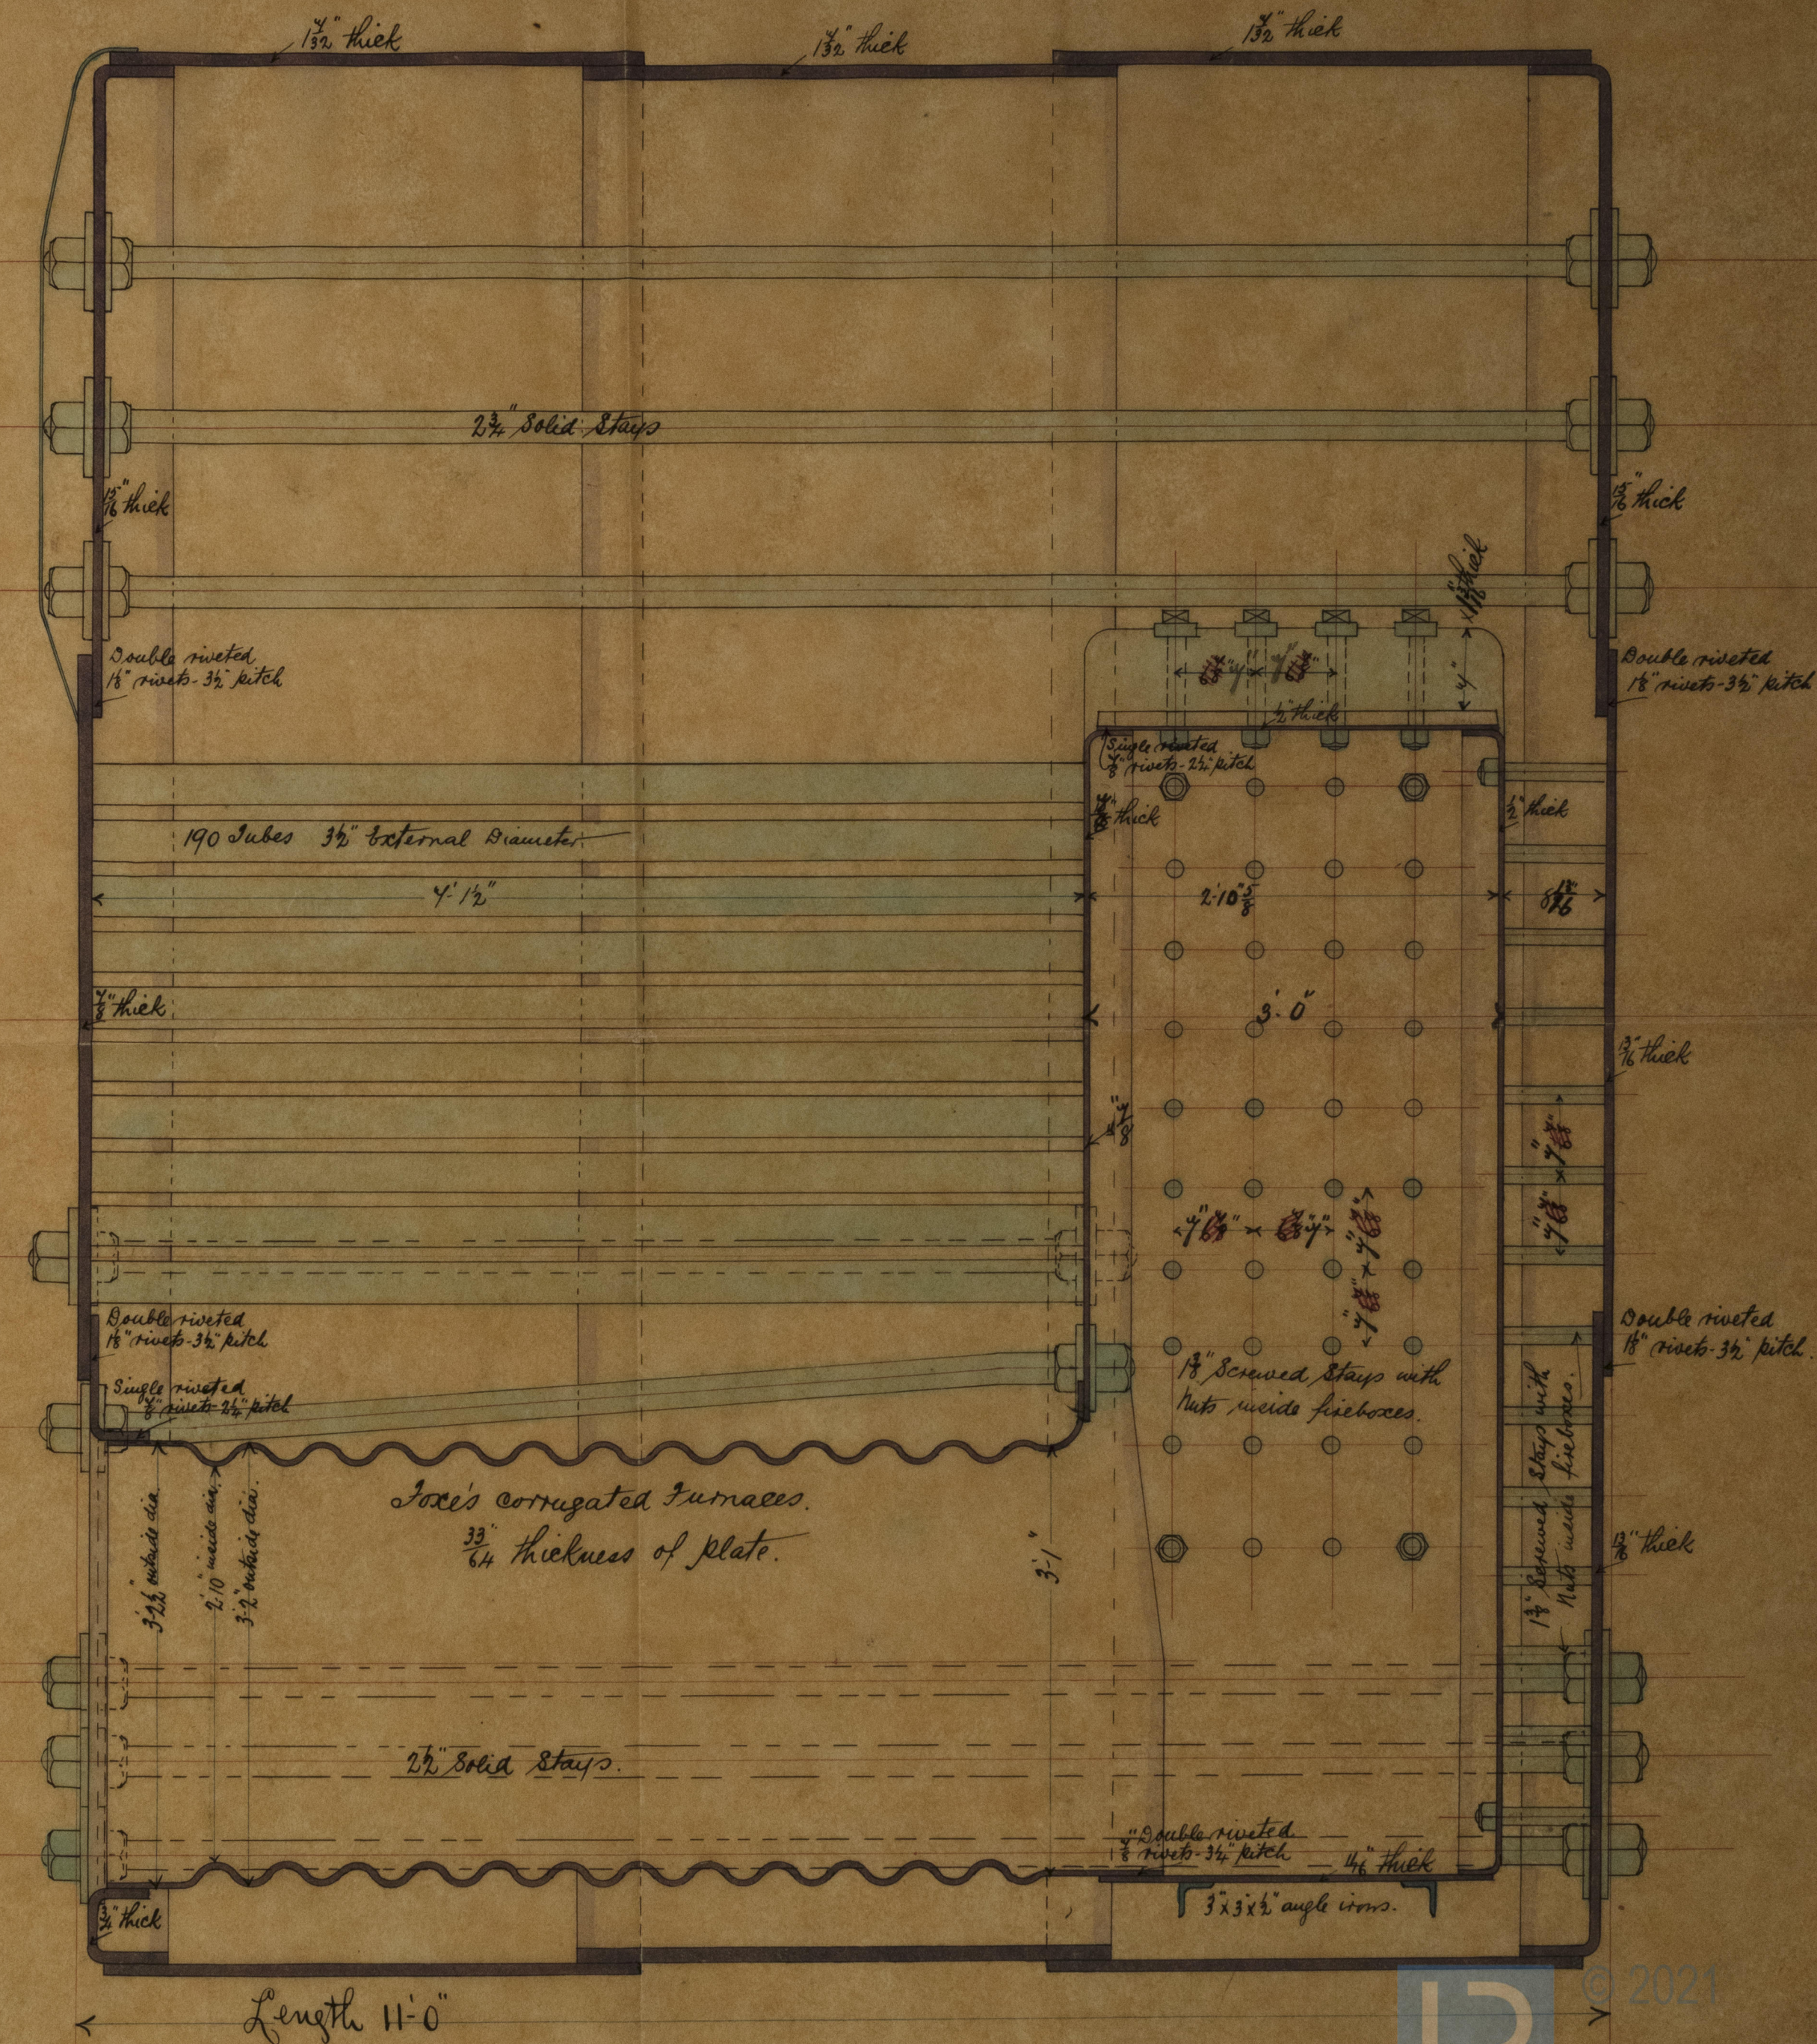

915206-0006



© 2021
 Lloyd's Register
 Foundation