

Lloyd's Register of British and Foreign Shipping.

(Report on Vessel No. 4911 Port Glasgow)

S. S. "Yarmouth."

No. 1306

SHIP FORGINGS OR CASTINGS.

The words FORGINGS or CASTINGS, IRON or STEEL, should be struck out as may be required.

I have to report that the undermentioned Iron ~~or Steel~~ Forgings ~~or Castings~~, manufactured by The Portland Forge Co of Kilmarnock for the Vessel No. 246, being built by Messrs. McMillan & Son, of Dumbarton, have been inspected by me as set forth below, and found to be, so far as can be seen, sound and efficient.

Mark on Forgings.


Lloyd's
No. 1306
G. N.

George Newcomb
Glasgow


14/2/87.

	STERN FRAME.	RUDDER FRAME.	STEM.
Material*	/	Scrap iron	/
How made		Forged	
Dimensions		5" dia	
Progress on Inspection		Forging & smithing	
Dates when Inspected		20.26.28/1/87. 1-4/2/87.	

SKETCHES OF FRAMES SHEWING POSITION AND DESCRIPTION OF WELDS OF FORGINGS, OR PARTICULARS OF TESTS APPLIED TO CASTINGS.

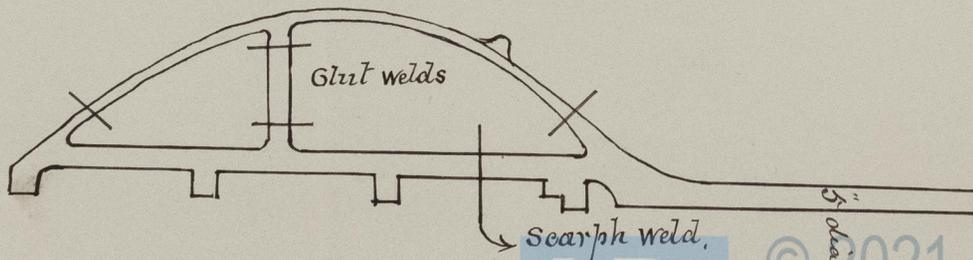

* If of Iron, state whether scrap or puddled iron.

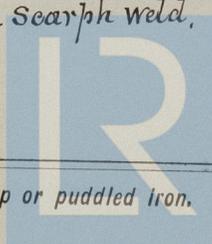

© 2021

Lloyd's Register
Foundation