


Scantlings as per approved Section in Black
 Proposed Scantlings in Red

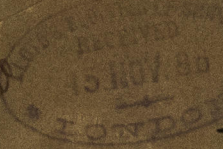


Grain deck stanchion $54 \times 2 \frac{1}{2}$ to 20
 upper - $3 \frac{1}{2} \times 20$

15.11.86.
 25.11.86.

Steel-Screw Steamer
 No. 246

Scale $\frac{1}{2}'' = 1 \text{ foot}$

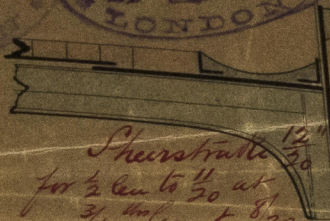

Sheerstrake $\frac{12}{30}$
 for $\frac{1}{2}$ cen to $\frac{11}{20}$ at
 $\frac{3}{4}$ cen + $8 \frac{1}{20}$
 at ends.

Sheerstrake $\frac{10}{20}$ to
 $\frac{7}{20}$
 Doubling plates
 below main deck
 $\frac{6}{20}$ for
 $\frac{3}{4}$ cen length.

$\frac{6}{20}$
 $8 \frac{1}{20}$ for $\frac{1}{2}$
 cen to $\frac{7}{20}$.

$\frac{7}{20}$ to $\frac{7}{20}$



© 2021

Lloyd's Register
 Foundation

15/11/86

GLS206-0100