


LLOYD'S REGISTER OF SHIPPING
 RECEIVED
 25 OCT. 86
 LONDON
 LLOYD'S REGISTER OF SHIPPING
 RECEIVED
 2 NOV. 86
 LONDON
 LLOYD'S REGISTER OF SHIPPING
 RECEIVED
 15 NOV. 86
 LONDON
 LLOYD'S REGISTER OF SHIPPING
 RECEIVED
 19 NOV. 86
 LONDON

S. S. "Yarmouth"
 Glasgow Report No. 4911

ARTHUR MILLAN & SONS
 SHIP BUILDERS
 22 OCT. 86
 DOCKYARD
 DUMBARTON

28/10/86
 4/11/86 to Bars.
 15.11.86.
 24/11/86.
 25/11/86.

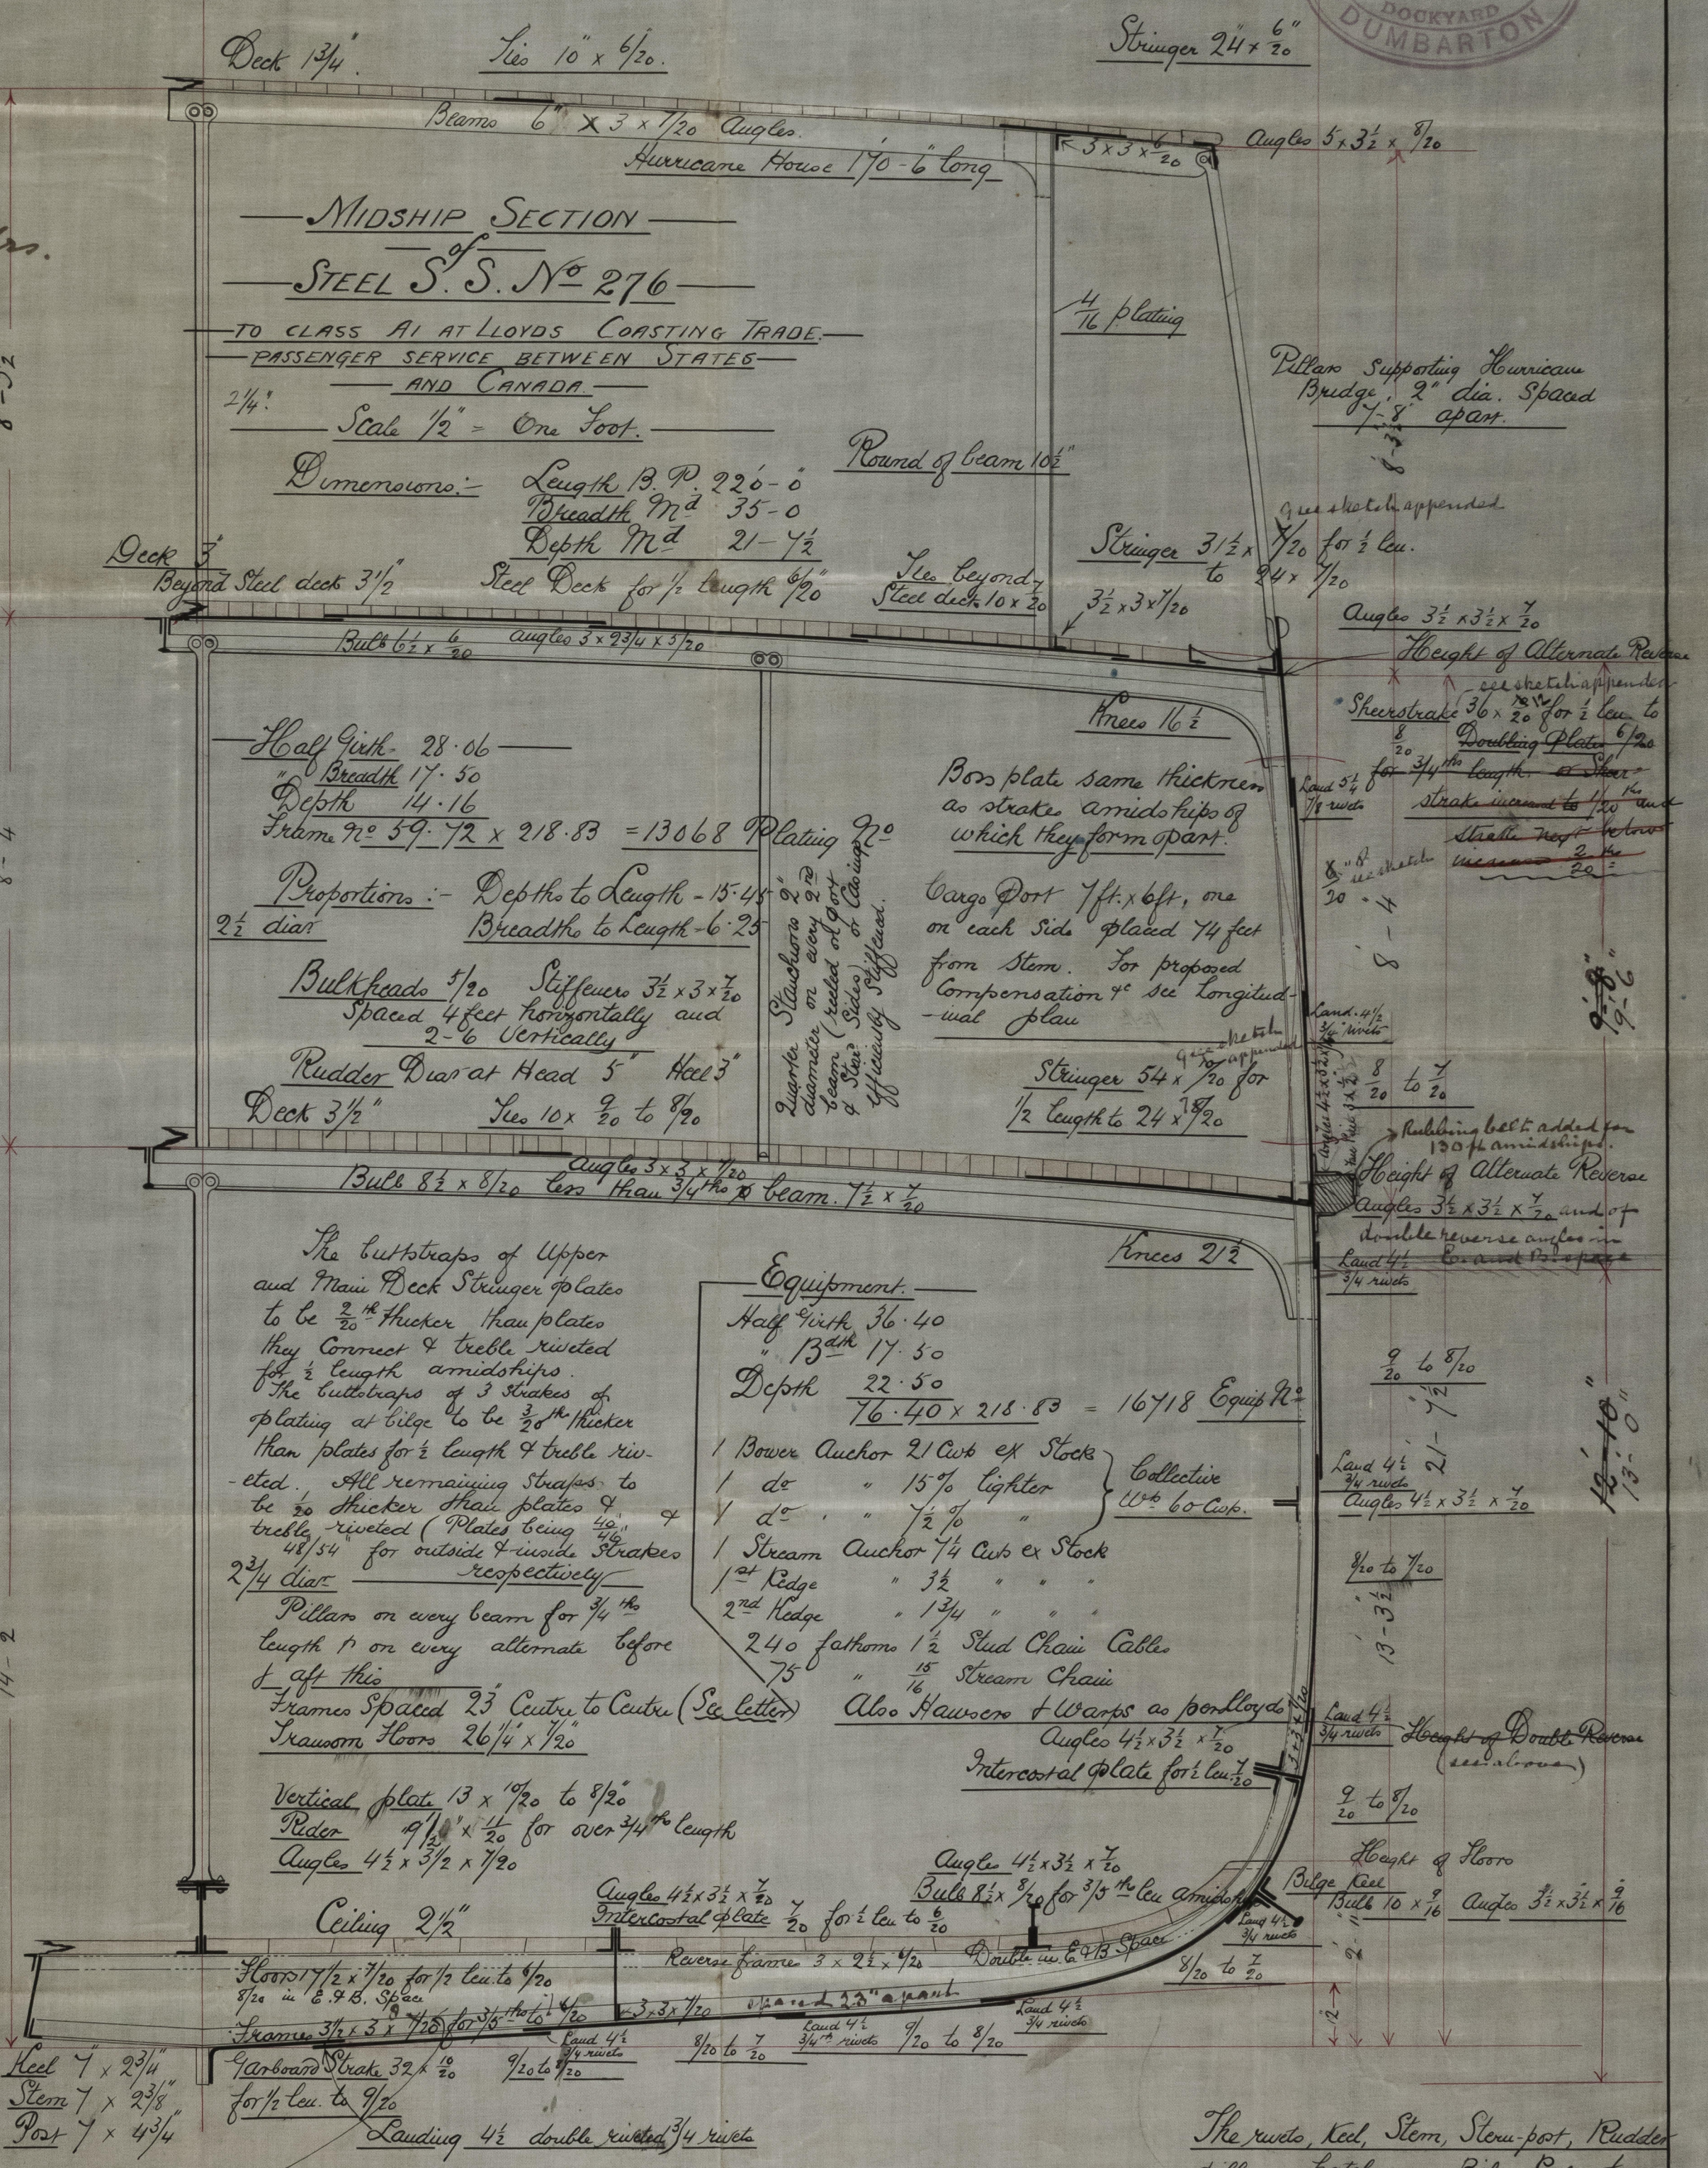

It is proposed to adhere to 23" spacing and increase frames 1/20" in thickness (thus making them 3 1/2 x 3 x 7/20 for 3/5" to 7/20) to compensate for 22" spacing

27/10/86

GLS206-0101

Lloyd's Register Foundation