




LETTER OF SHIPMENT  
RECEIVED  
26 OCT. 86  
LONDON

etc. to bl.  
27/10/86

S.S. "Yarmouth"  
Glasgow Report No. 4911.

Thickness of Plates


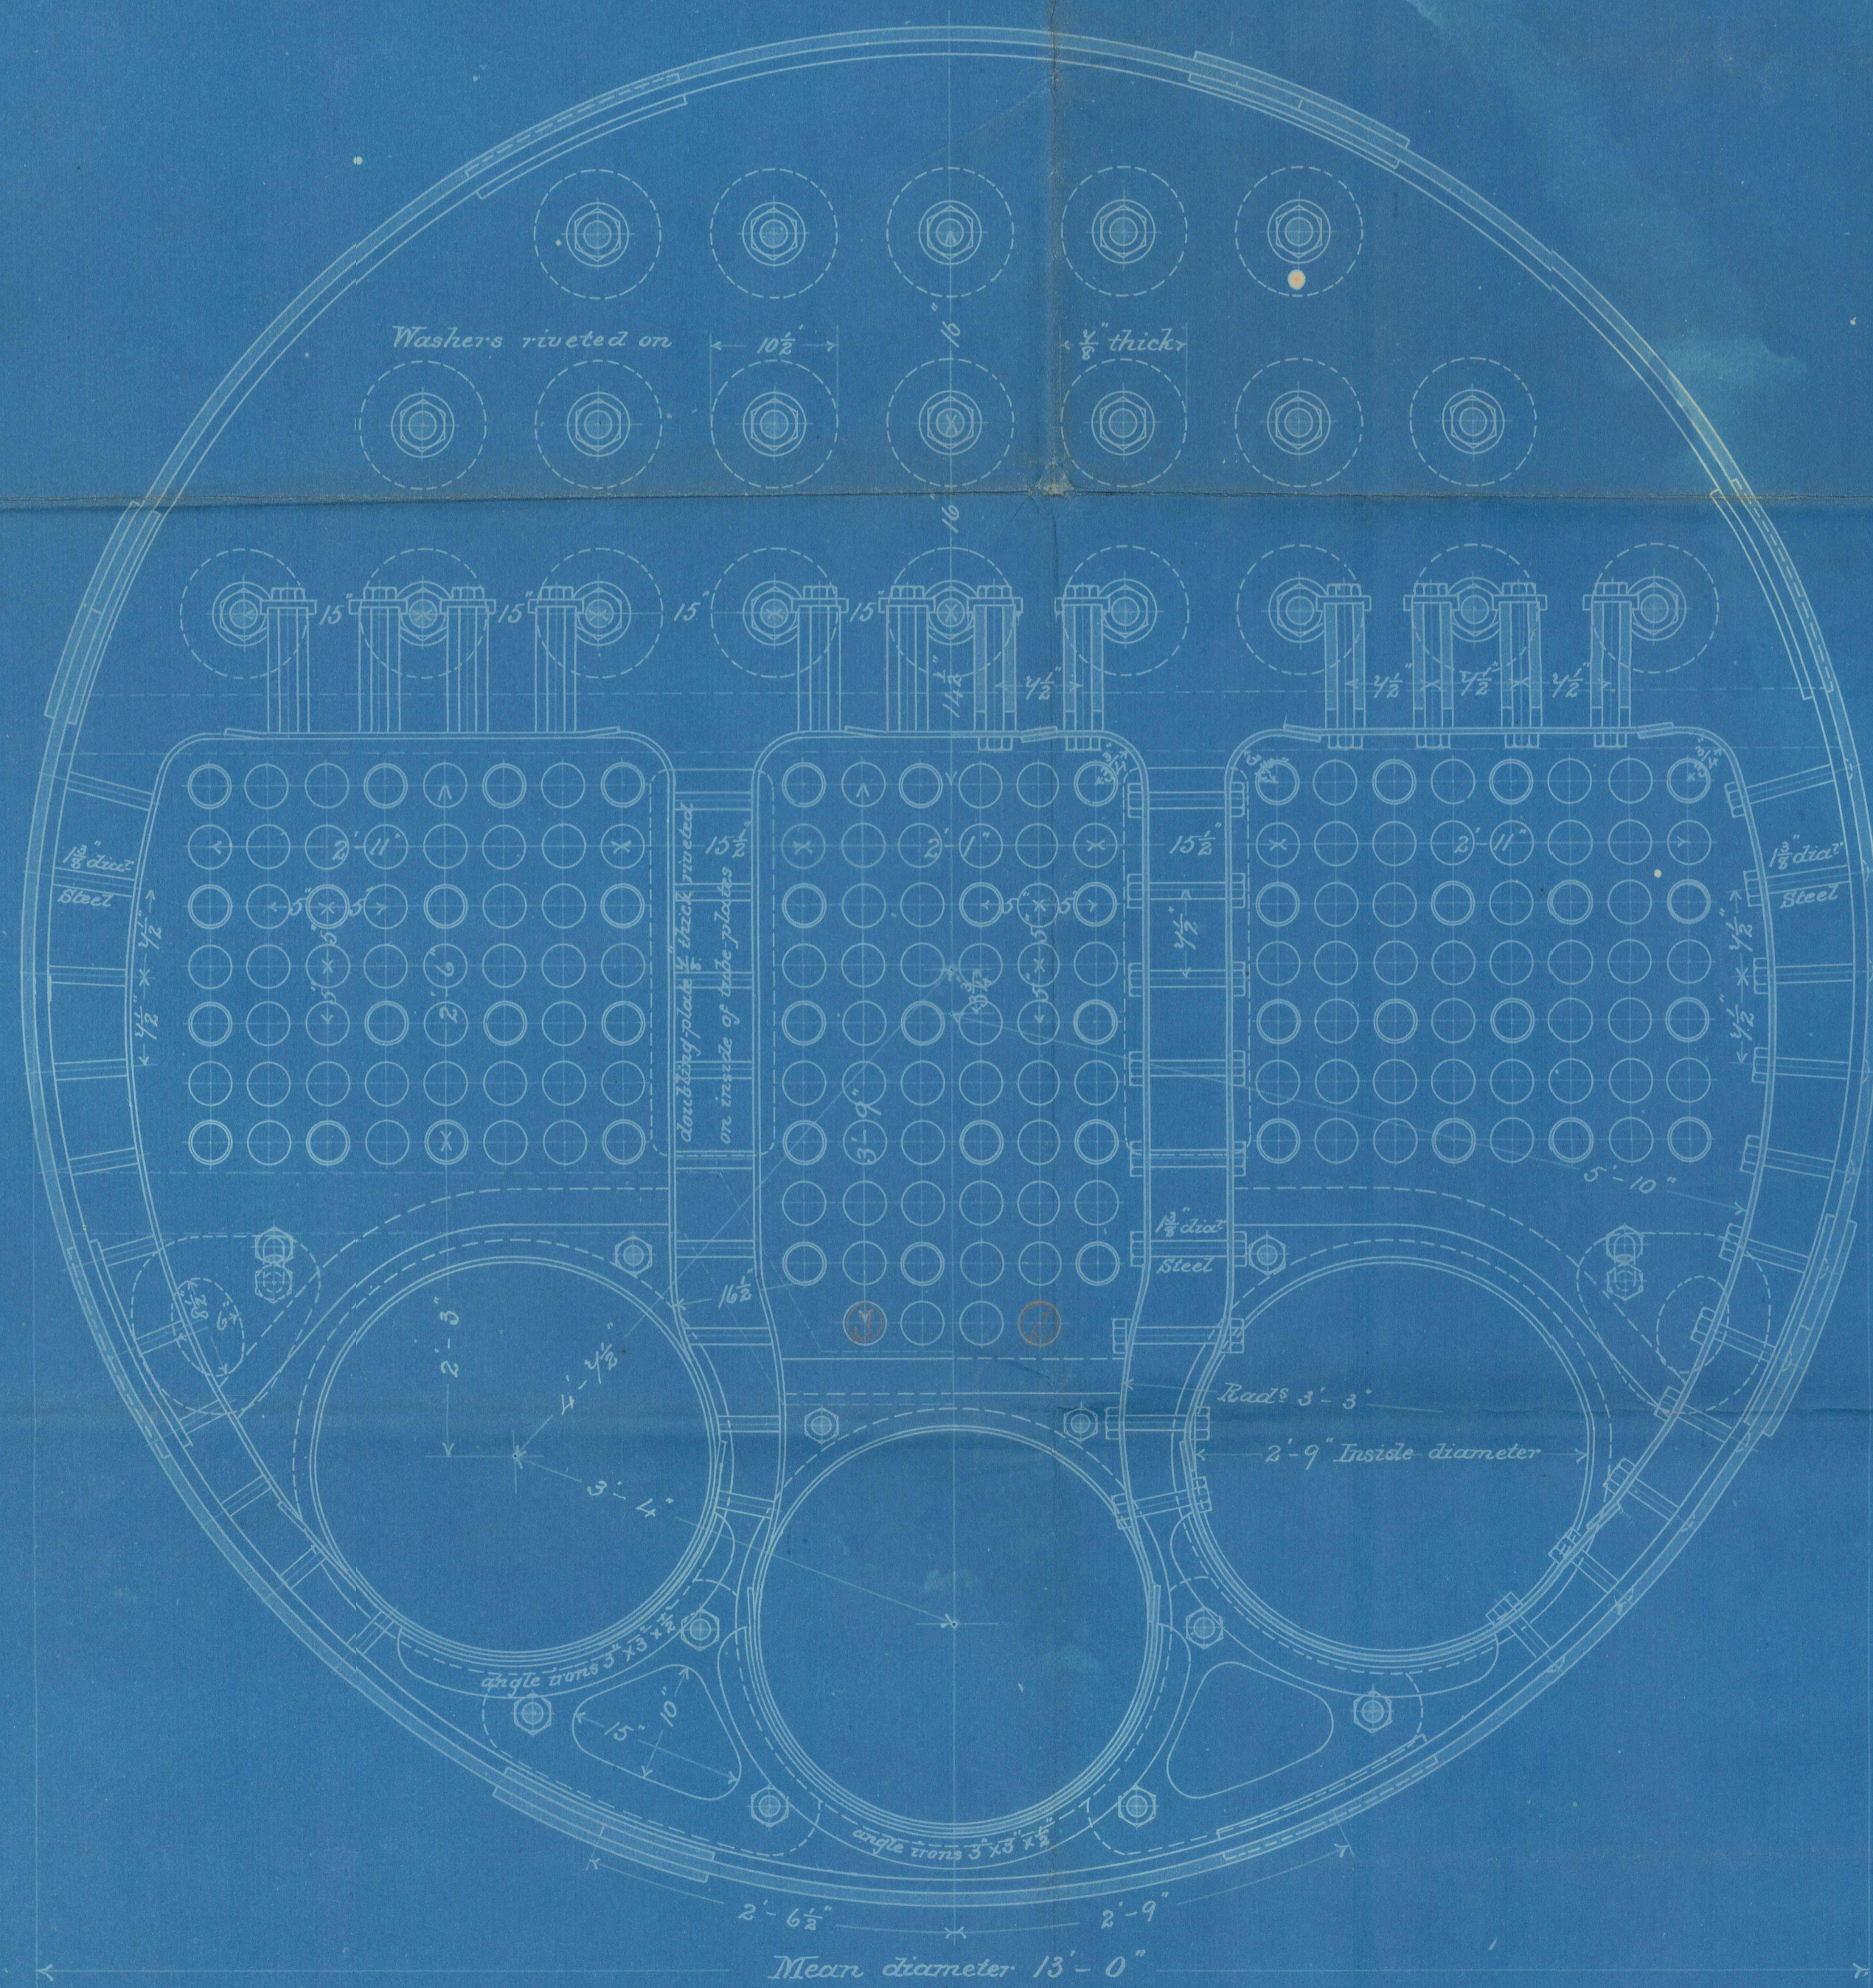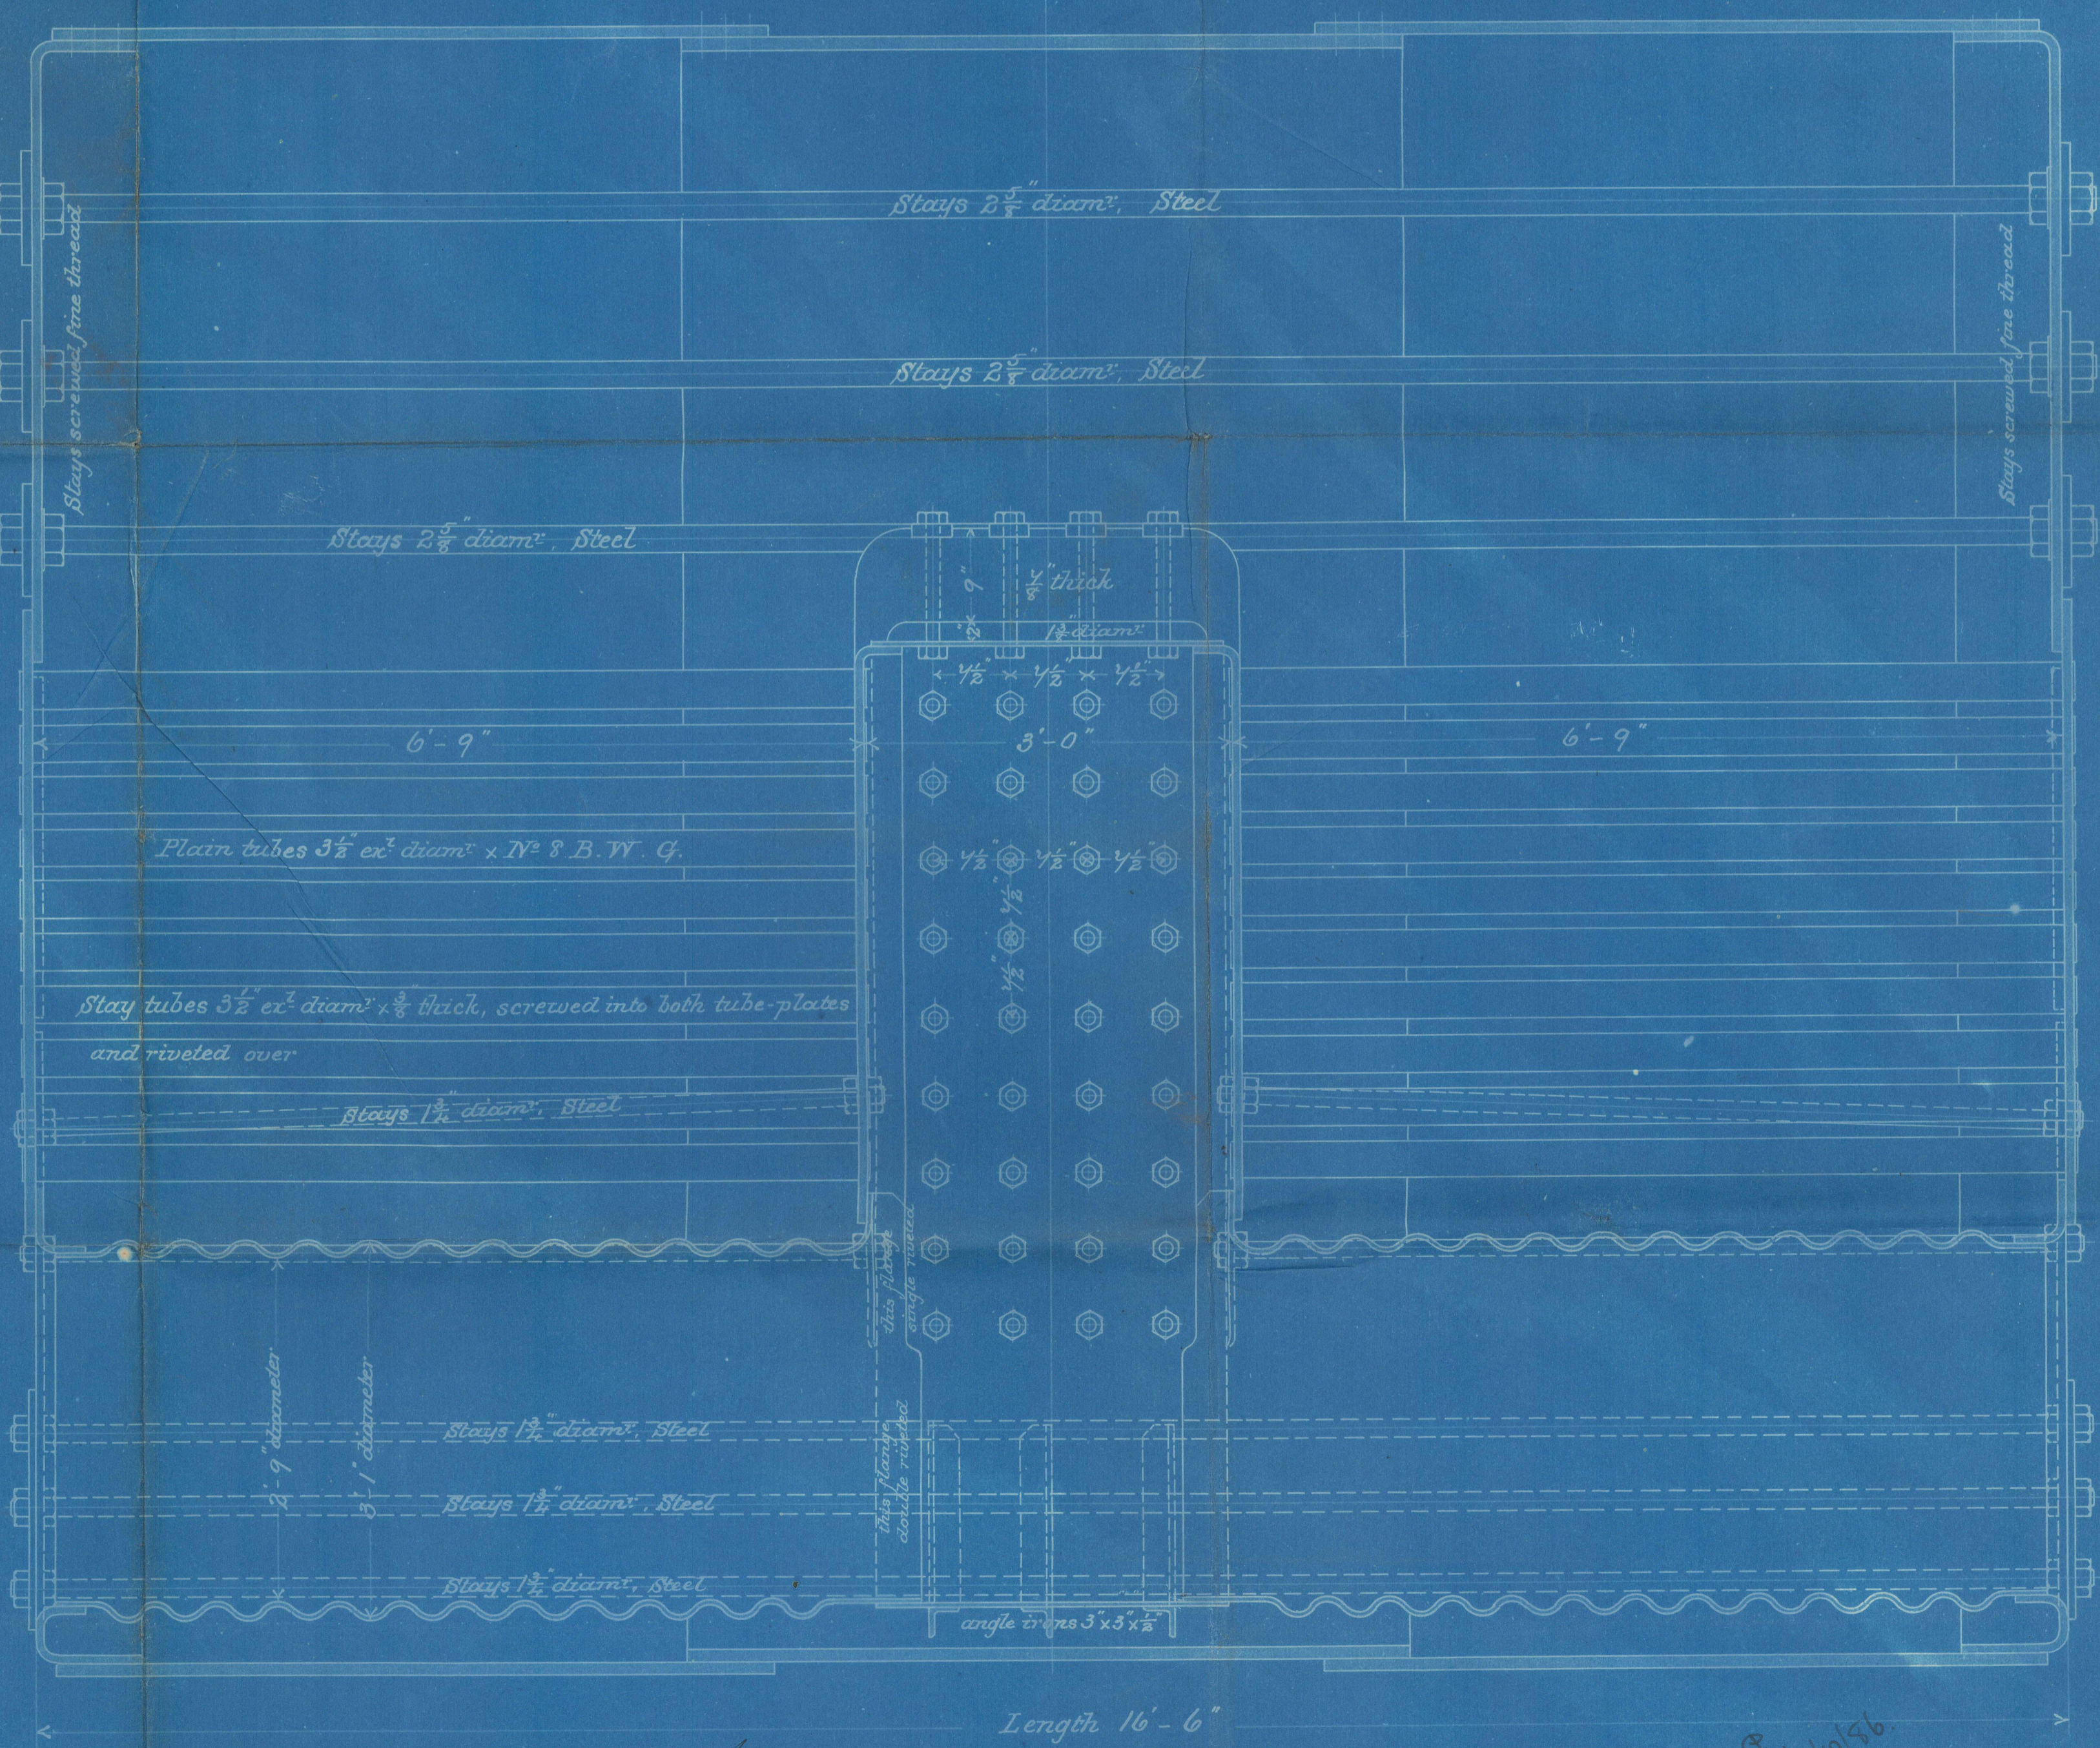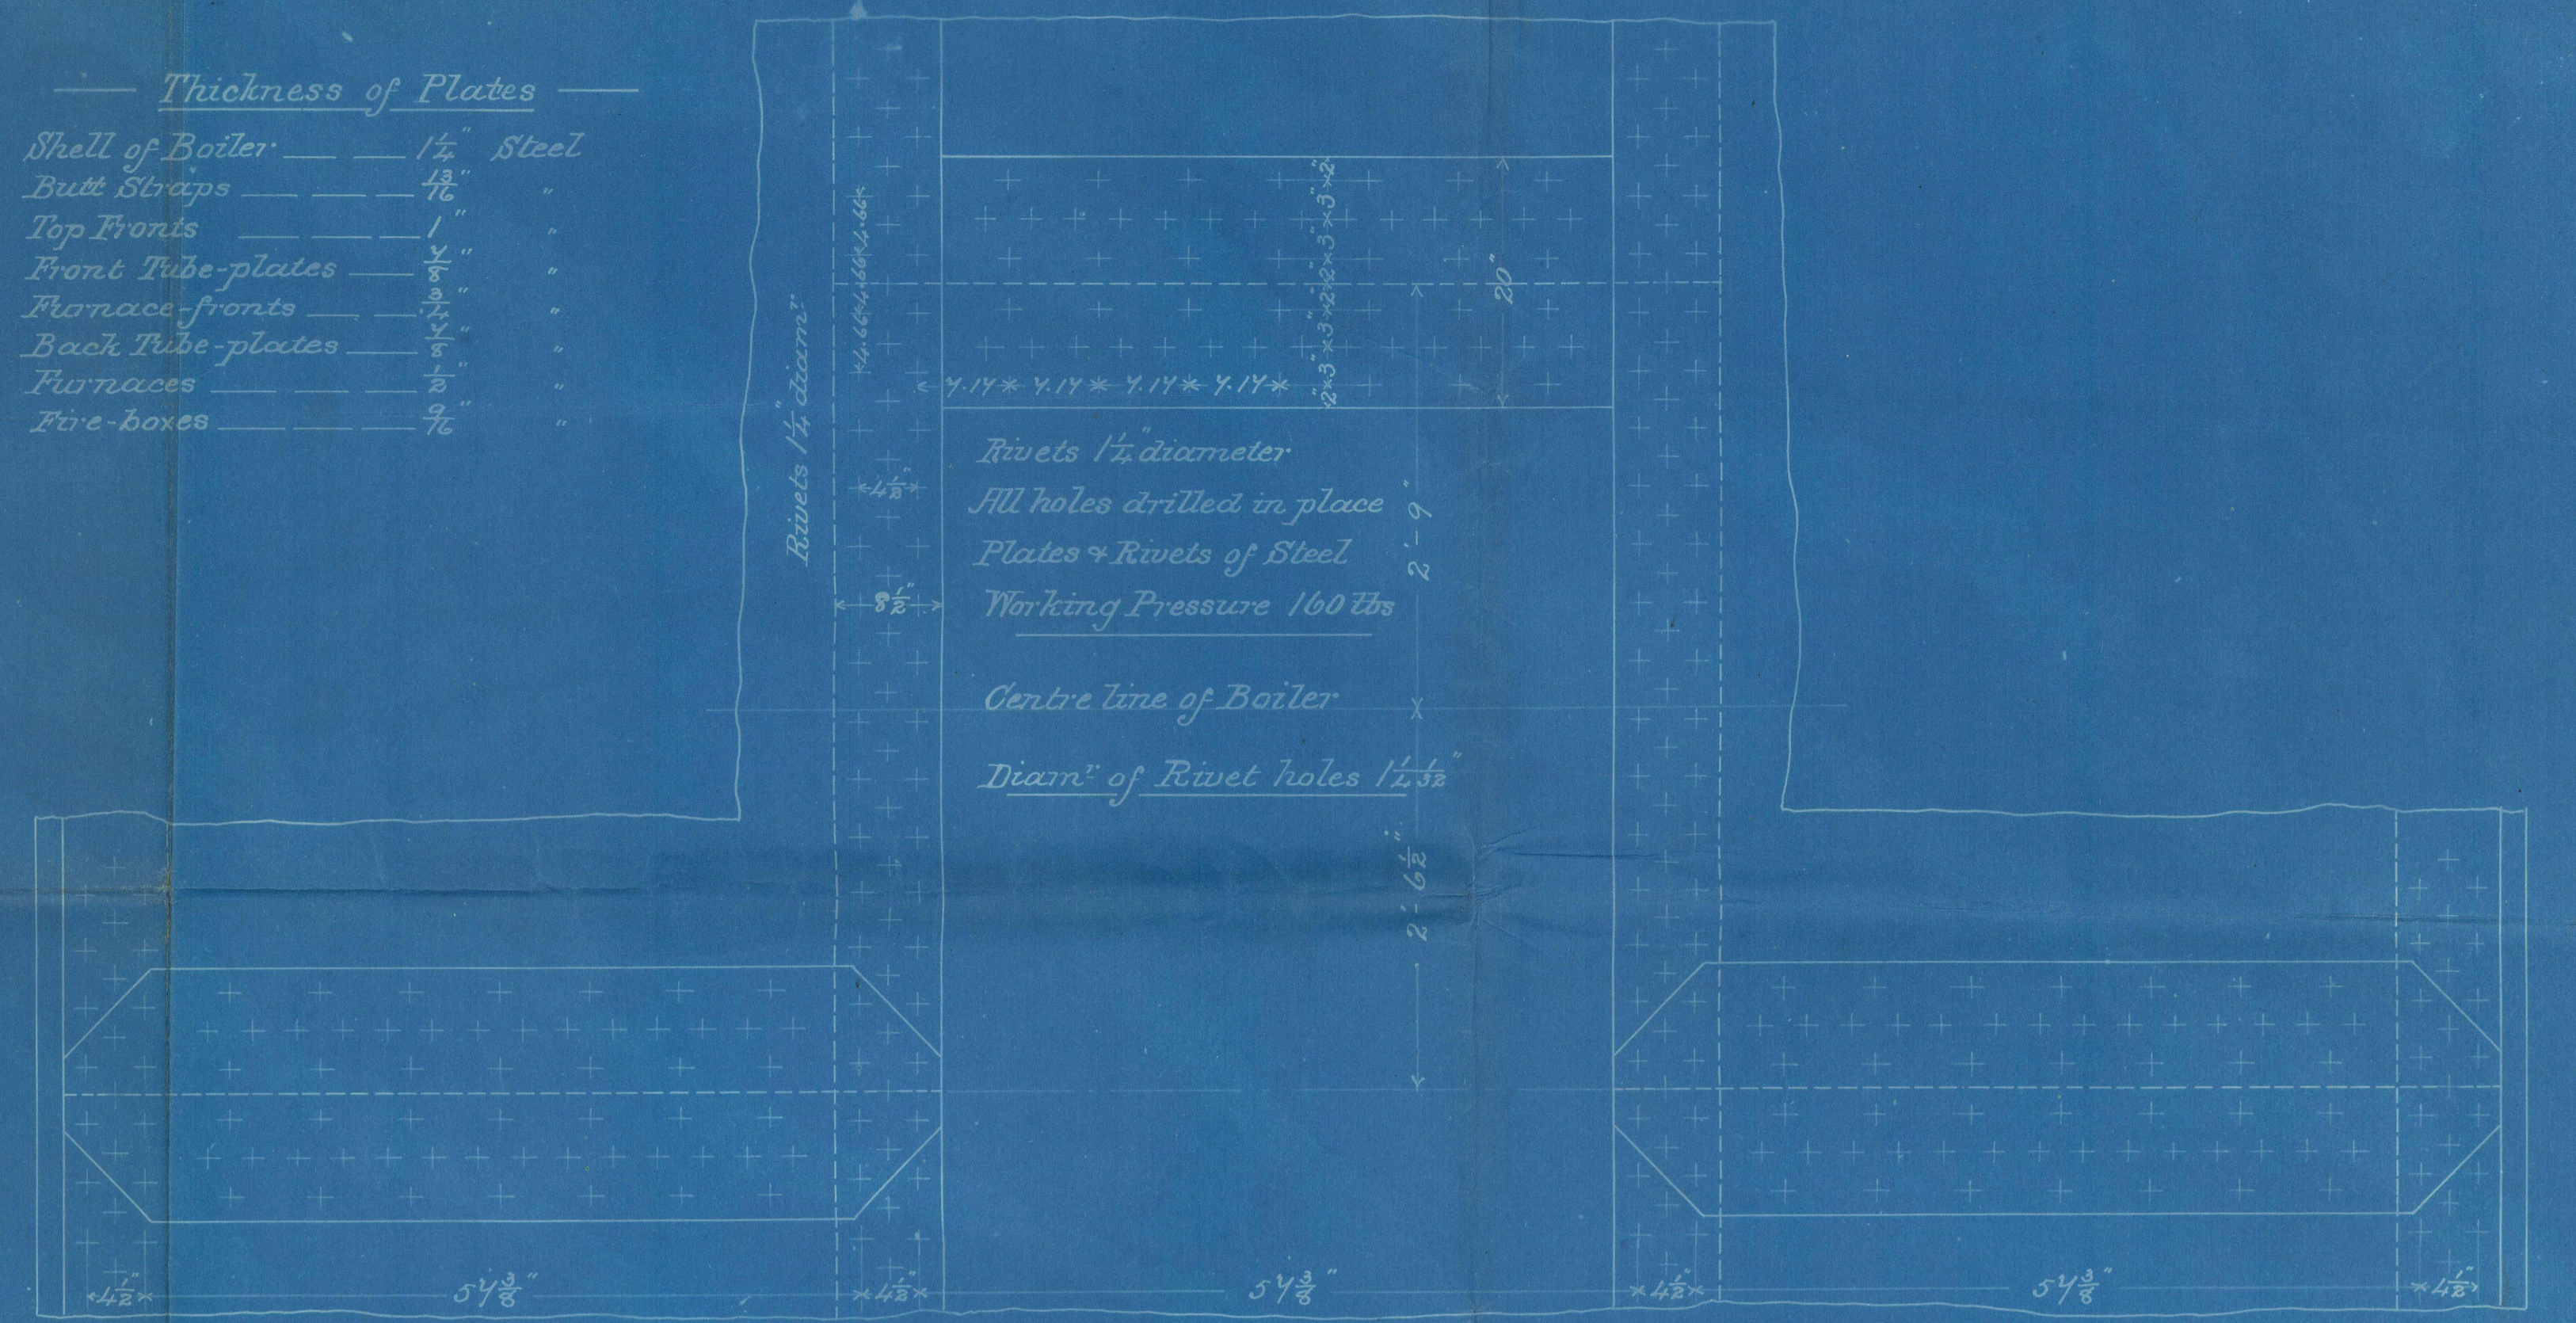

M. Glasgow  
25/10/86

DAVID ROWAN & SON  
ENGINEERS  
23 OCT. 86  
ELLIOT STREET  
GLASGOW

B. 27/10/86

14S  
Lloyd's Register  
Foundation