



S. S. "Yarmouth" Glasgow Report A^o 4911. —

31/12/86.

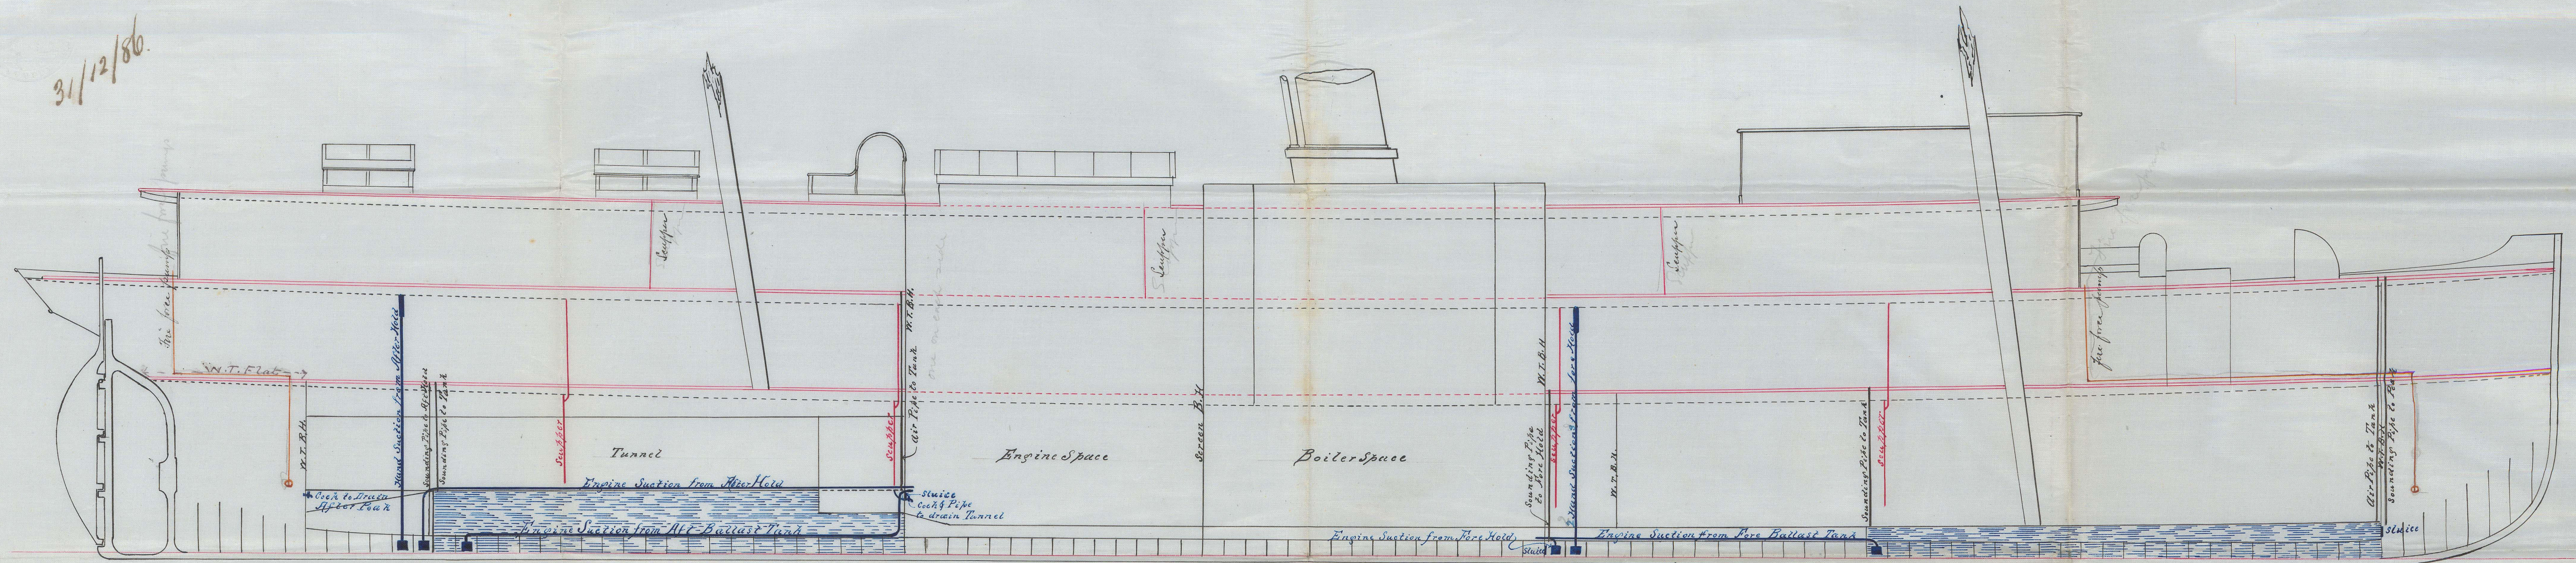

PUMPING ARRANGEMENT S. S. N^o 276.

SCALE 1/8 IN. = ONE FOOT.

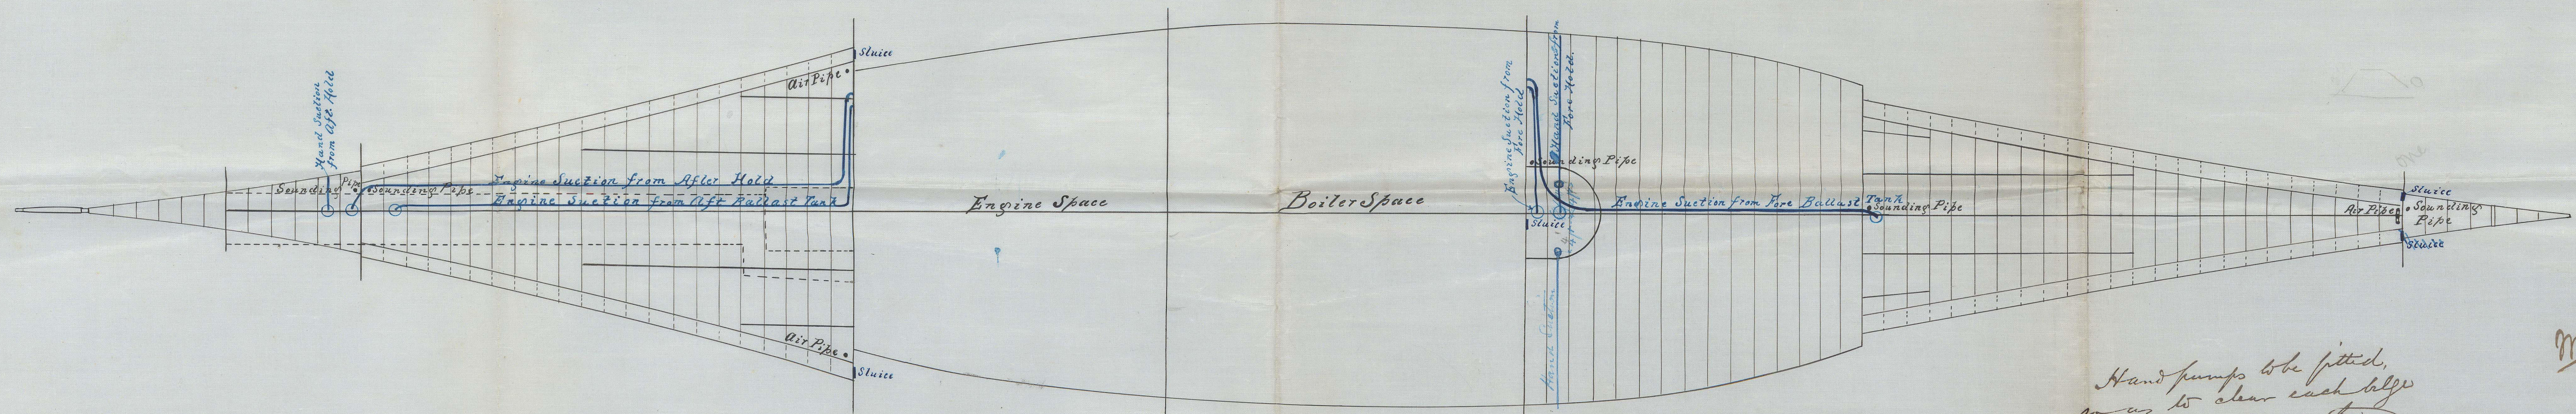

Hand pumps to be fitted,
so as to clear each half
of water in case the
vessel has a considerable
list.

31/12/86



GLS206-0108

Lloyd's Register Foundation