

14.11.86.
18.1.87.

S. S. N^o 134

S. S. "Mogul"

Glasgow Report N^o 8194.-

- MID-SECTION -


- S. S. 335 x 40 x 25-9 HOLD -

- CLASS - LLOYD'S 100A "STEEL" 3 DECKS. -

Short full Poop, Open Bridge, & Turtle backed Forecastle.

Scale $\frac{1}{2}$ " = 1 Foot.

Section showing web frames
in main Holds.

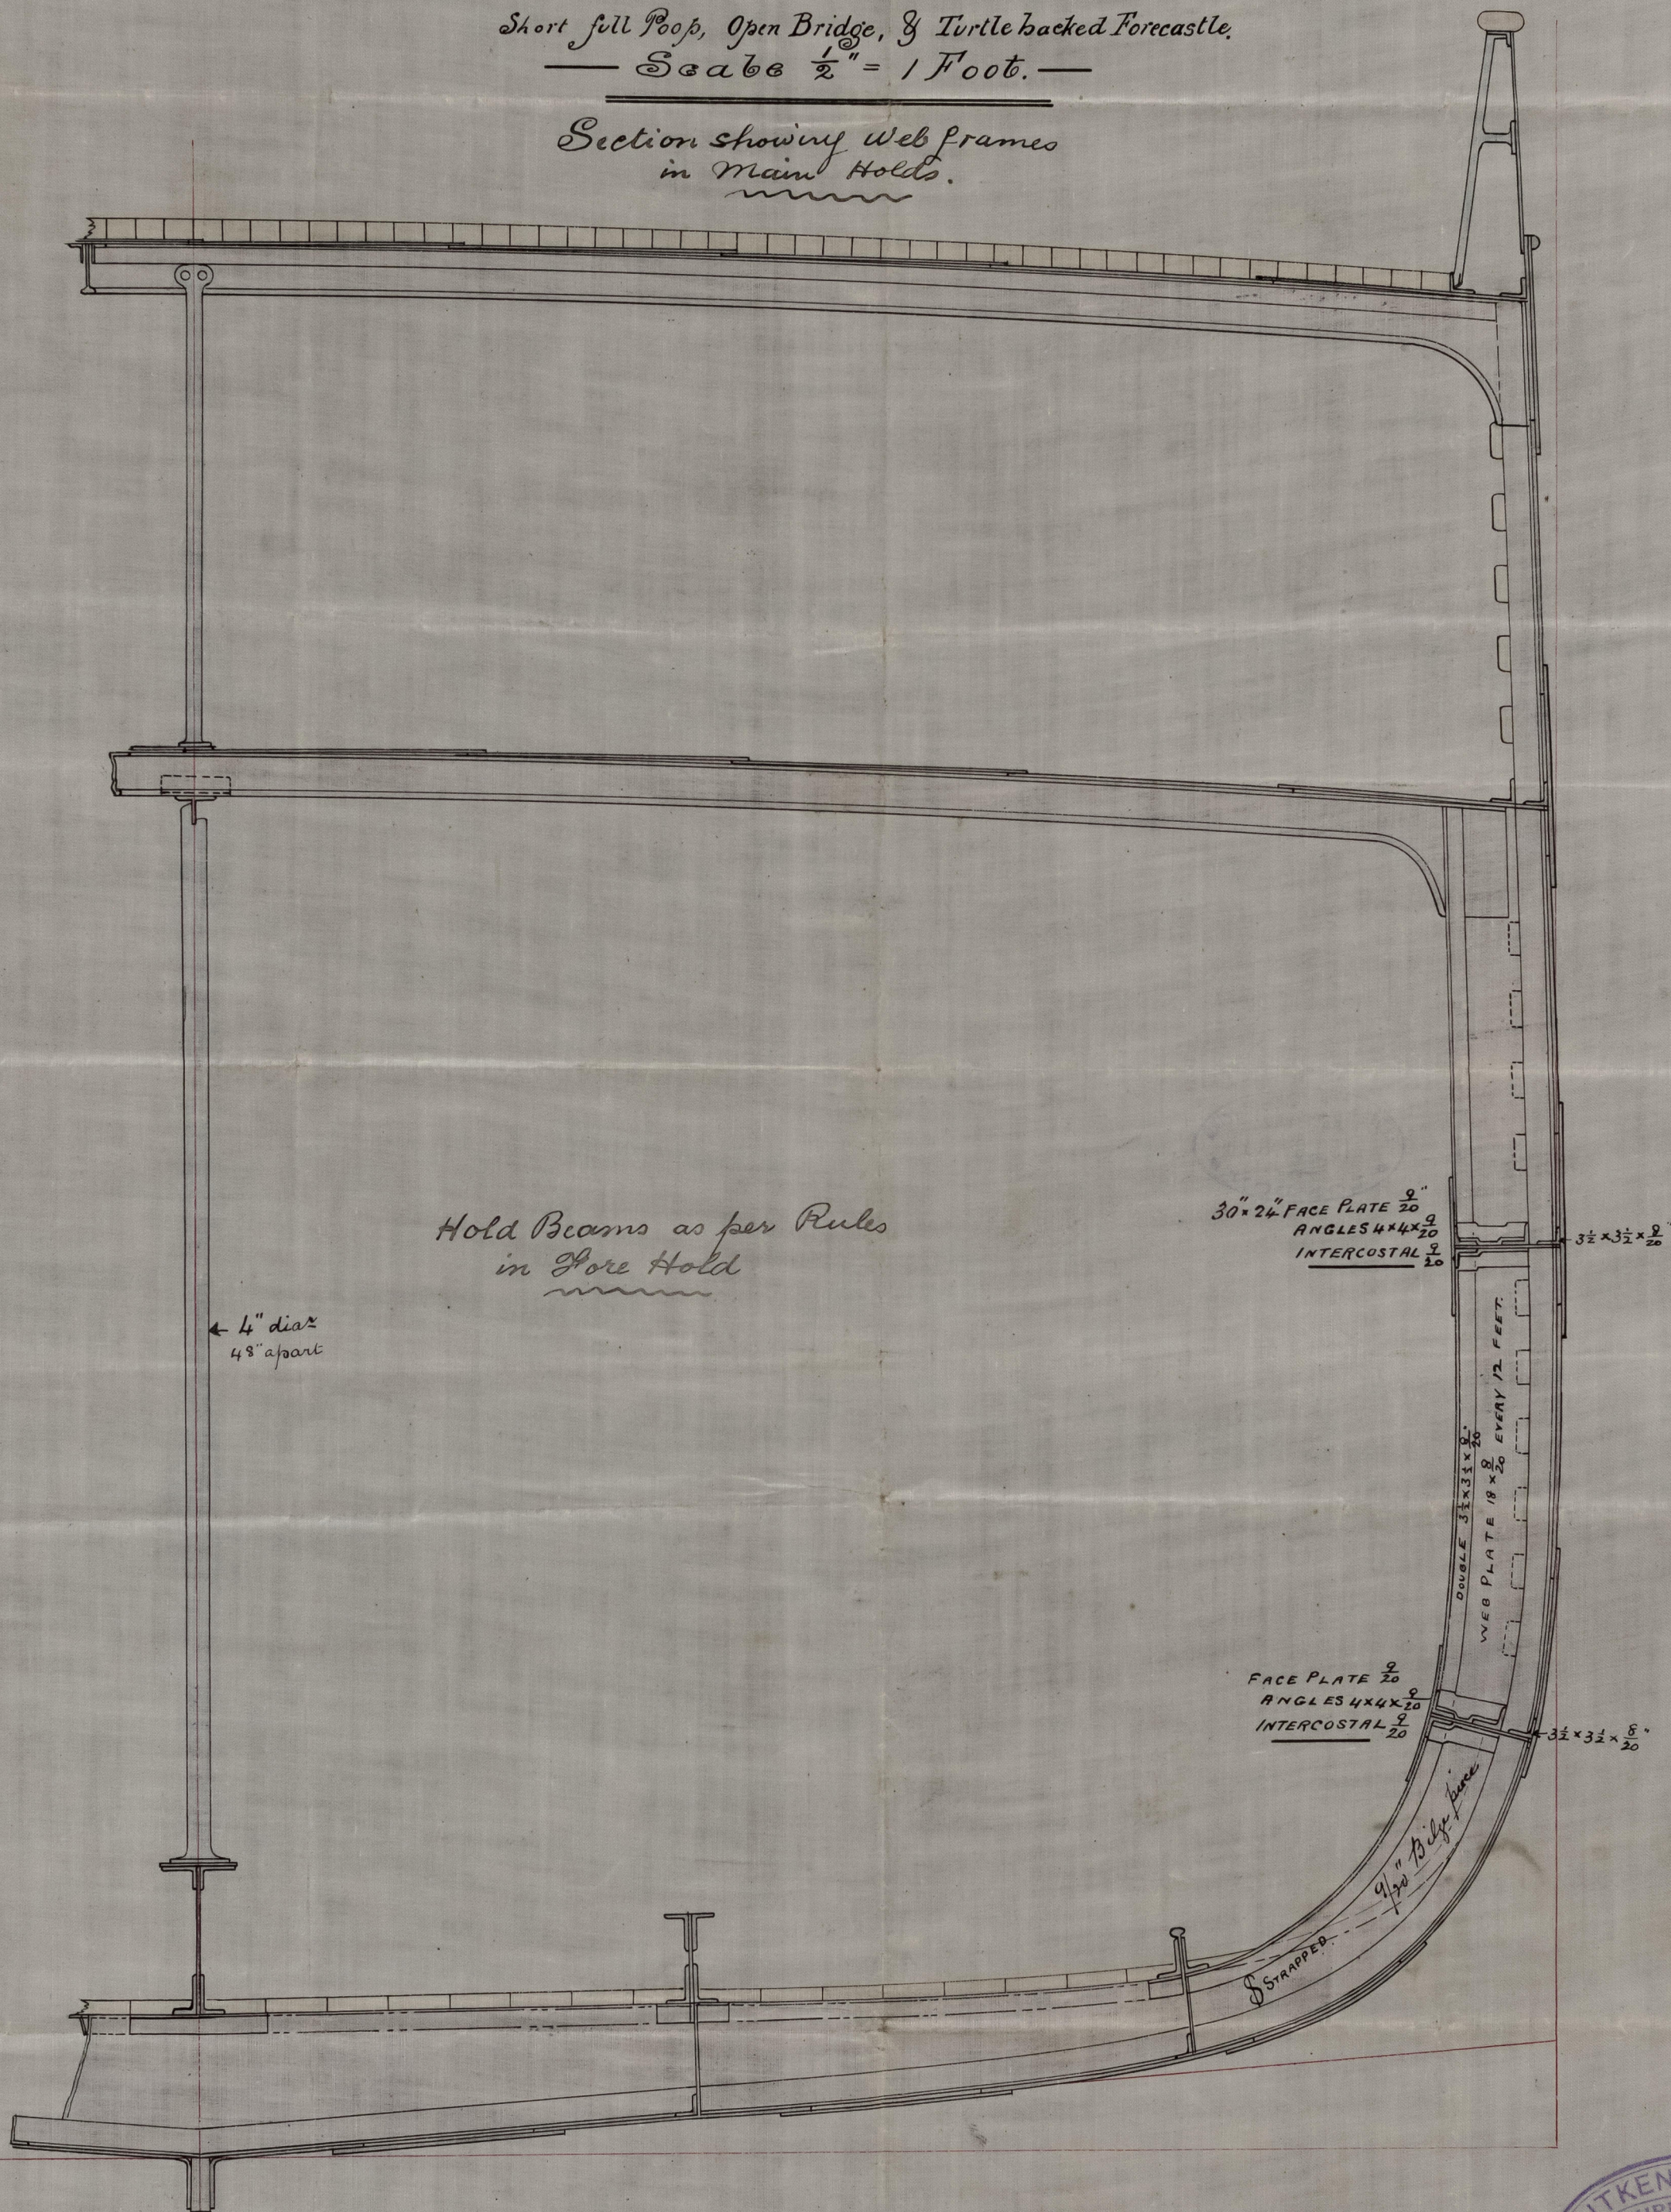

A.L.
187/1/86



Lloyd's Register
Foundation

415107-0166

