

13.11.86.
8.1.87.

S.S. No 134.


Longitudinal Elevation

S.S. 335' x 40' x 25' 9" Hold

Scale $\frac{1}{8}$ " = 1 Foot

S.S. "Moogul" Glasgow Report No. 8194. —

Amended Plan with
Web Frames in the Main Holds

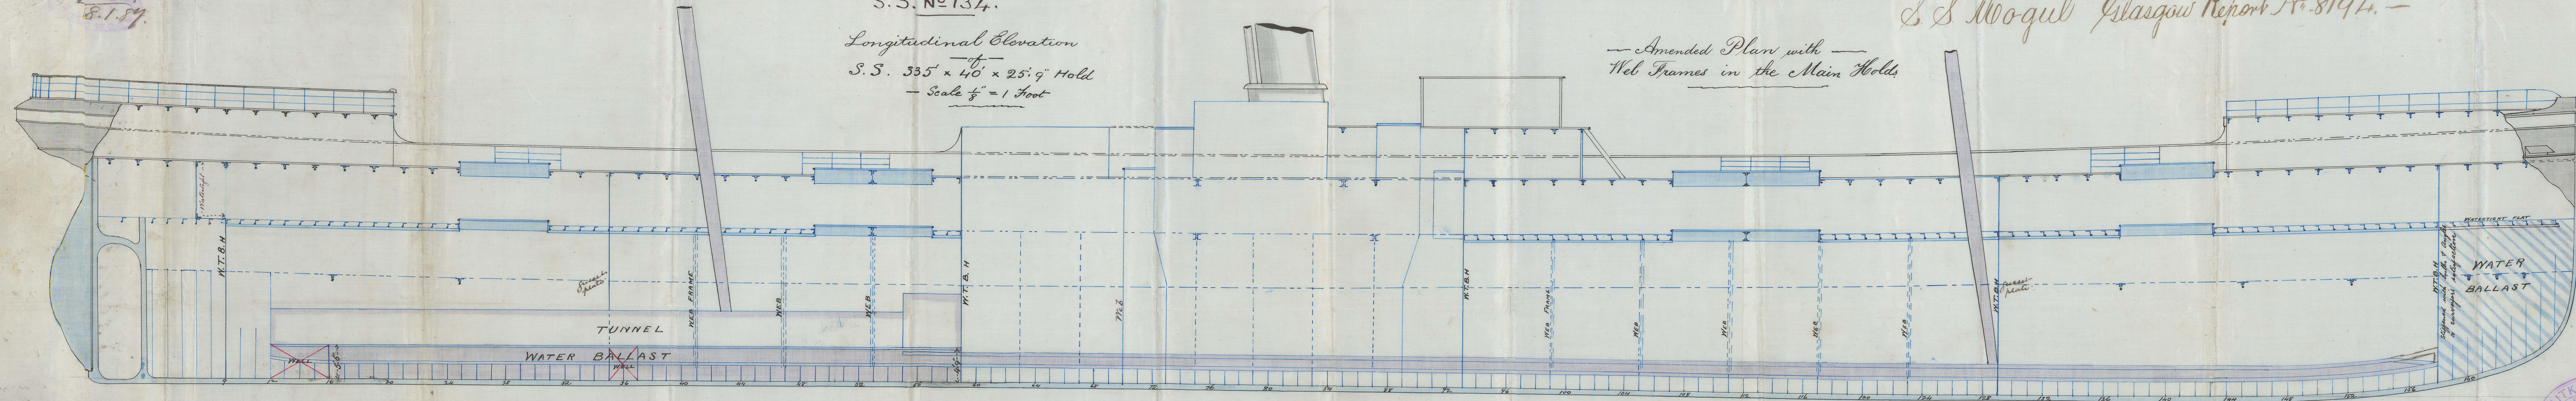

J.H.L.
18/11/86



Lloyd's Register
Foundation