


23.4.87

S.S. "Mogul" Glasgow Report No 8194.



Nº 134
 — S.S. "MOGUL" —
 — PLAN OF STEEL MASTS —
 — SCALE $\frac{1}{16}$ " = 1 FOOT. —

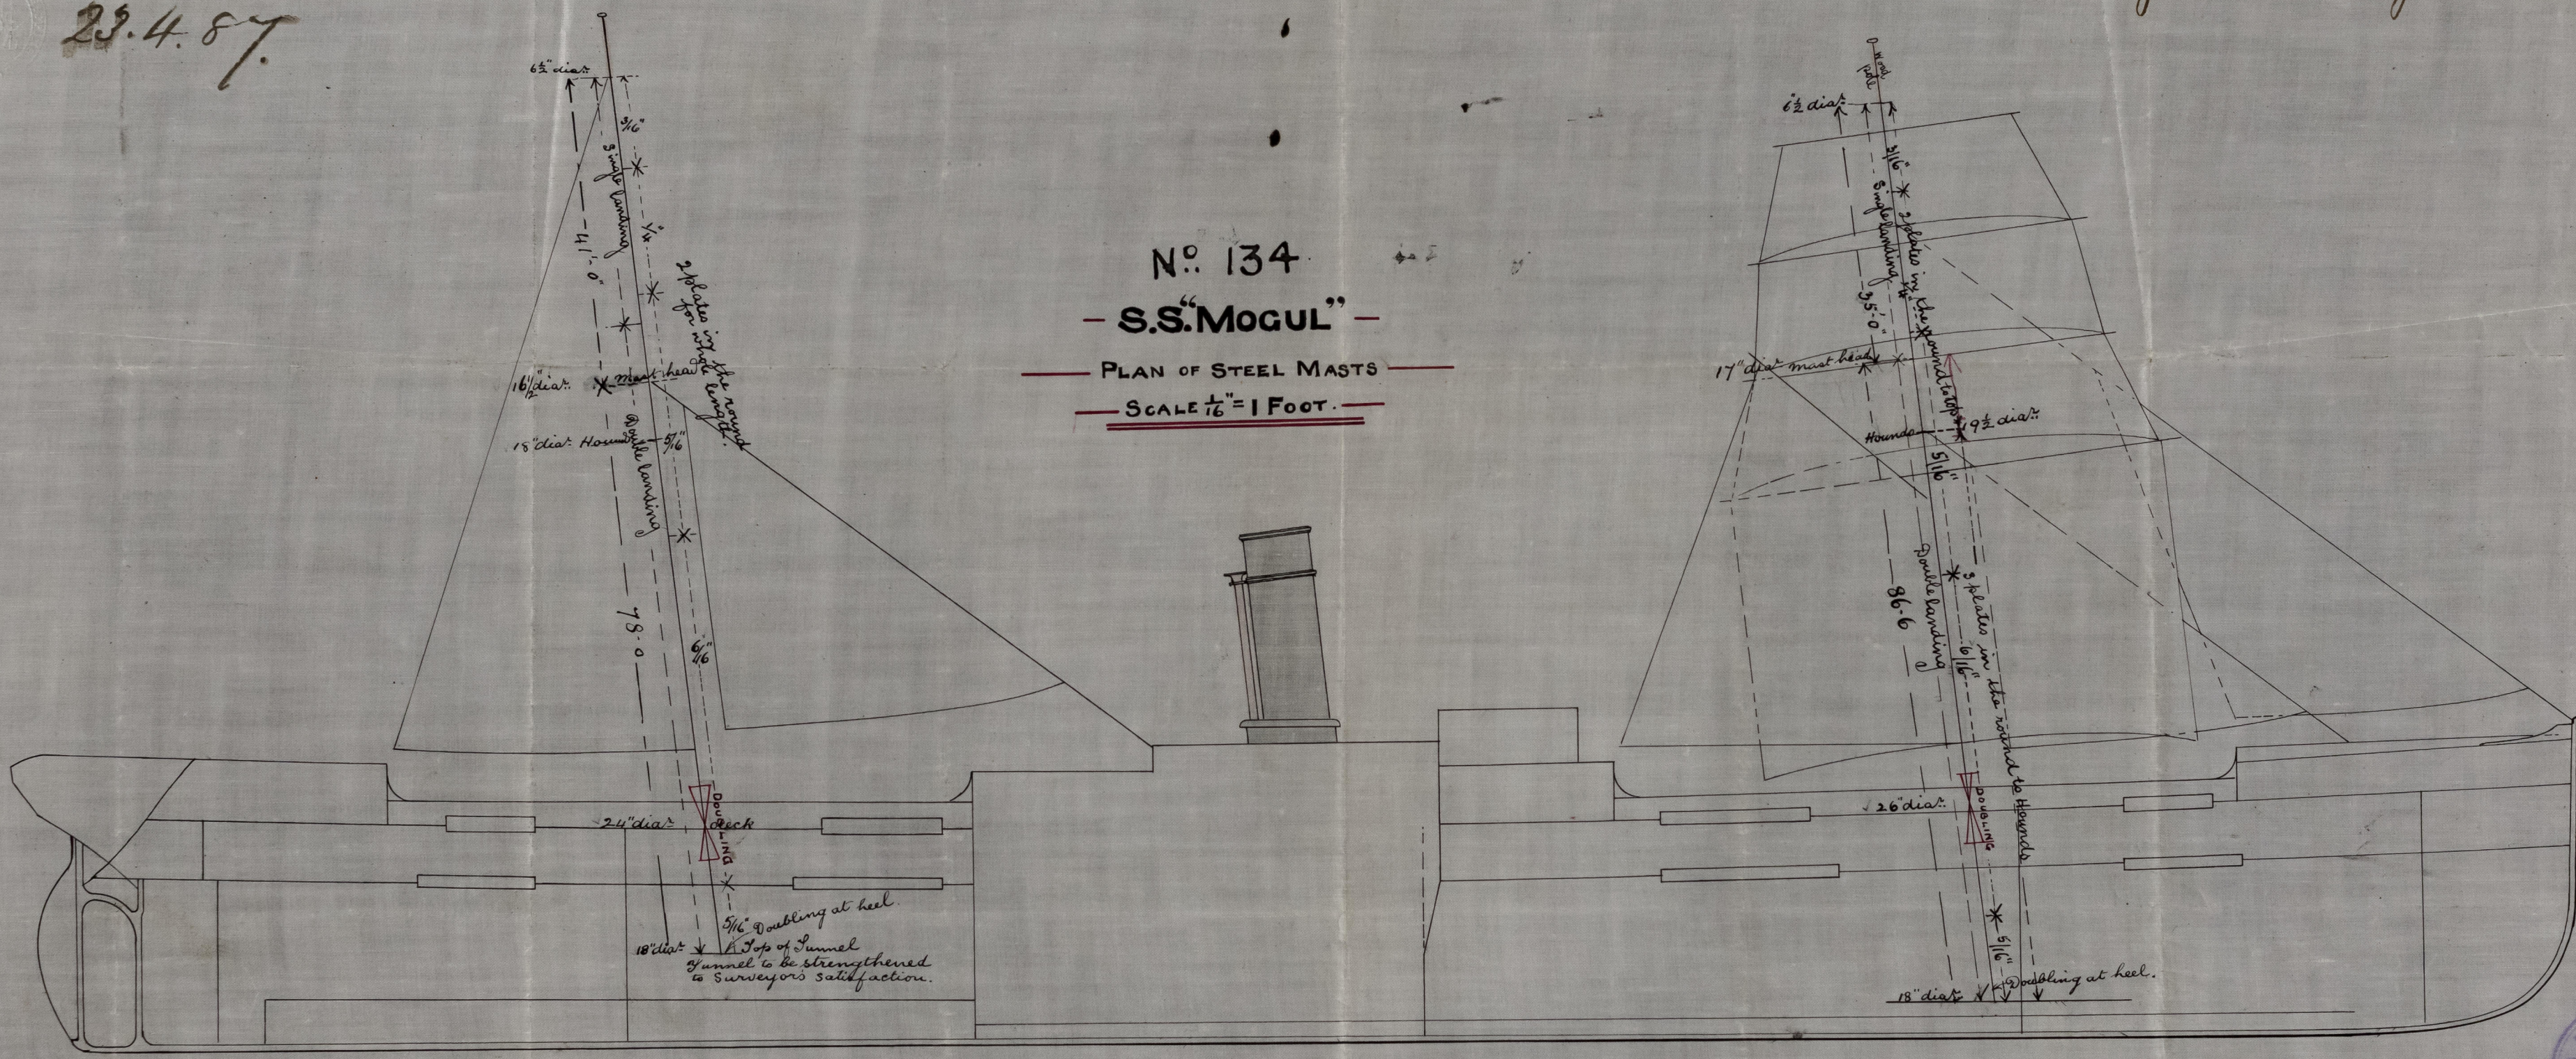

AITKEN & MANSEL
 SHIPBUILDERS
 20 APR. 87
 ENGINEERS
 GLASGOW

23/4/87

0710-602579

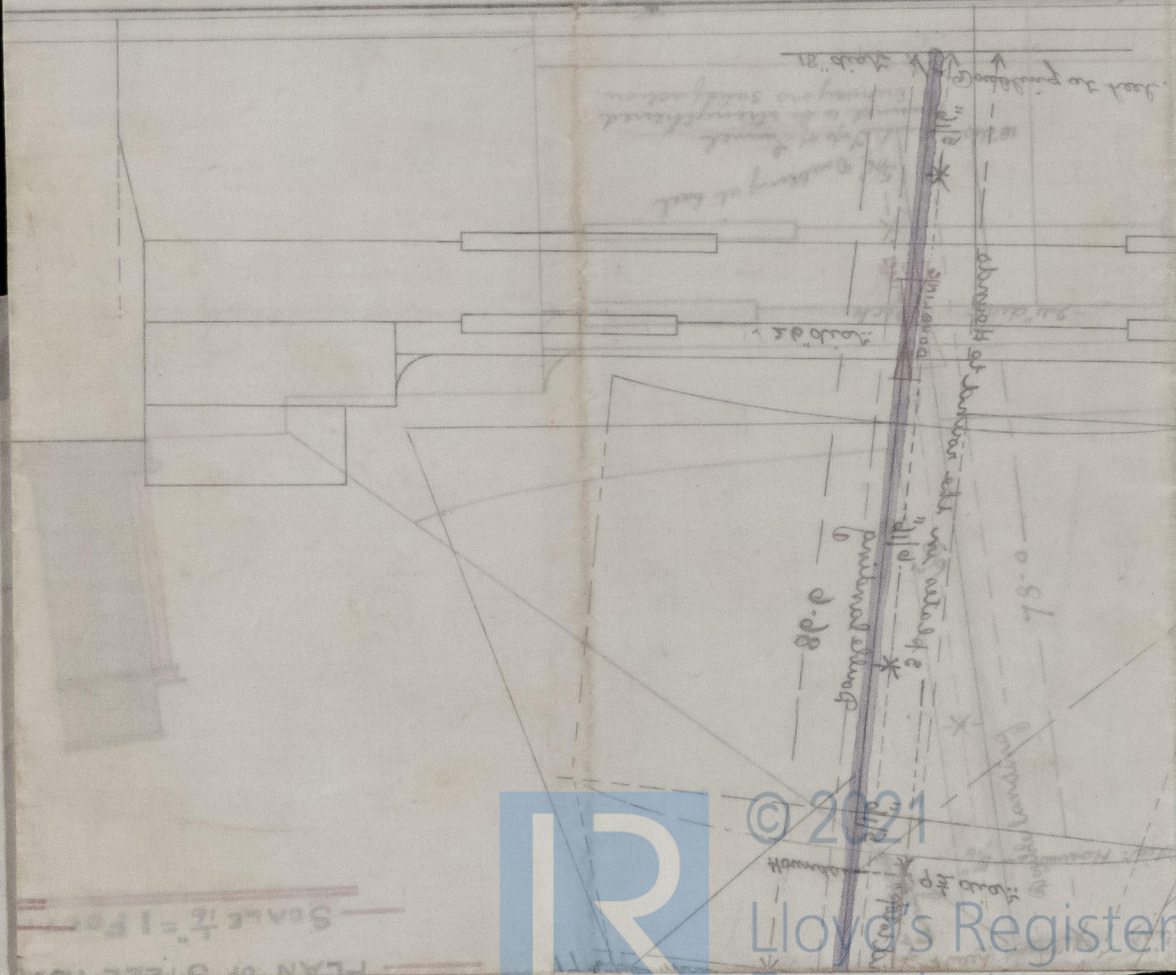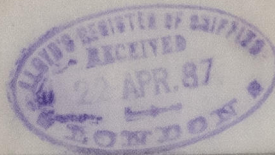

© 2021

Lloyd's Register
Foundation